


6/7/77

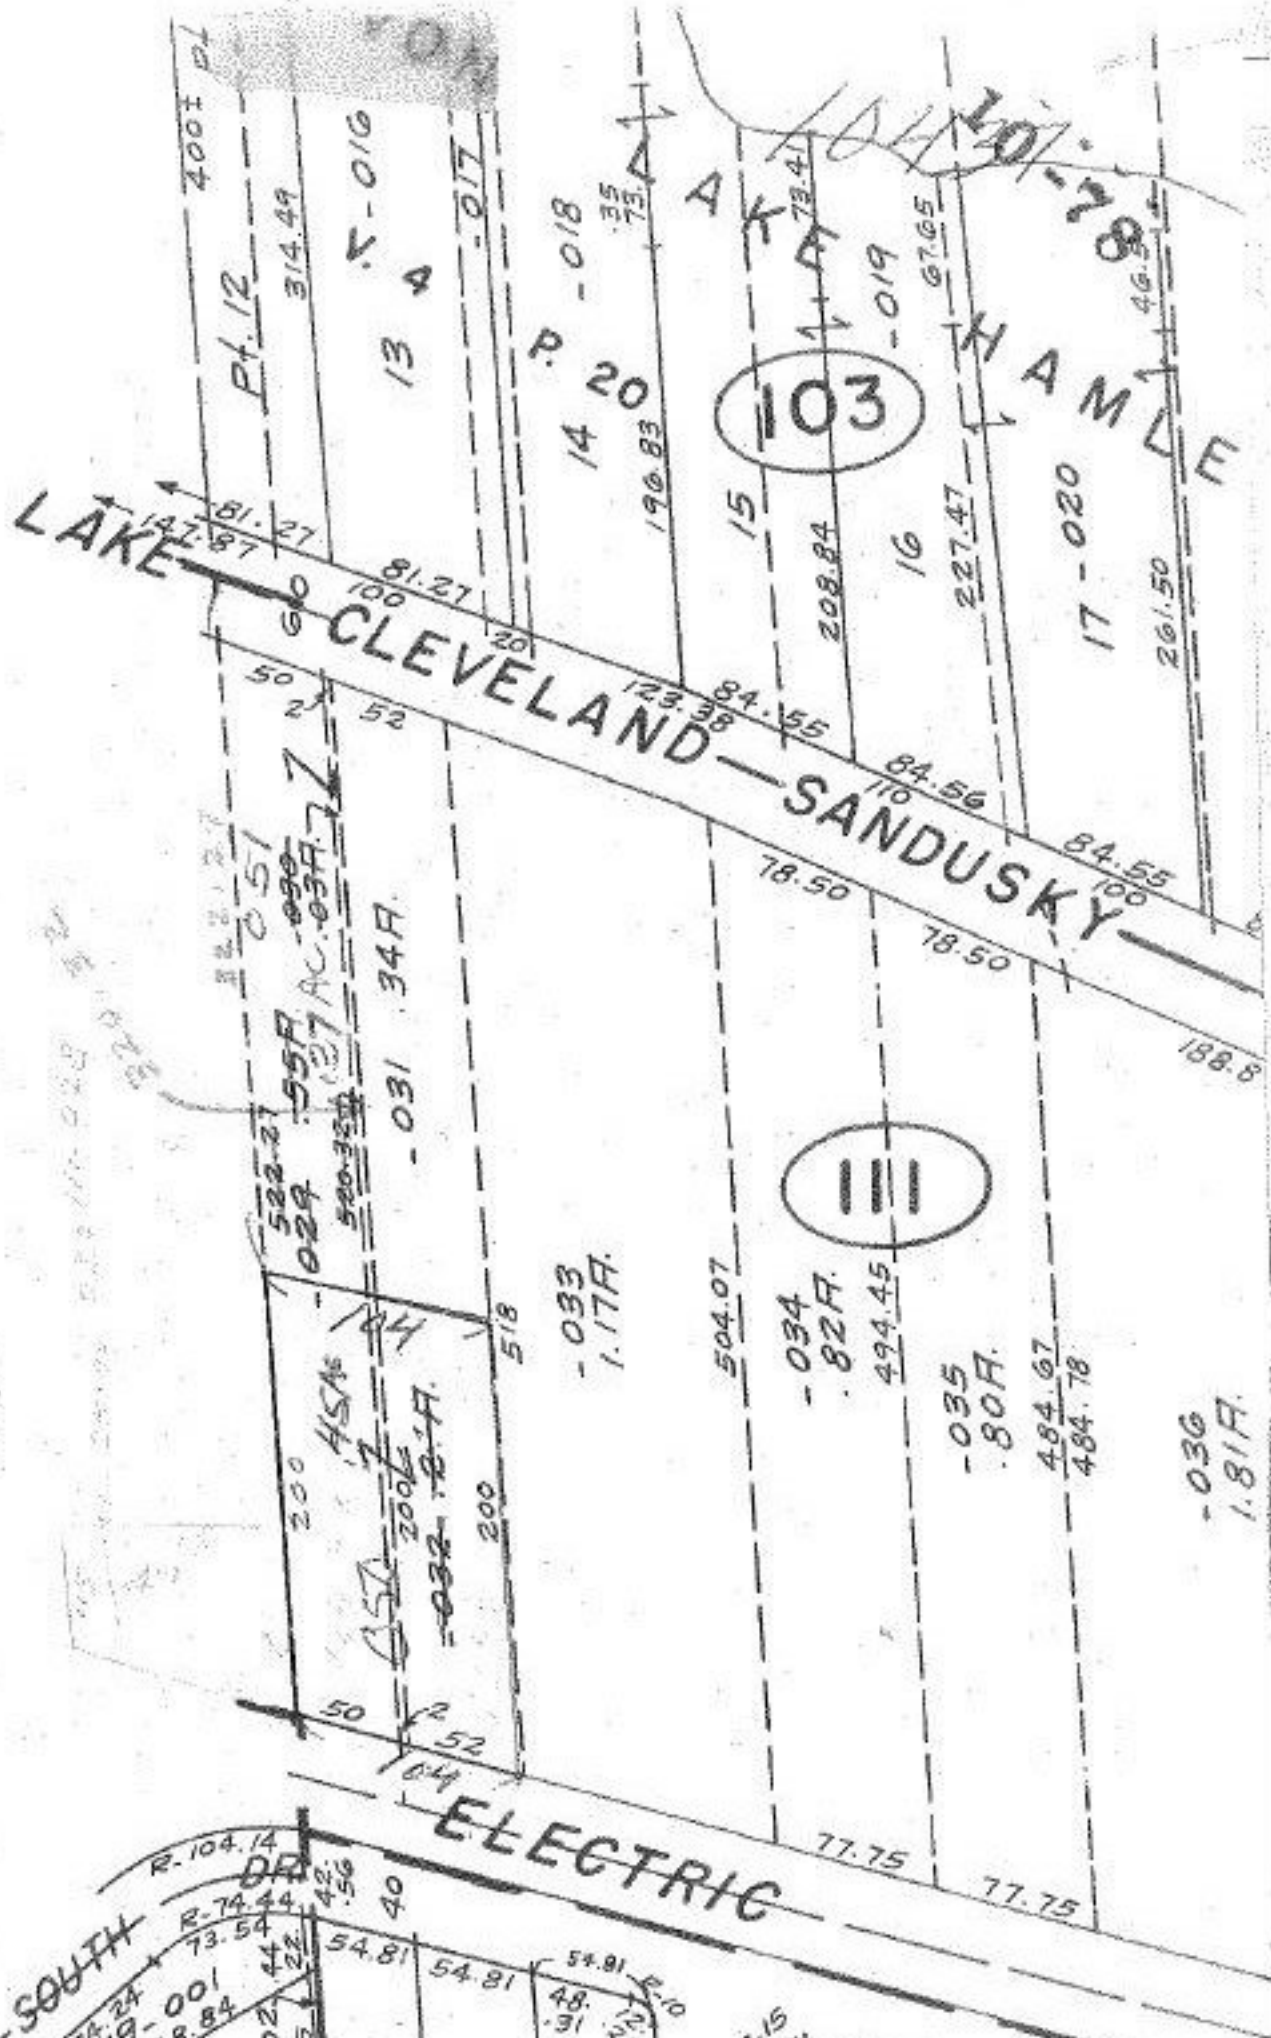

APR 29 1977

[Handwritten signature]

10437

APPROVED
LORAIN CO.
MAP DEPT.
DATE 4/14/77
PAGE 4-00-0303
BY <i>[Handwritten signature]</i>
VOID AFTER

APR 21 1977

