


10456
10-38
20-38
178-20
339-20
339

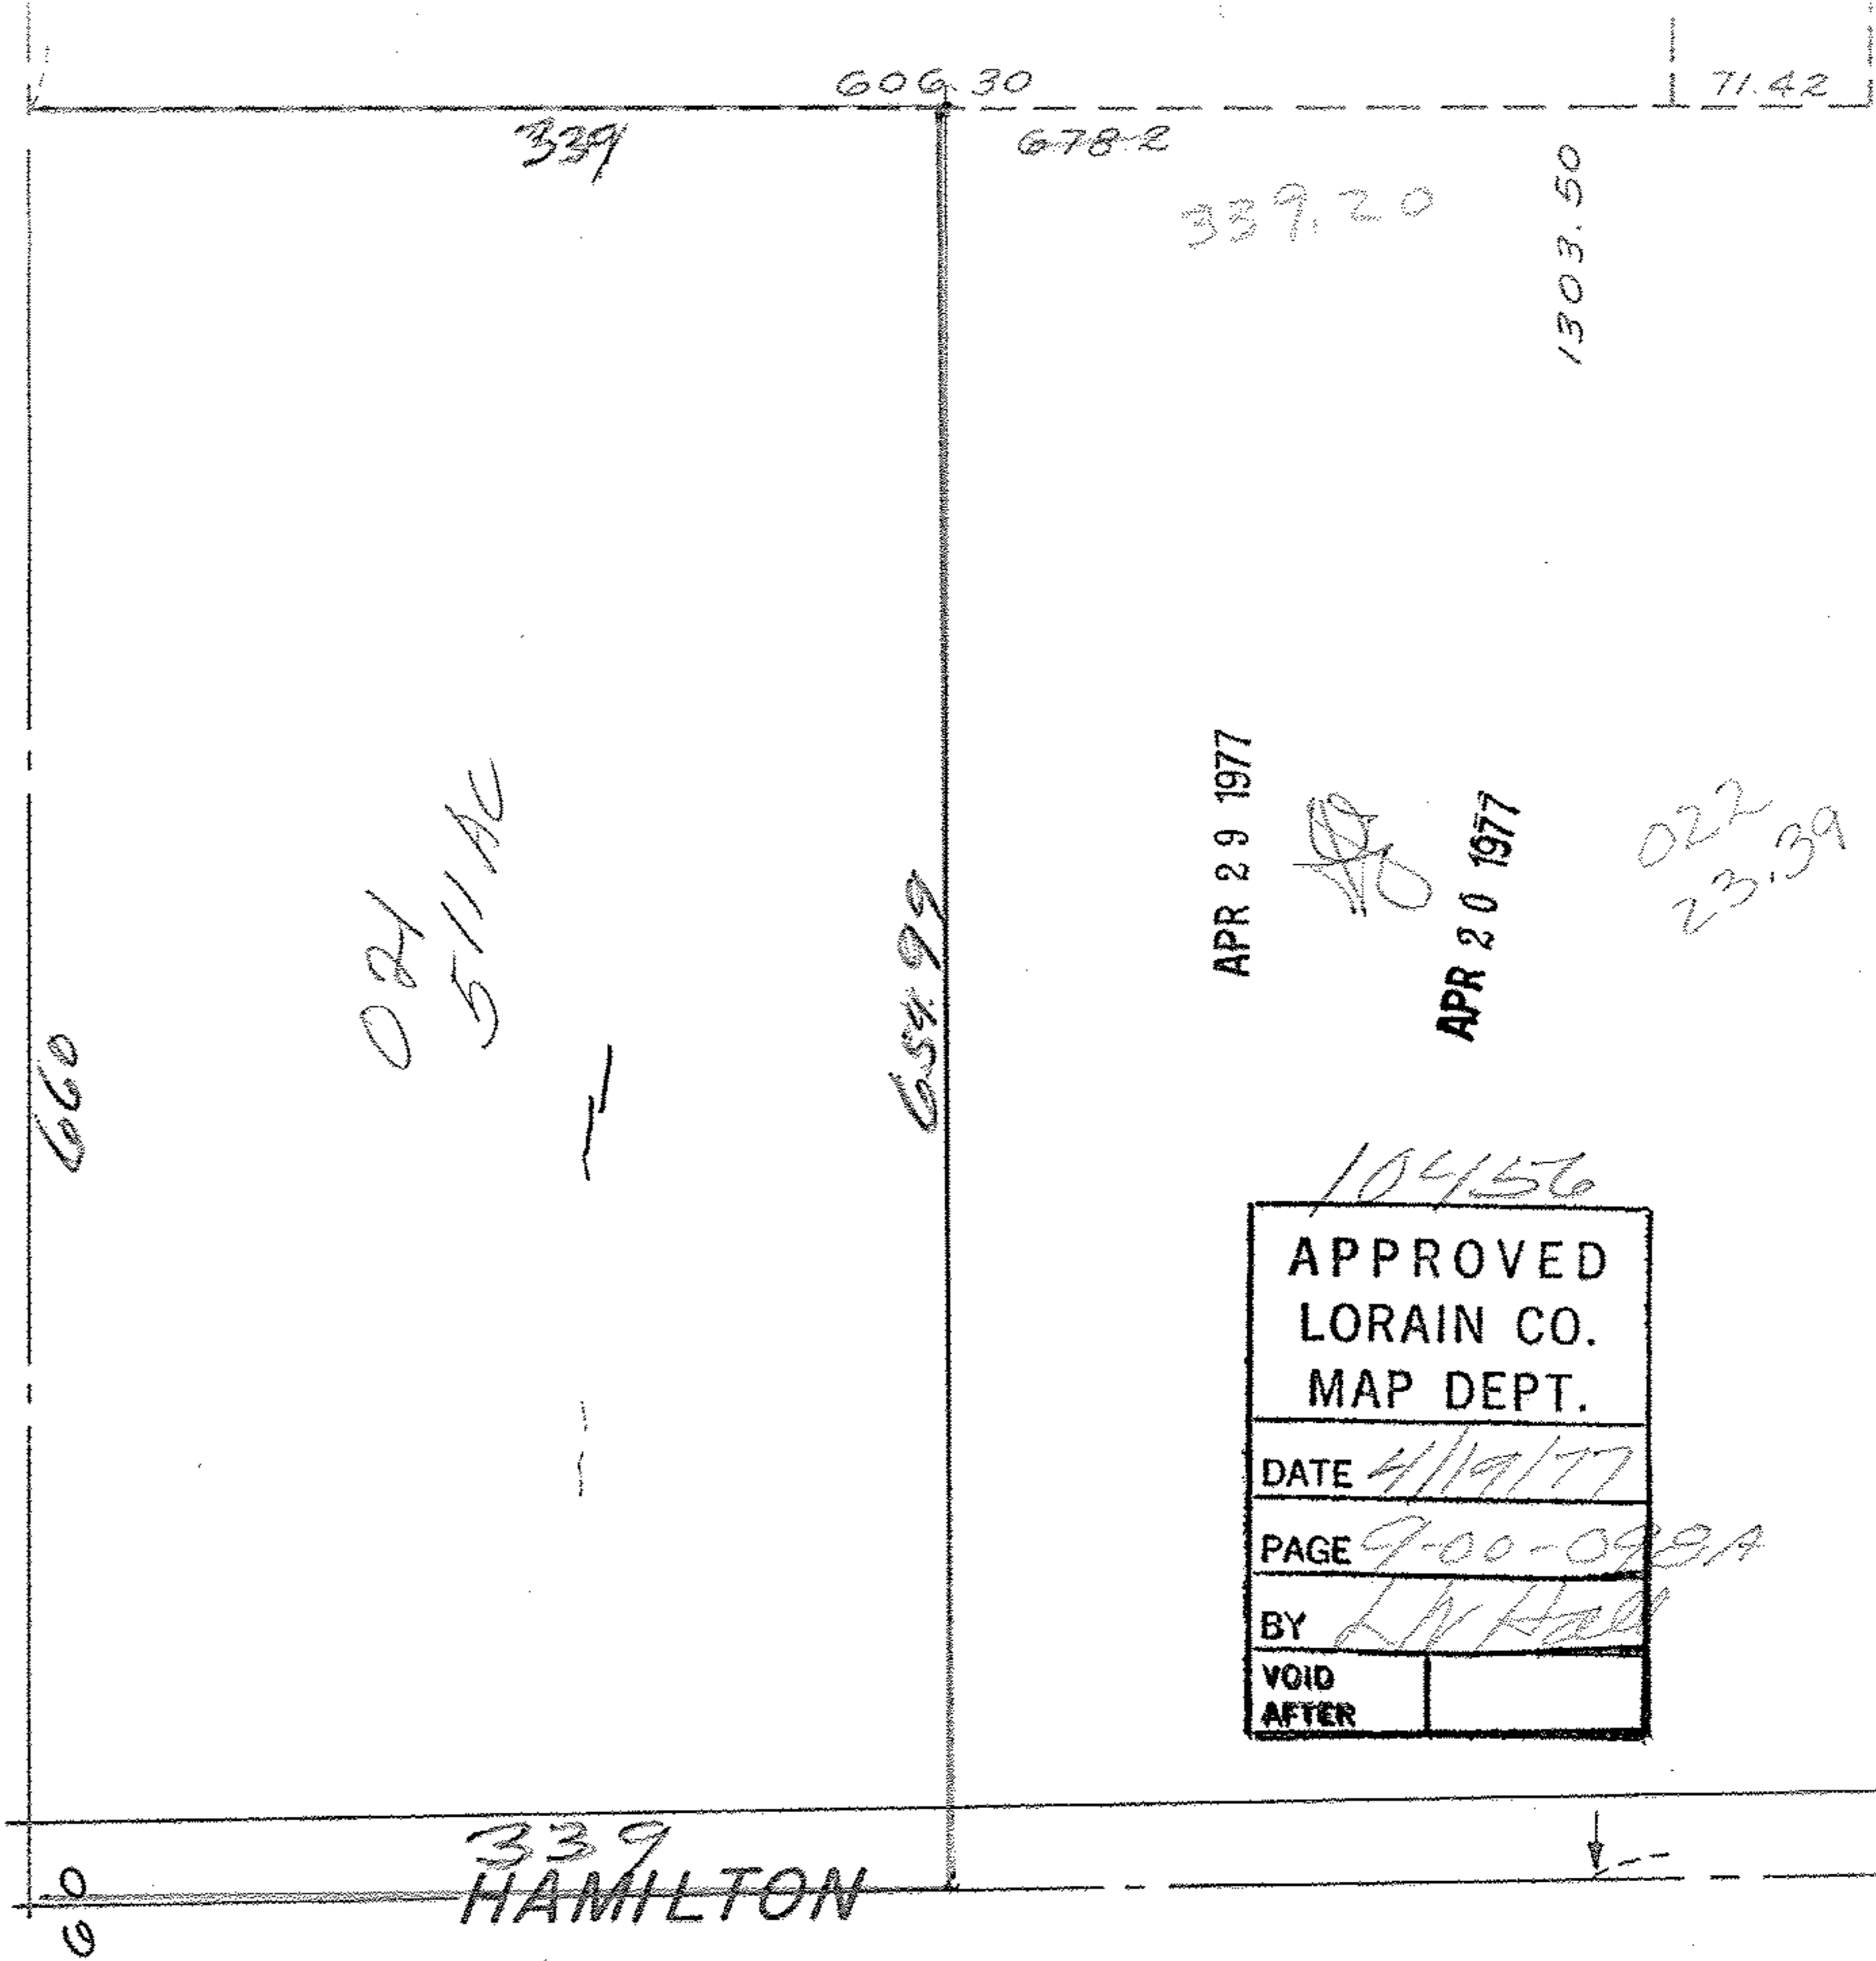

10456

APPROVED LORAIN CO. MAP DEPT.	
DATE	4/19/77
PAGE	9-00-098A
BY	L. V. Hall
VOID AFTER	

SEE 9-

Copyright 1963 by
Revised 12-1-75

9-00-098-A

RUSSIA TWP.
SCALE: 1" = 100'