


RICHELIEU

104005 AVE

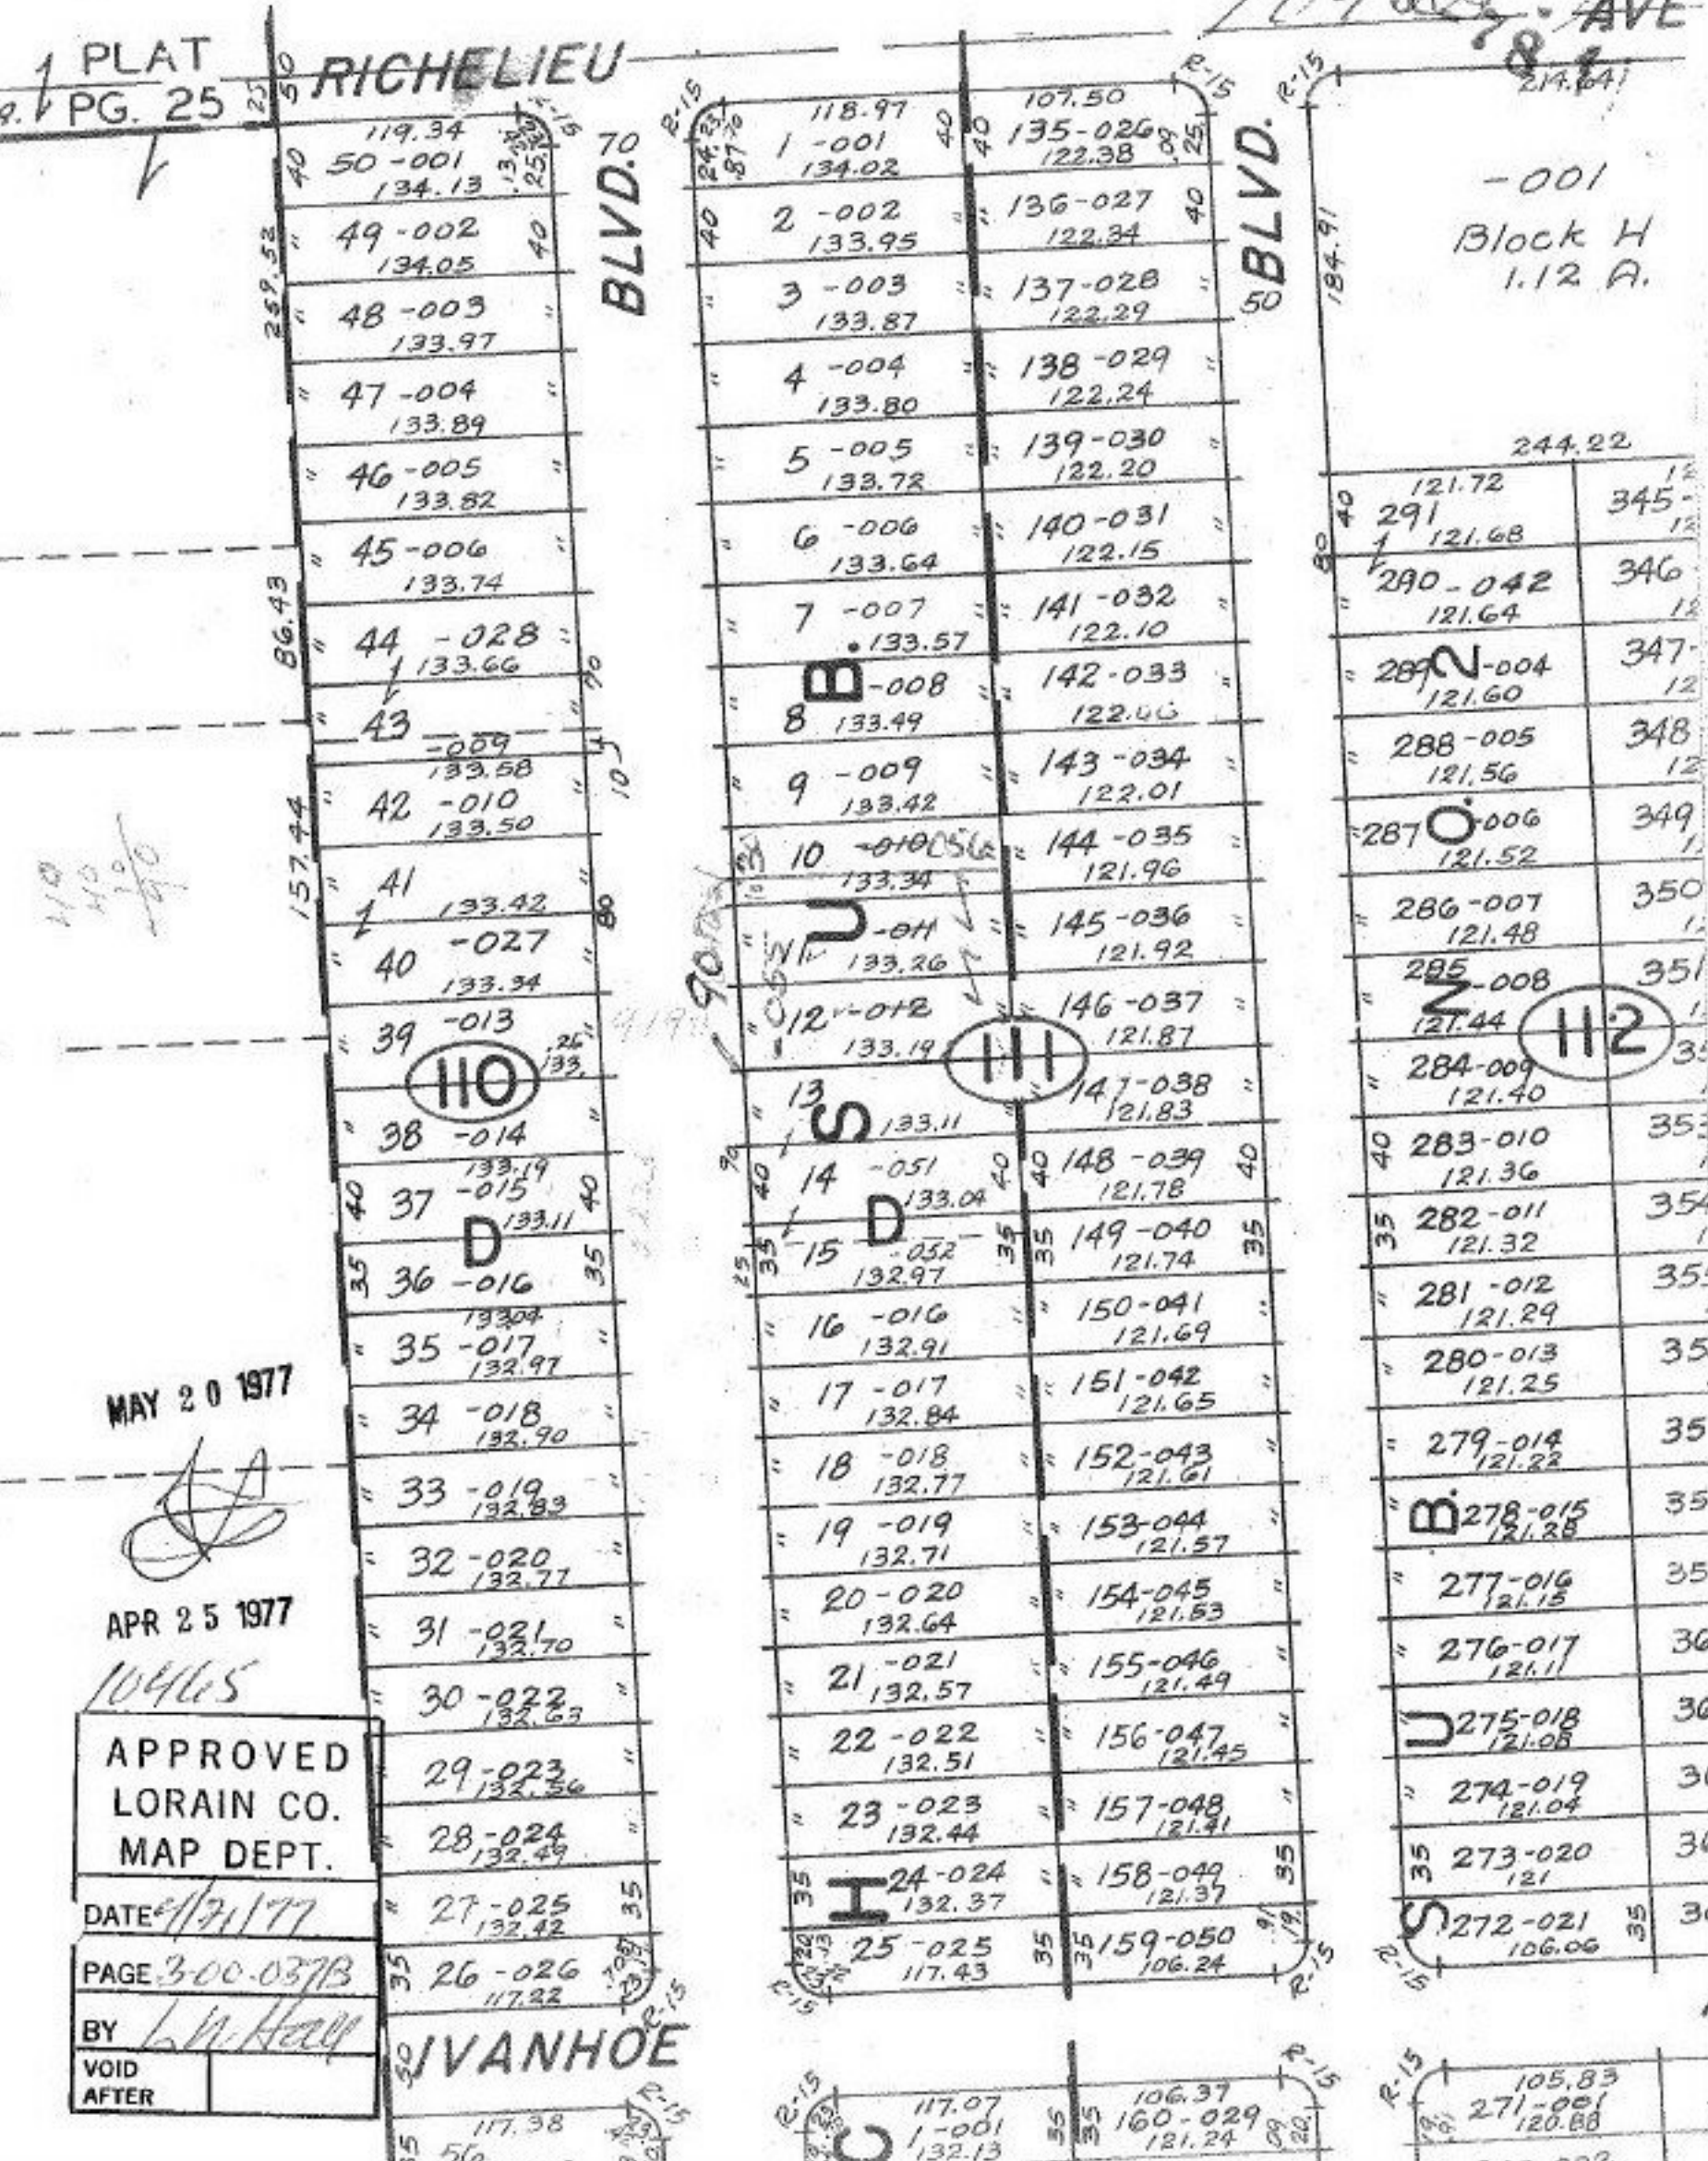

-001  
Block H  
1.12 A.

244.22

112

MAY 20 1977

APR 25 1977

APPROVED  
LORAIN CO.  
MAP DEPT.

DATE 4/21/77

PAGE 3-00-037B

BY L. N. Hall

VOID  
AFTER

JUVANHOE

105.83  
271-001  
120.88  
270-002