


10479
10-28-10479

APR 26 1977

SEE 7-B

APPROVED
LORAIN CO.
MAP DEPT.
DATE 4/26/77
PAGE 7-00-03412
BY L.W. HEDGECOCK
VOID AFTER

479
479
10479

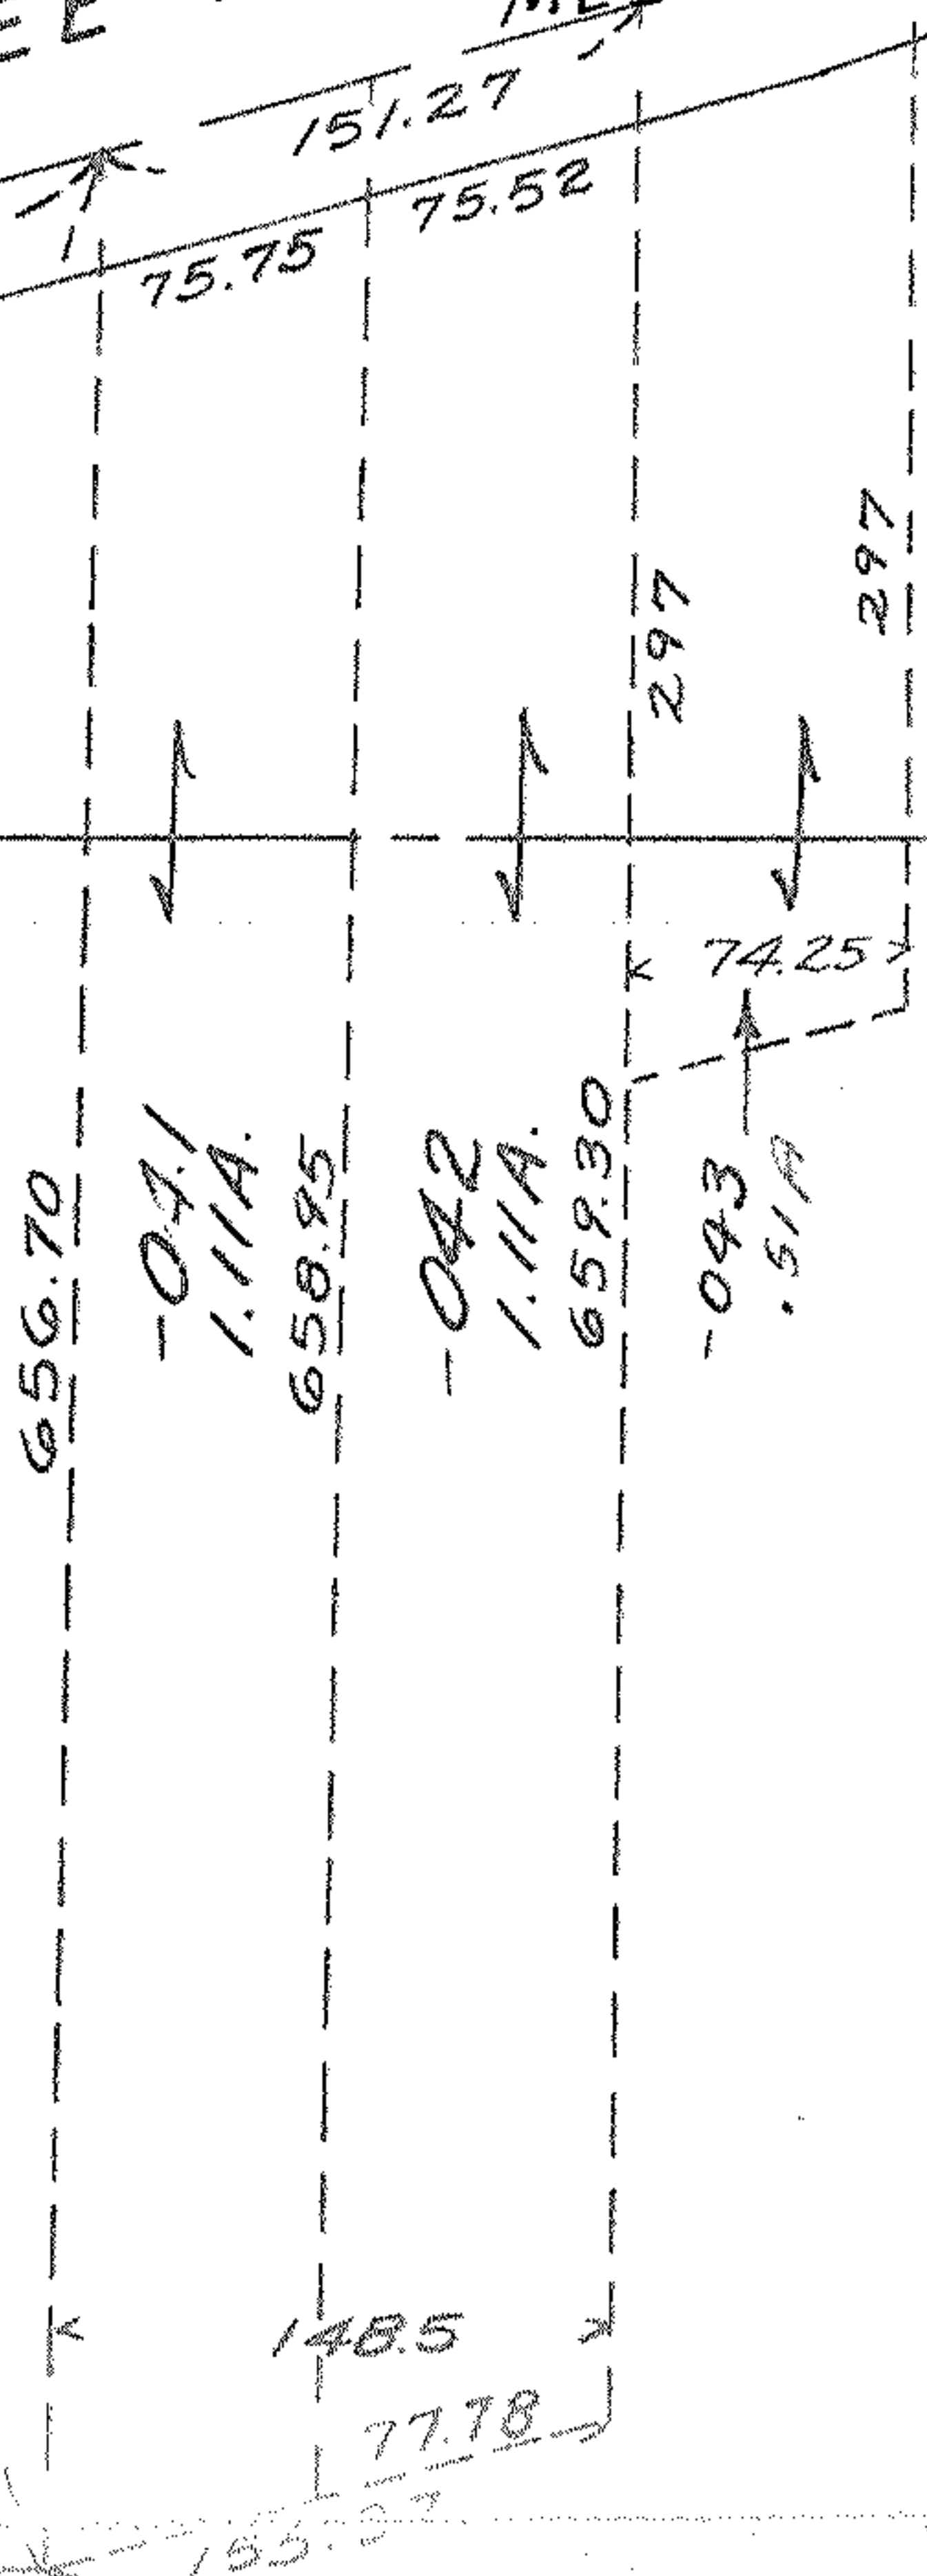

Calculates 1.11 AC
1.11 AC

Delete

Pt. -078
Pt. 14.55A
-100
13.88 AC


10473
and
10479

34

APPROVED
LORAIN CO.
MAP DEPT.
DATE 4/26/77
PAGE 7-00-03412
BY L.W. HEDGECOCK
VOID AFTER

AUG. 11, 1977 J.B.

473
10479

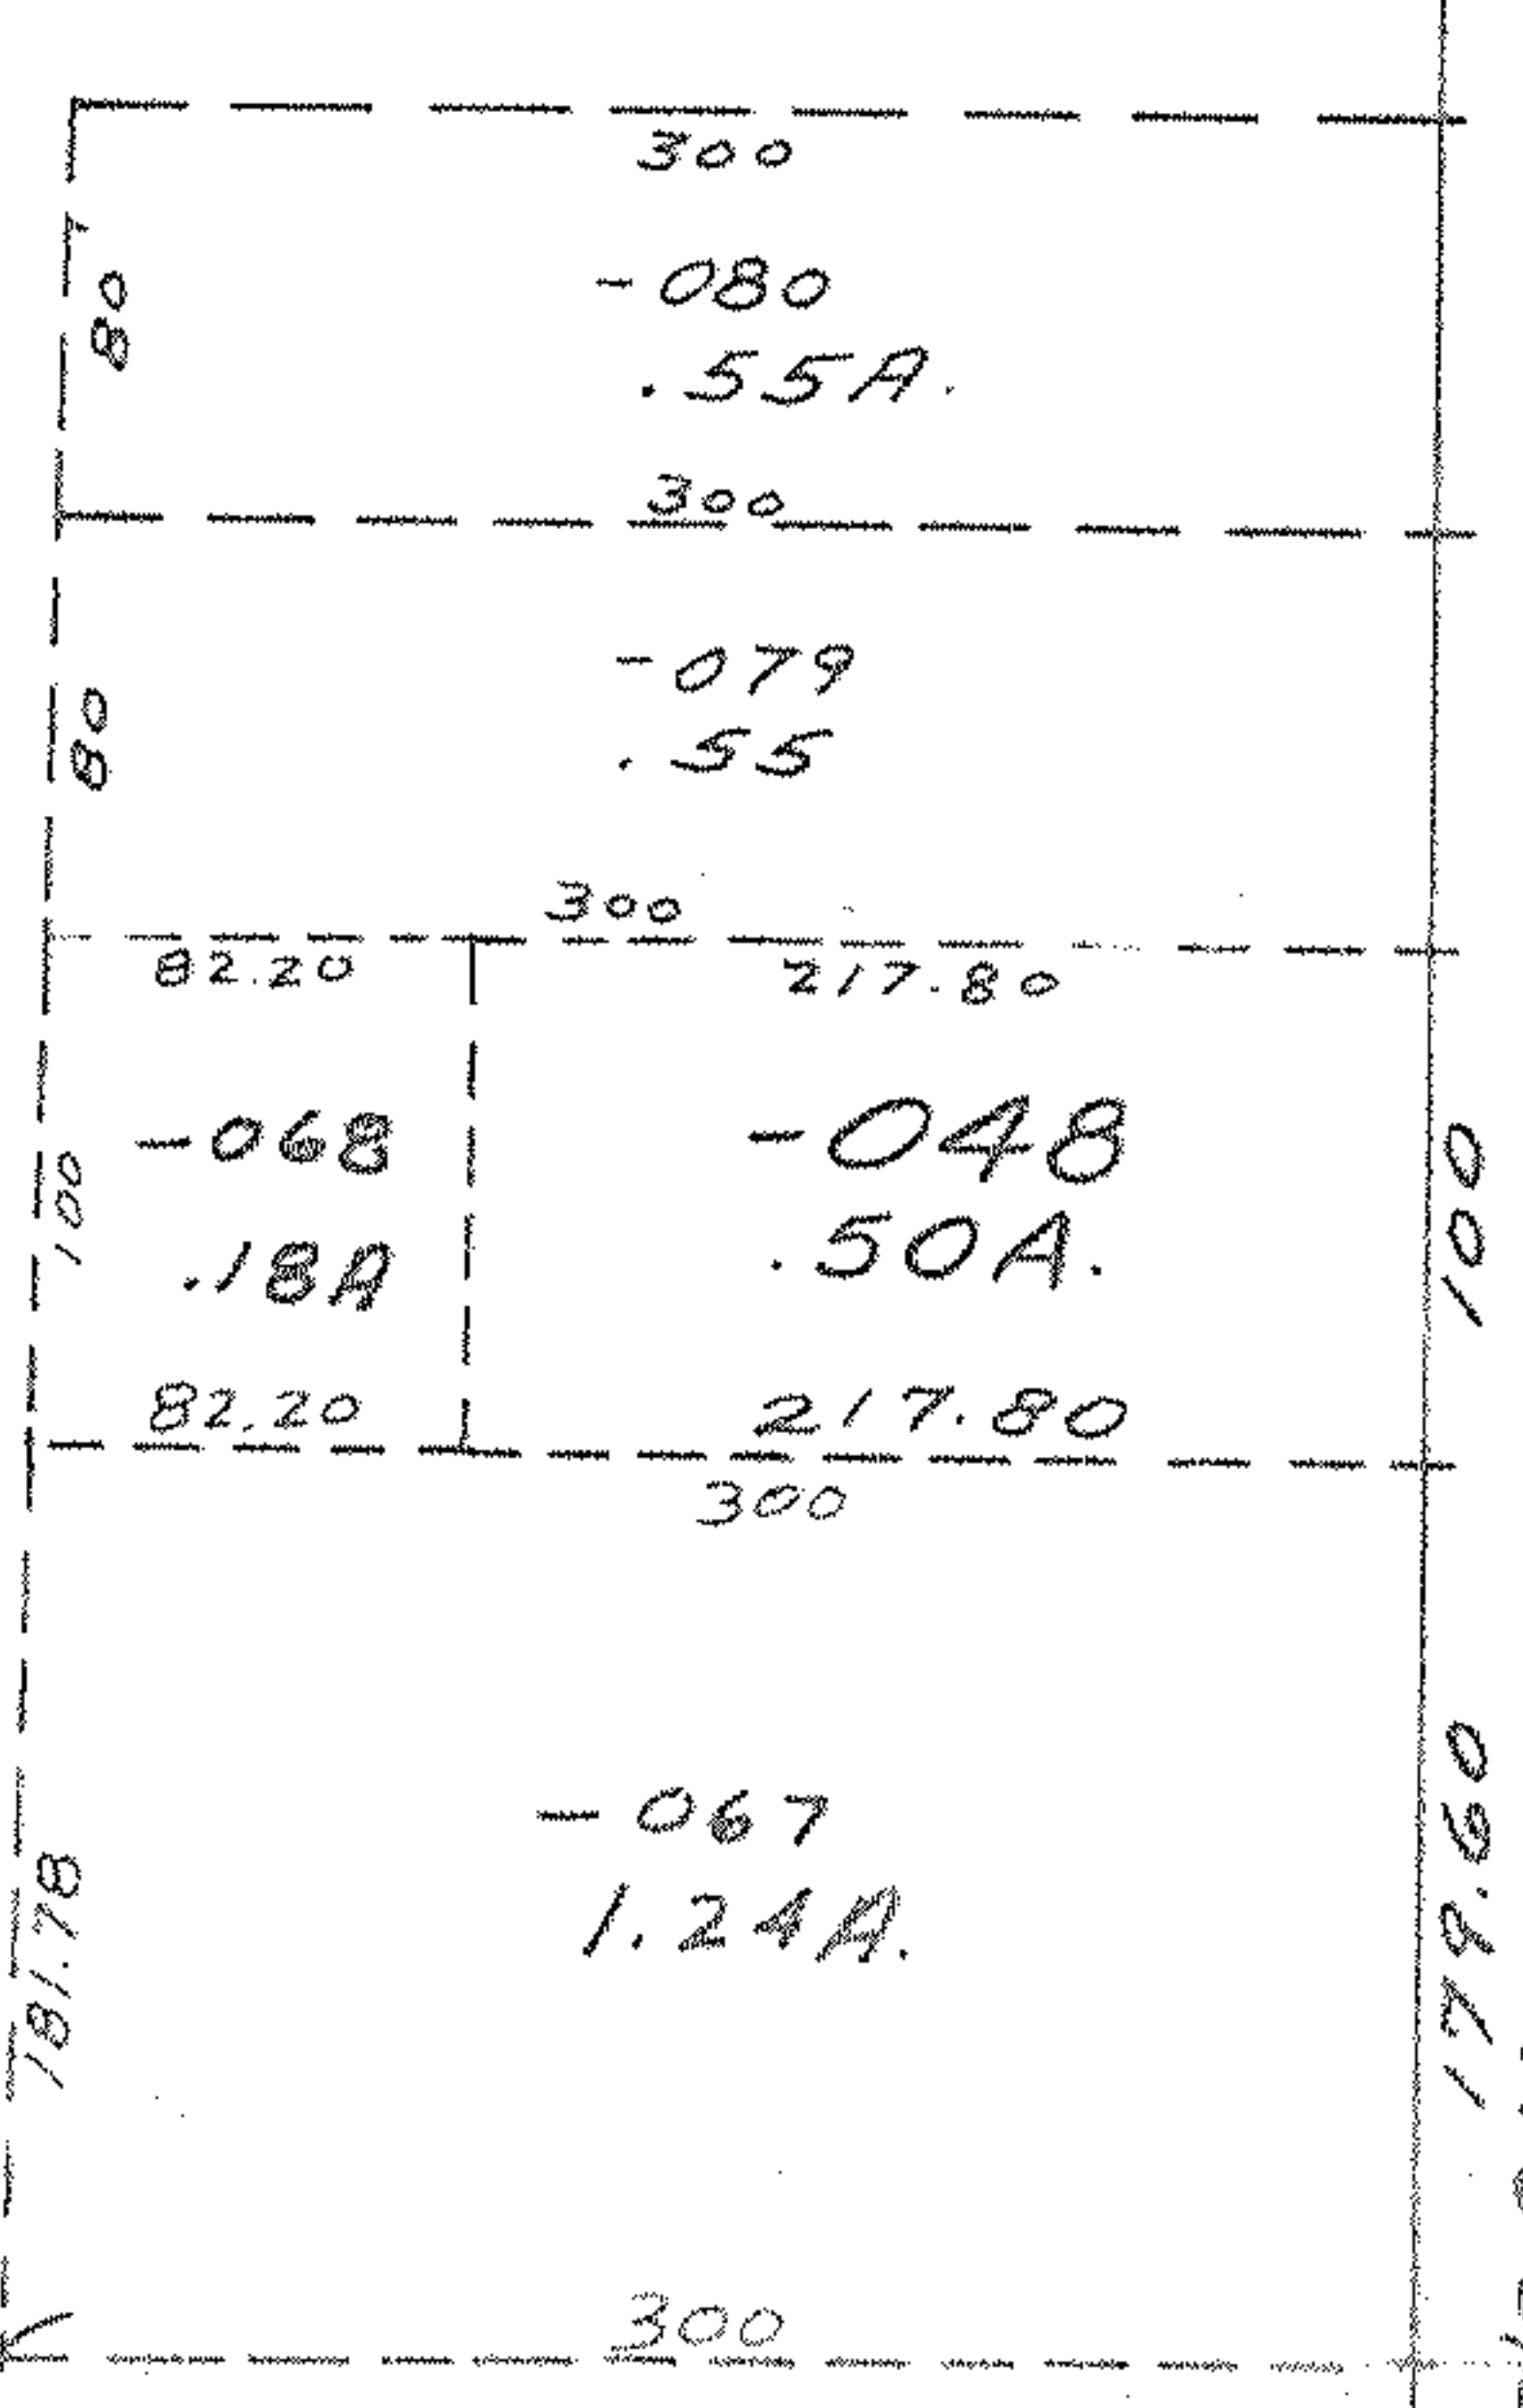

10479

SEE 7-00-027-A

DBOCK

RD. 0

RD. 0

