


10-78

10514

SEE 3-00-03

SEE 3-00-034-B

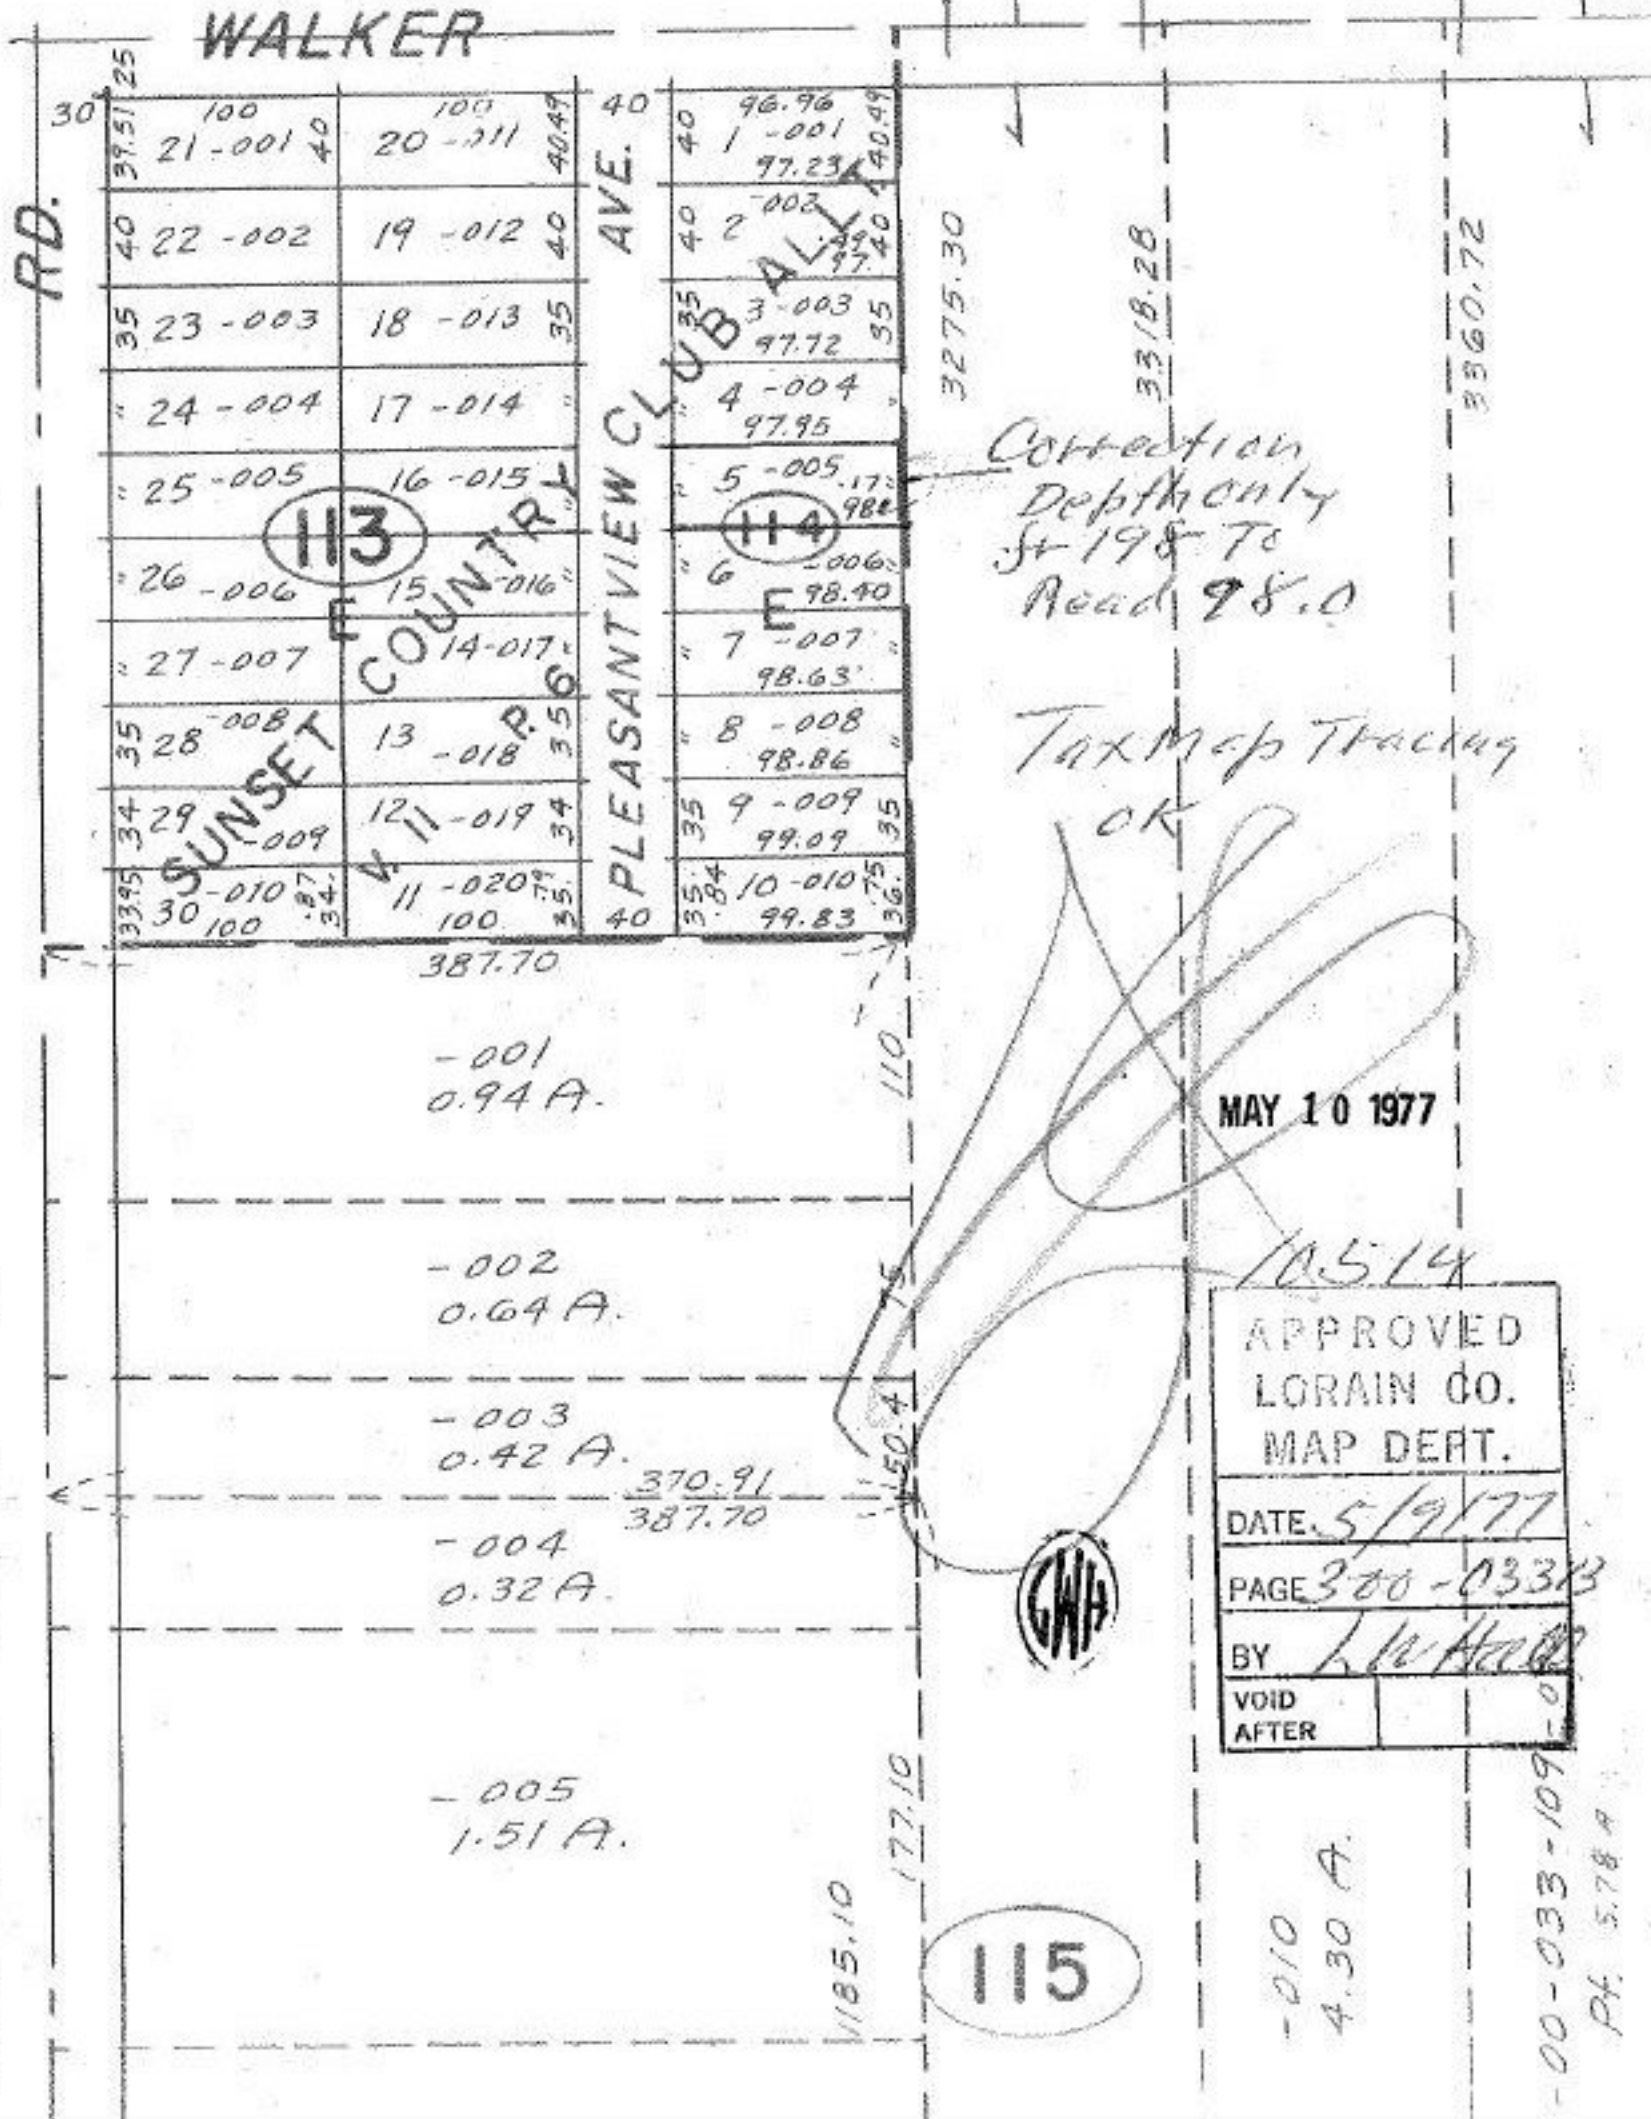

Correction  
Depth only  
St 198 To  
Road 98.0

Tax Map Tracking  
OK

MAY 10 1977

10514

APPROVED  
LORAIN CO.  
MAP DEPT.

DATE 5/9/77

PAGE 300-03313

BY L. W. HARRIS

VOID AFTER

115

-010  
4.30 A.

3-00-033-109-0  
Pt. 5.78 A.