


SEE 17-D

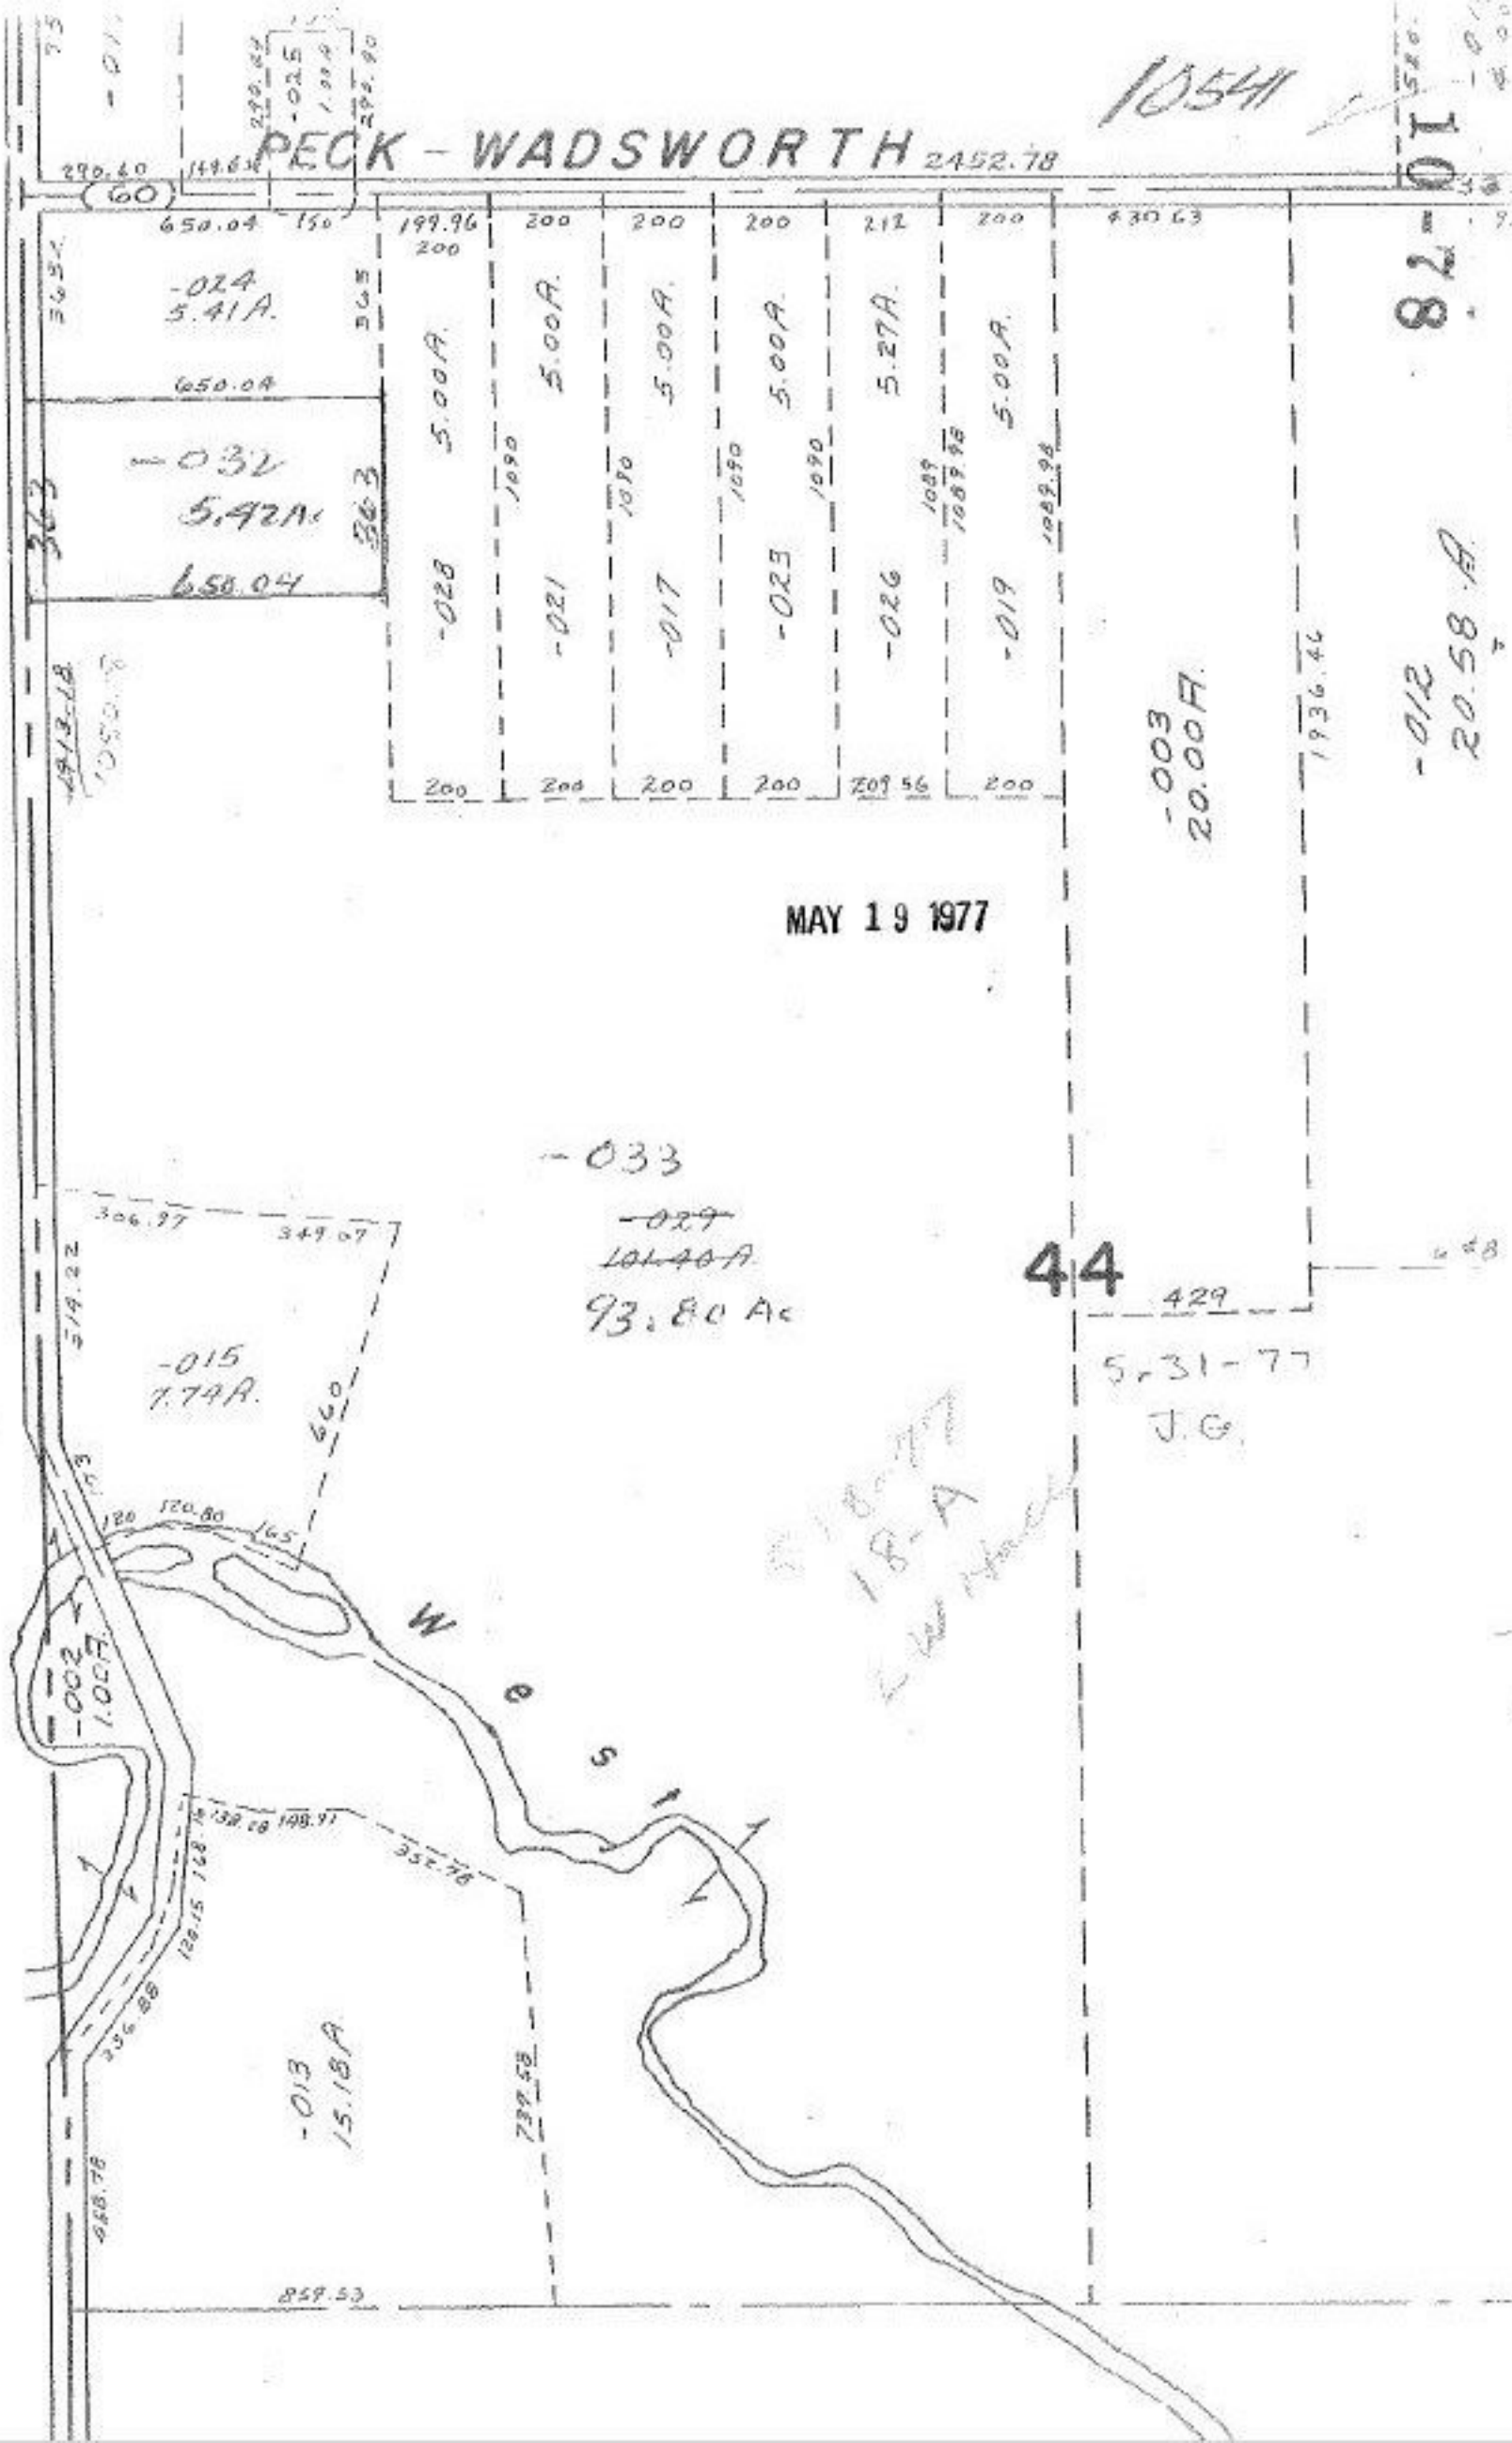

PECK - WADSWORTH 2452.78

MAY 19 1977

10541

82-01

-012
20.58 A

44

5-31-77
J.G.

290.40
149.61
290.40
-011
-025
1.99A
292.90

-024
5.41A

-032
5.42A

-028
5.00A

-021
5.00A

-017
5.00A

-023
5.00A

-026
5.27A

-019
5.00A

-003
20.00A

-033

-029
101.40A
93.80 Ac

-015
7.74A

-013
15.18A

-002
1.007

650.04 150 199.96 200 200 200 212 200 430.63

363 363

650.04

650.04

