


105.00A.

12.00

10543

10-28-00
13.00

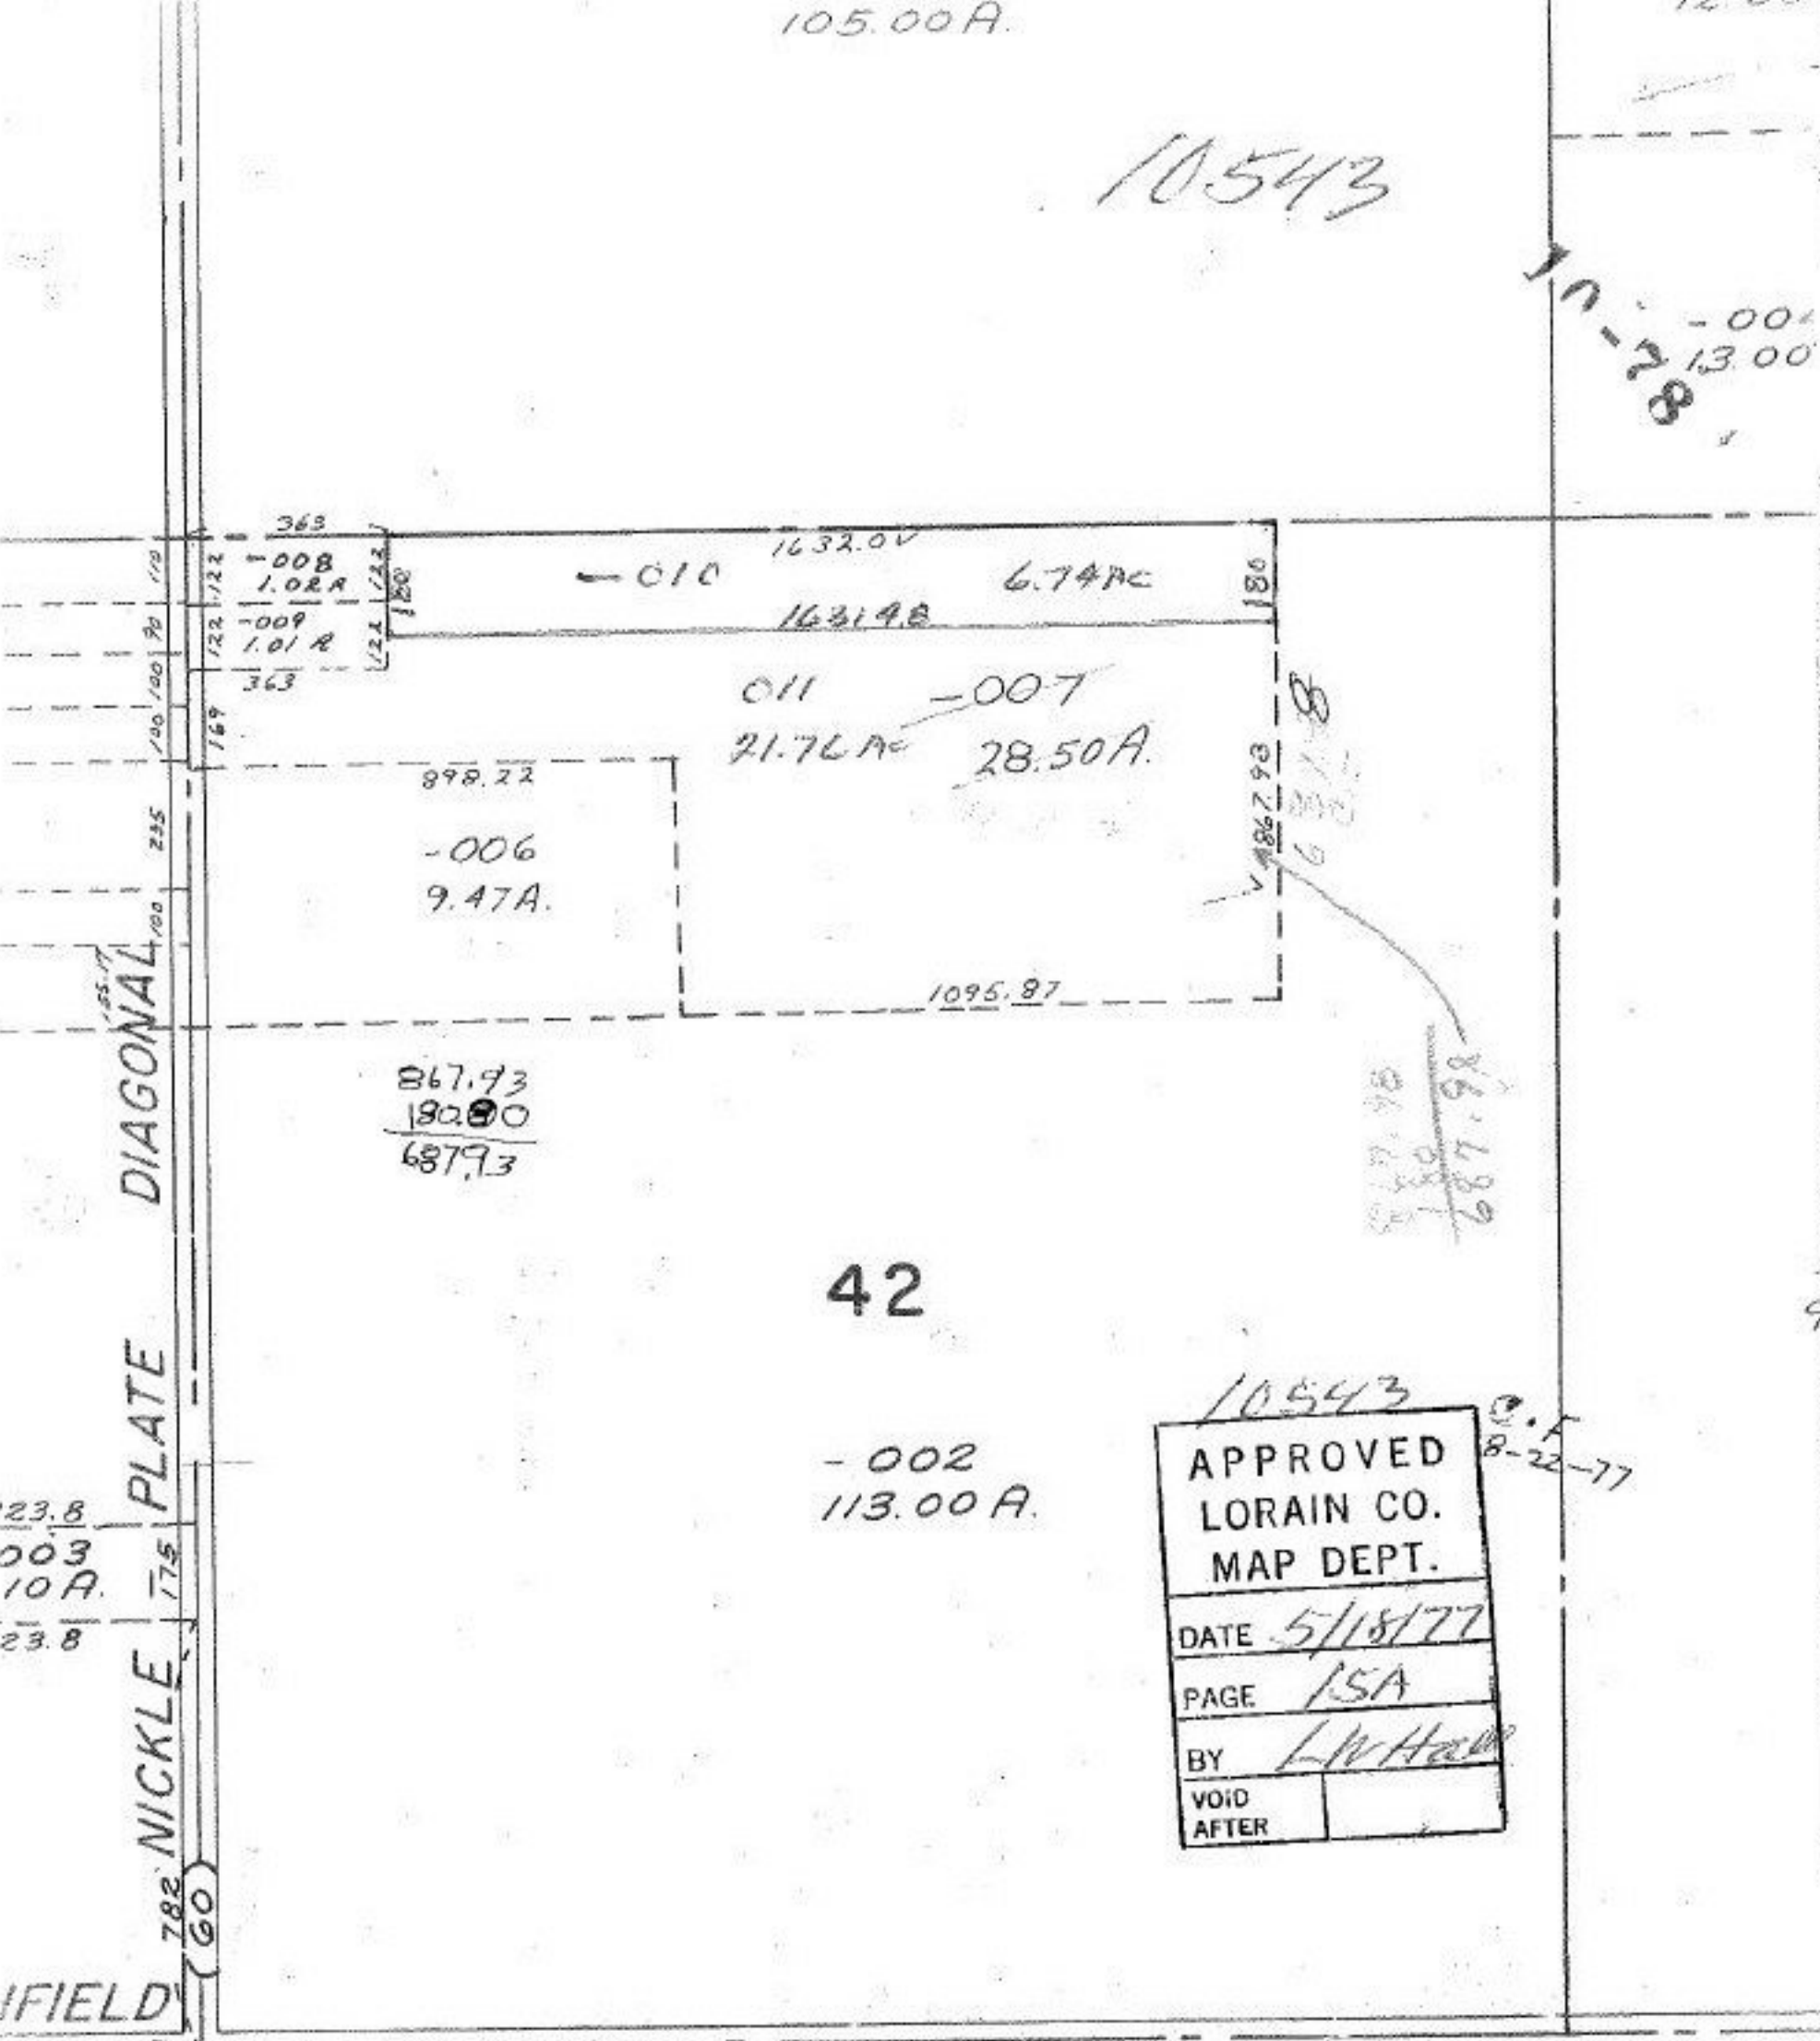

867.93
~~182.00~~
 687.93

867.98
~~182.00~~
 687.98

42

-002
113.00 A.

10543

APPROVED LORAIN CO. MAP DEPT.	
DATE	5/18/77
PAGE	15A
BY	L.W. Hall
VOID AFTER	

8-22-77

LOTS 1 THRU 3, 18 T