

-001
28.6

SEE 11-

#10545

APPROVED
LORAIN CO.
MAP DEPT.

DATE 5-19-77

PAGE 11-C

BY *J. D. ...*

VOID
AFTER

35.81
1.02
34.79

8/25/77
JB

82-01

MAY 23 1977

-024
34.79 A.


~~-022~~
35.81 A
~~36.81 A~~

291.54
45 -023
105.58 1.02 A. 290.40
303.60 394
-015
4.05 A.
435.90

35

-004
20.19 A.

ISLAND
2.00 A.

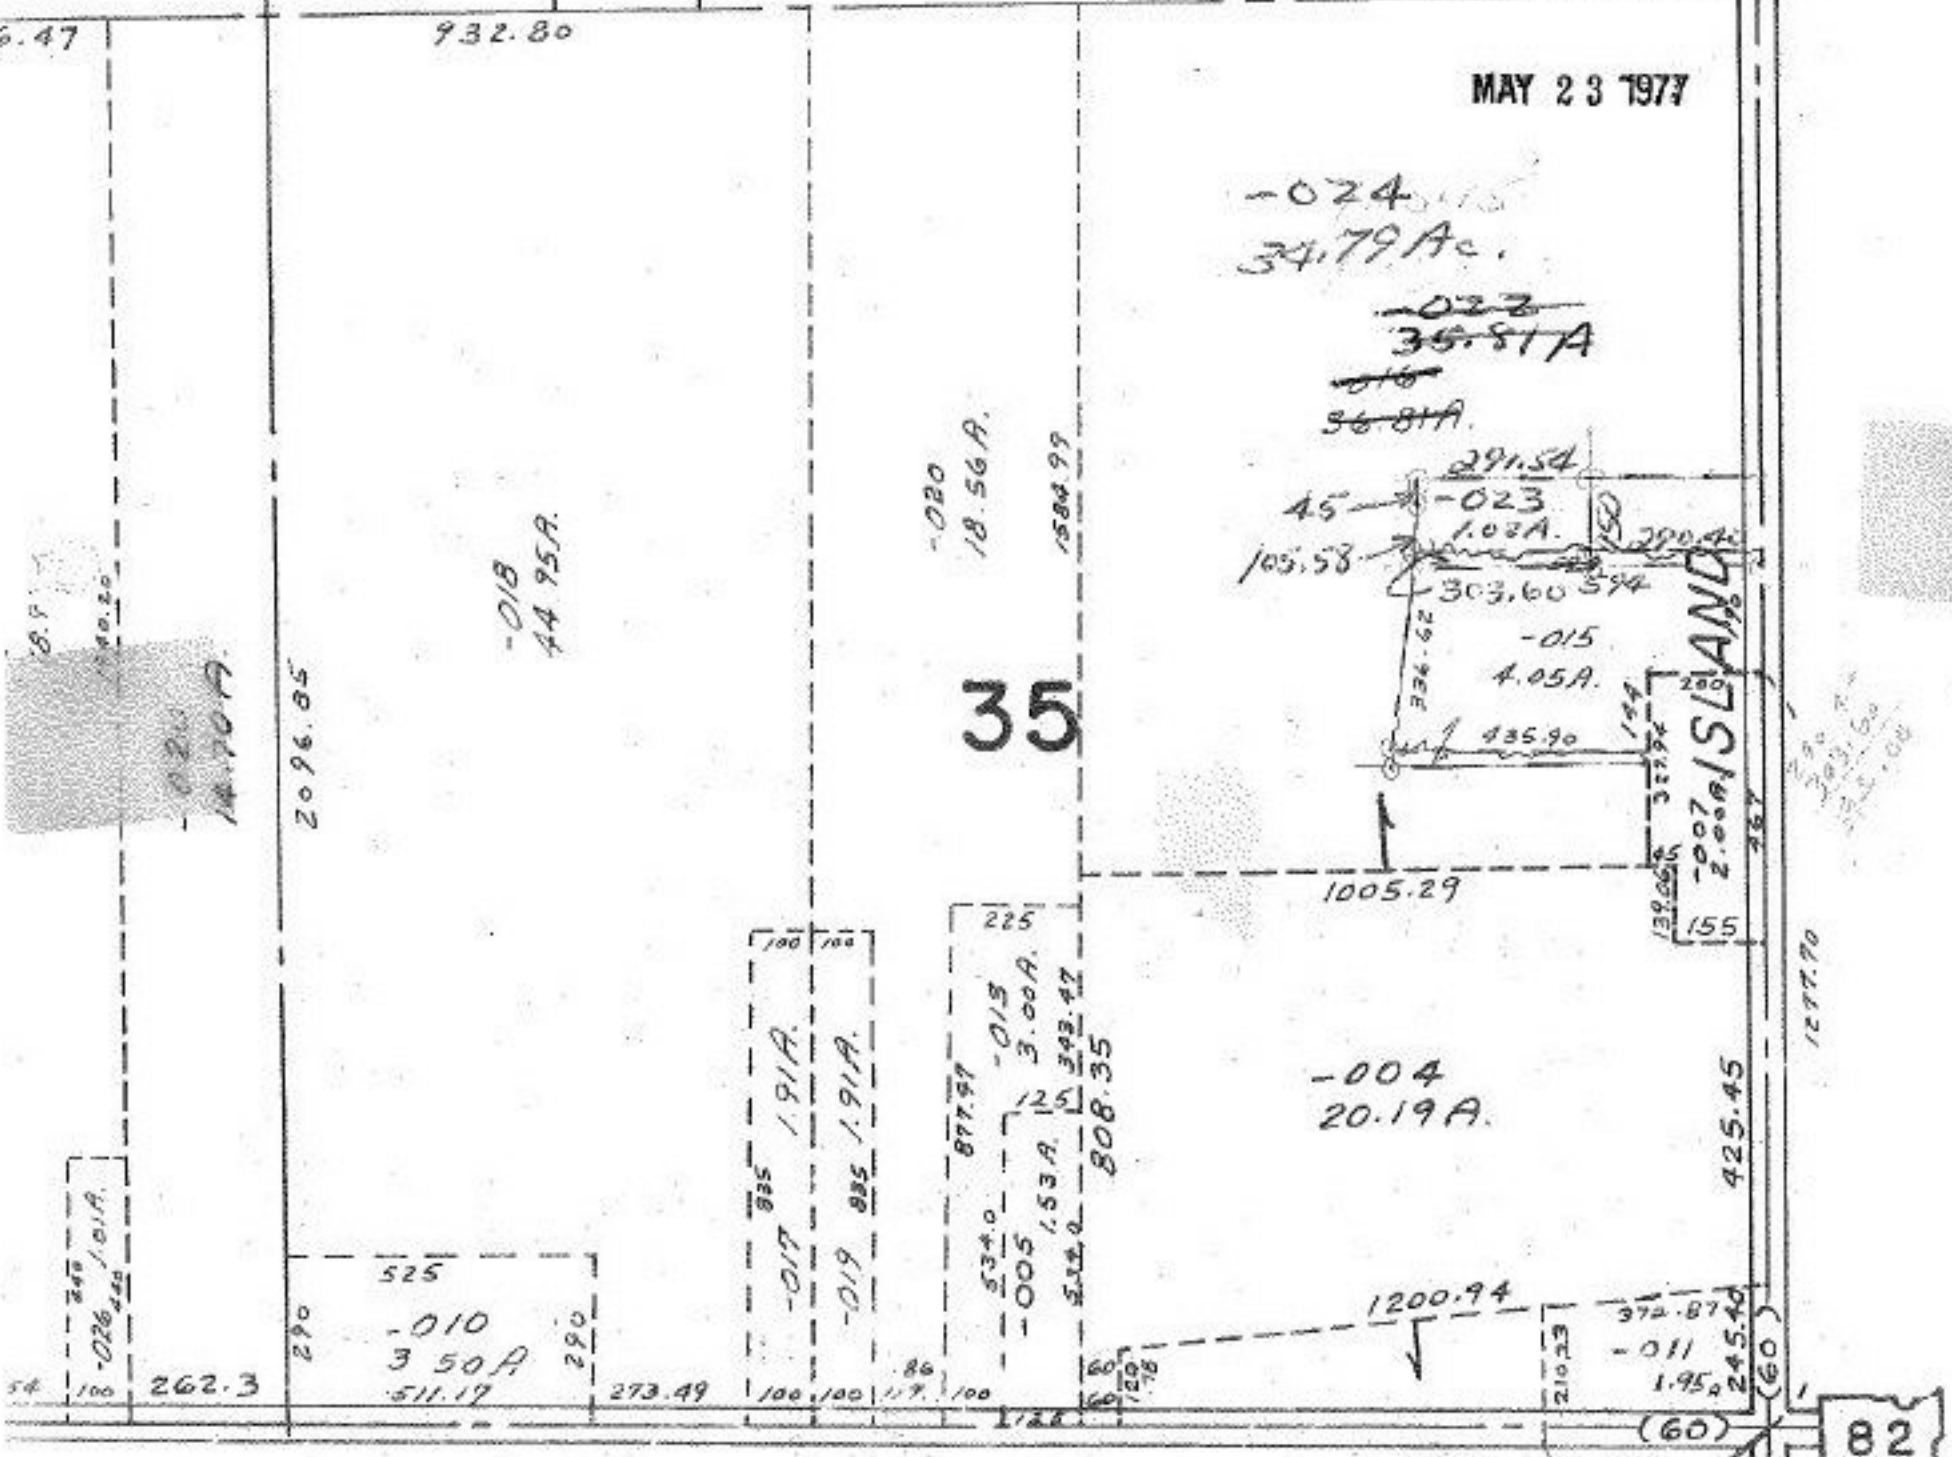

LOTS 31 THRU 35
46 " 50

82