


#1056810-10

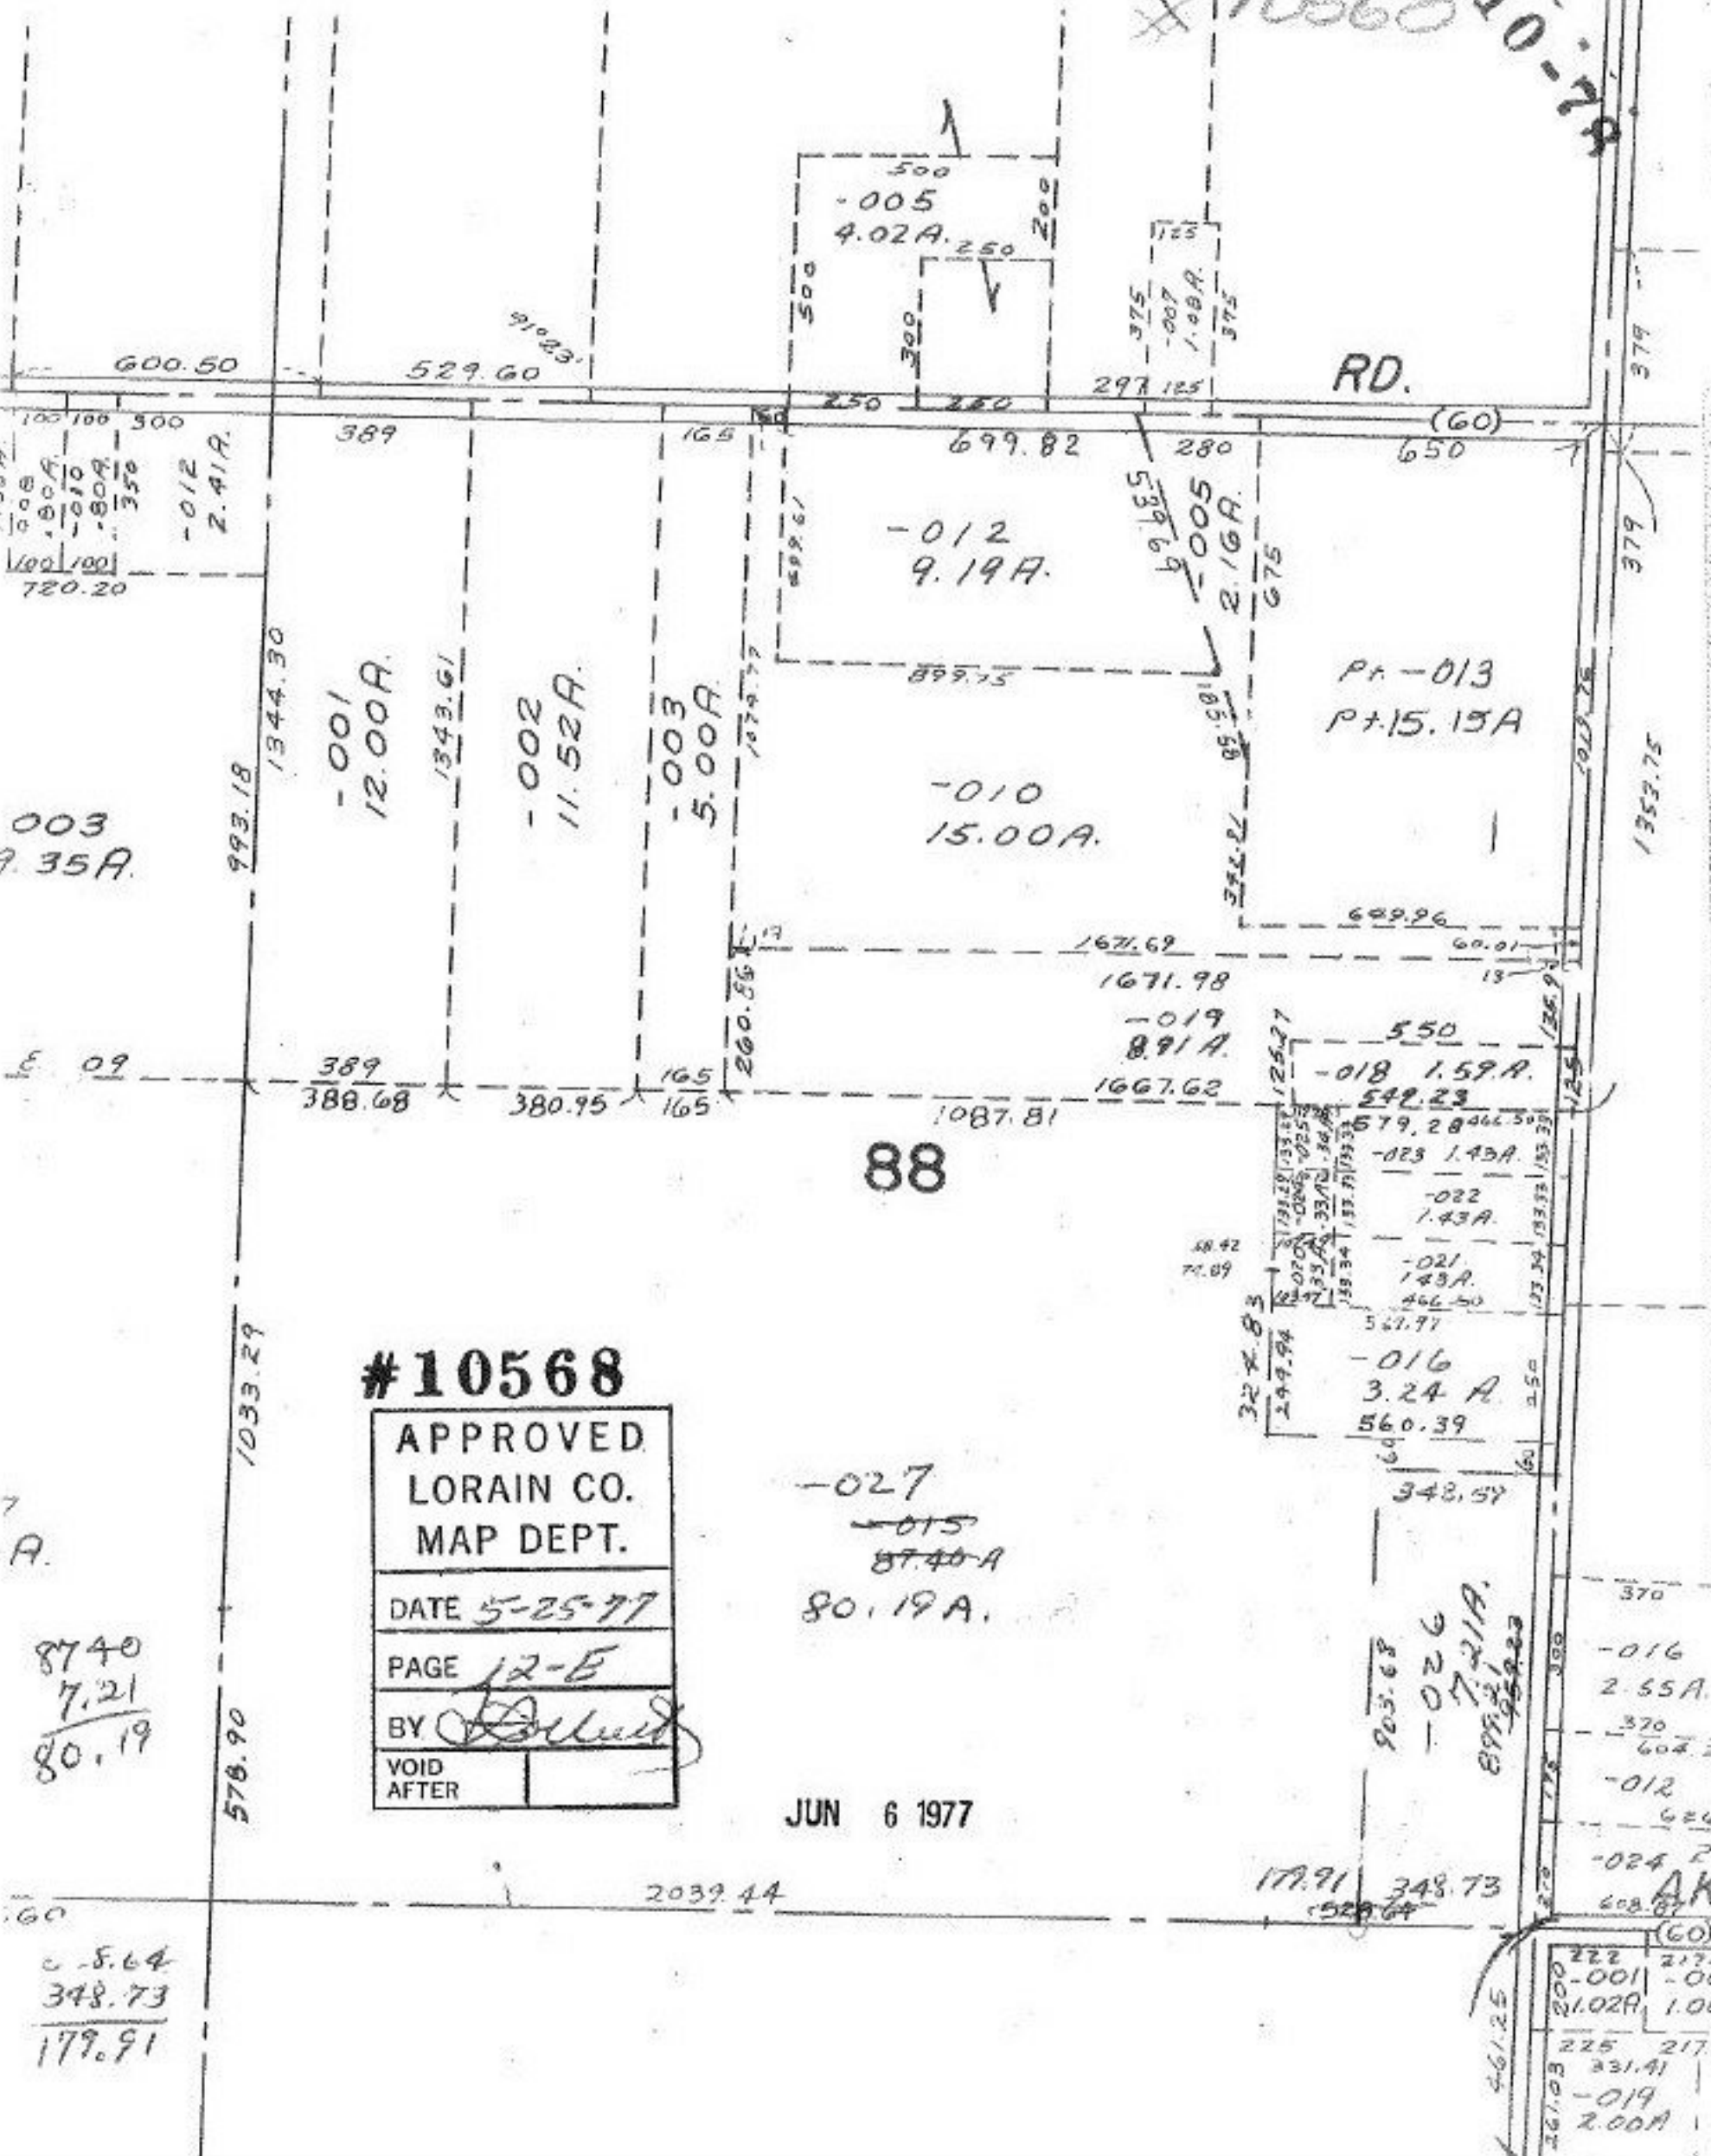

#10568

APPROVED	
LORAIN CO.	
MAP DEPT.	
DATE 5-25-77	
PAGE 12-E	
BY <i>[Signature]</i>	
VOID	
AFTER	

JUN 6 1977

8740  
7.21  
80.19

8.64  
348.73  
179.91

222	217
-001	-00
1.02A	1.00
225	217
331.41	
-019	
2.00A	