


SEE ALSO  
SEE 11-00-089-A

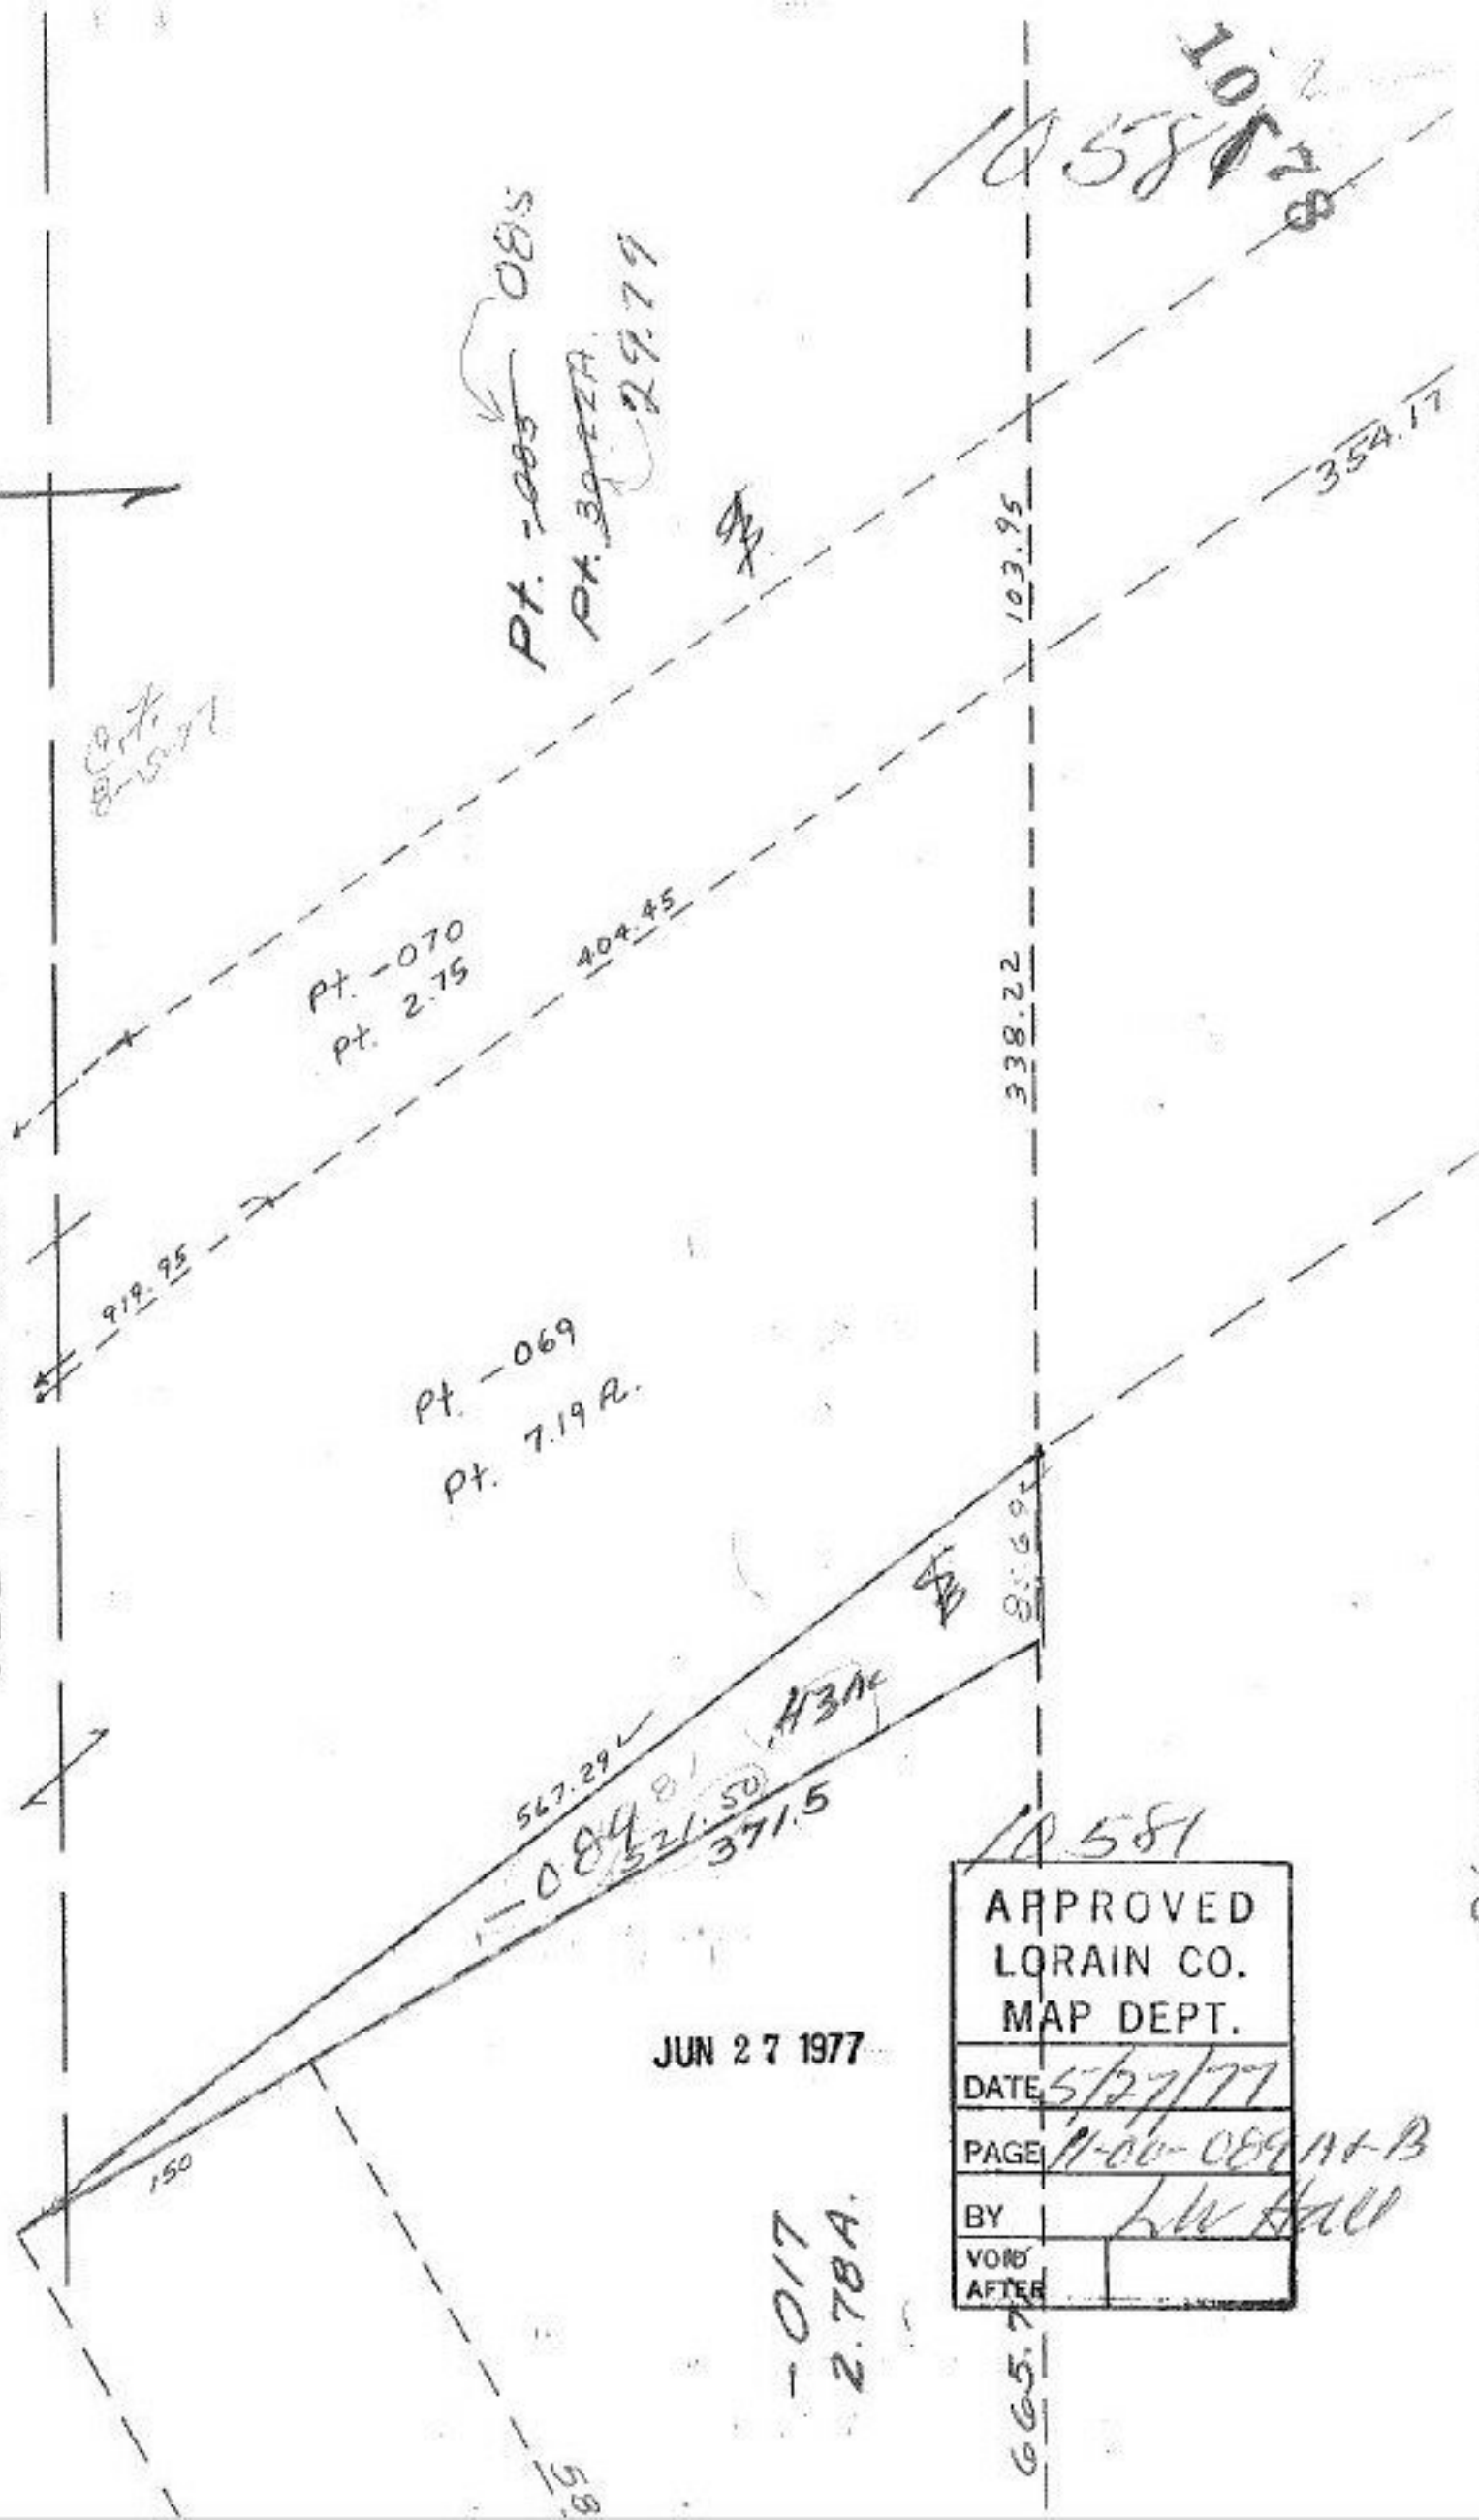

JUN 27 1977

10581

APPROVED LORAIN CO. MAP DEPT.	
DATE	5/27/77
PAGE	11-00-089 A+B
BY	LW Hall
VOID AFTER	

-017  
2.78A.

21-00