


18603

SE 10-78

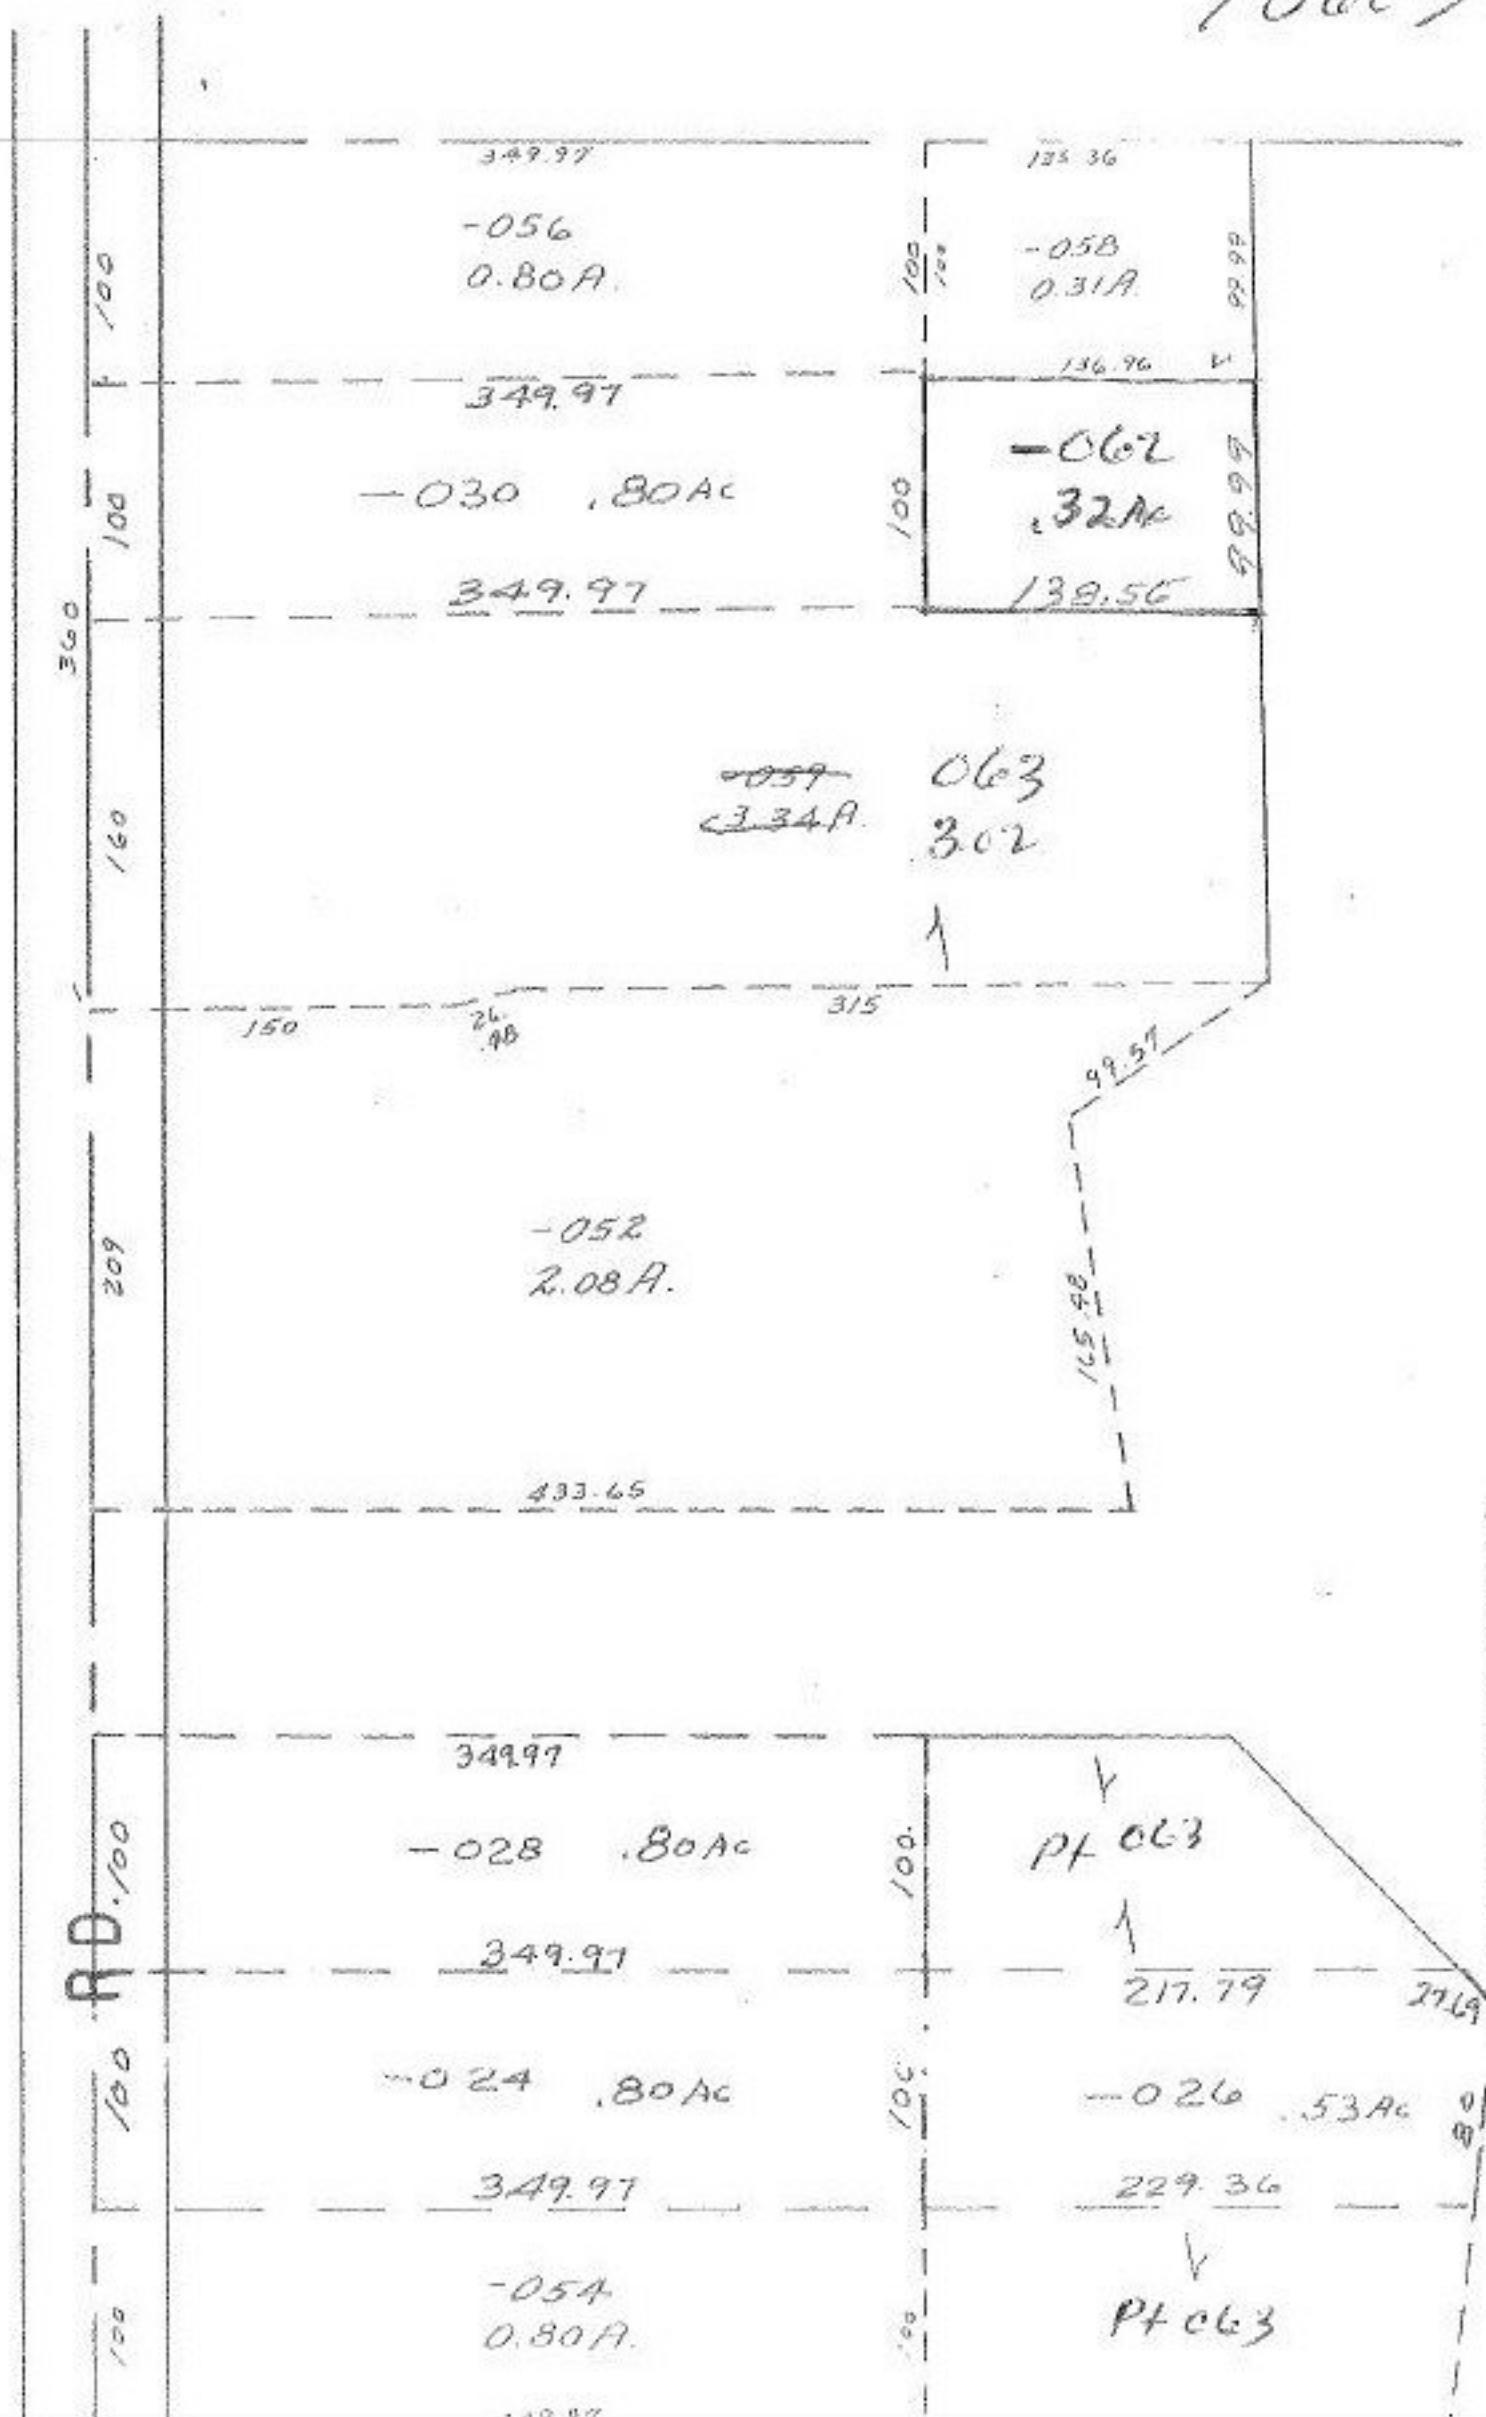

JUL 06 1977

10603

APPROVED LORAIN CO. MAP DEPT.	
DATE	6/3/77
PAGE	11-00-079A
BY	H. W. HALL
VOID AFTER	