


118-01-2-01
106116-118

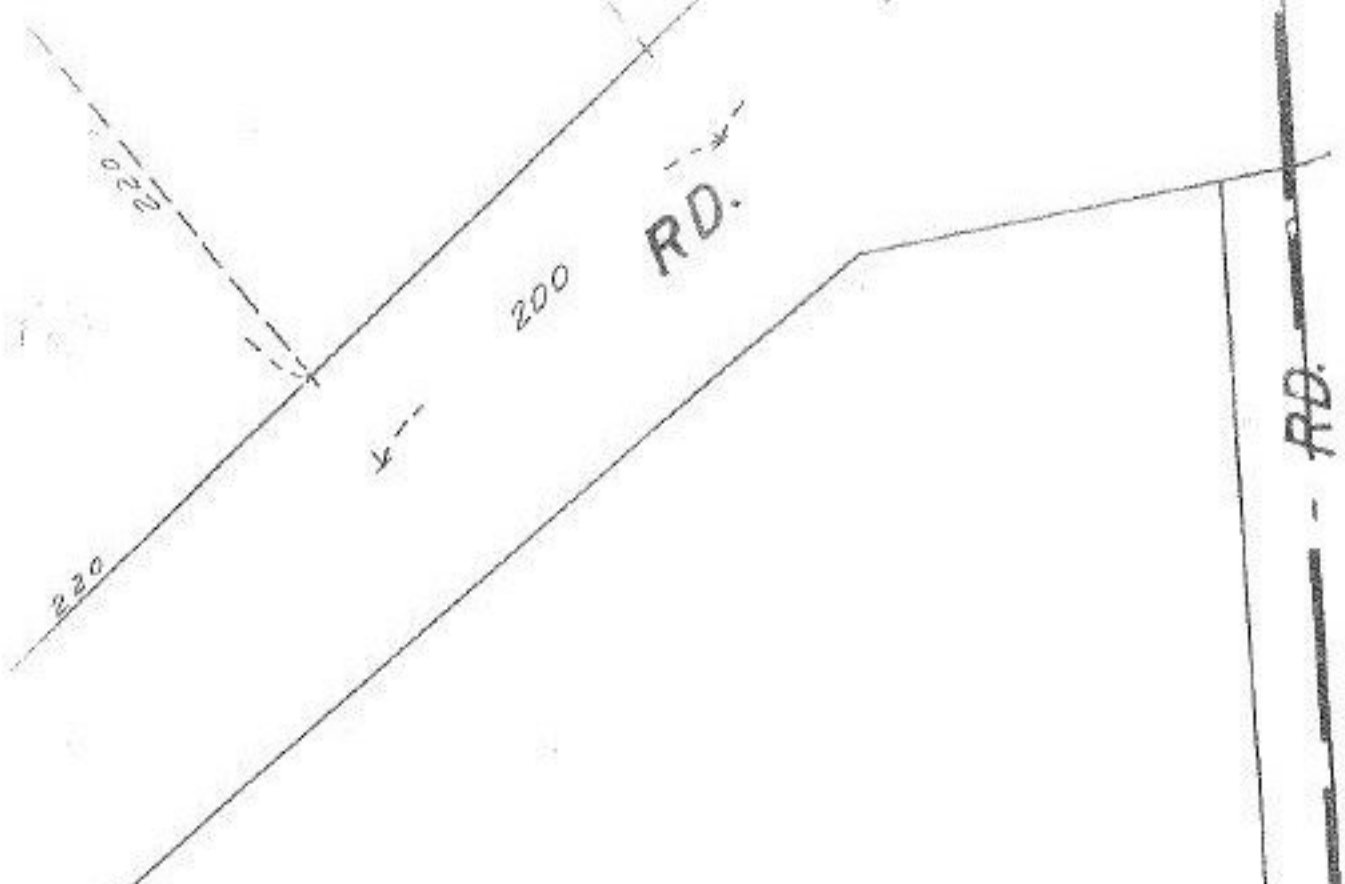


Correct Depth
of P.P.Nos
006
007
from 150 To 150

108

-012
11.43 A.

Authority DV 486-Pg 474
DV 465 Pg 3

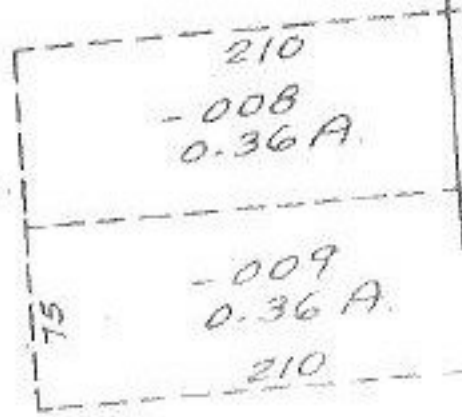

6/7/77

APPROVED LORAIN CO. MAP DEPT.	
DATE 6/7/77	
PAGE 2-03-001B	
BY <i>L.H. Hall</i>	
VOID AFTER	

100
FUELMER
02-021-A

2-03-001B

858.47