


10-28-77

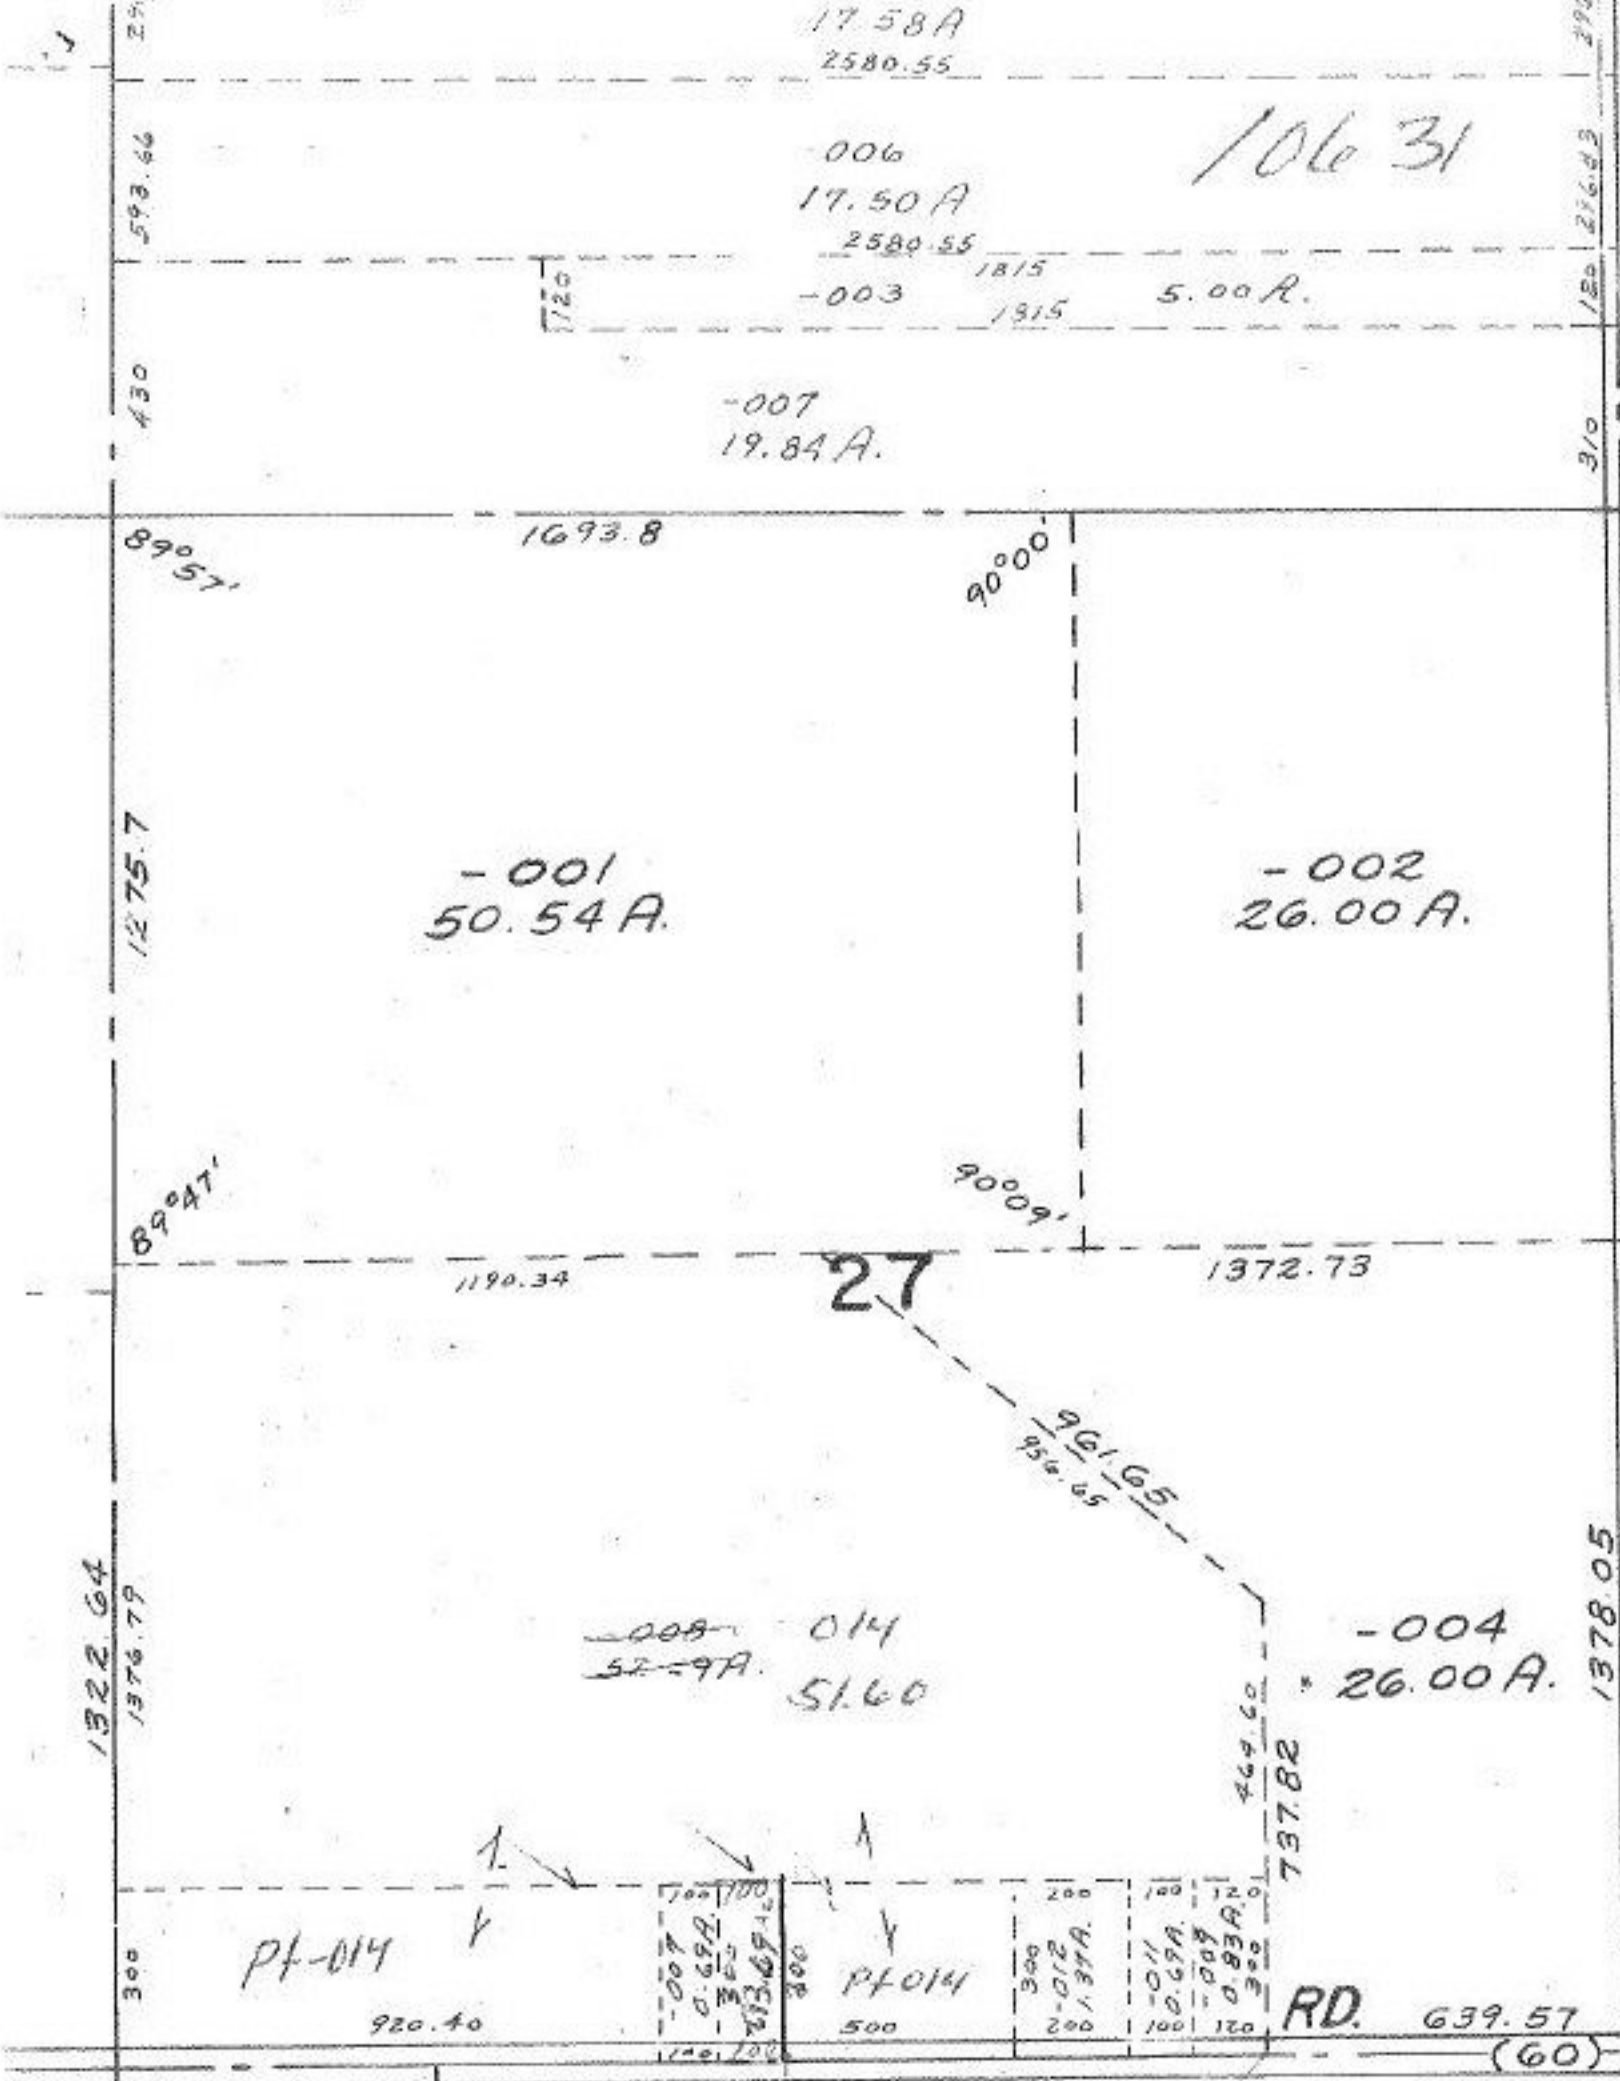

27

10631

JUN 16 1977

APPROVED
LORAIN CO.
MAP DEPT.

DATE 6/15/77

PAGE 15C

BY L.W. HALL

VOID
ACTED

-002
64.71 A. Dup.
63.435 A. D.

6.158-19-77