

118

SEE 19-06-1

10667

10.78

DIAGONAL

NICKLE PLATE


2871.0

700

125

-003 3.21 A

C

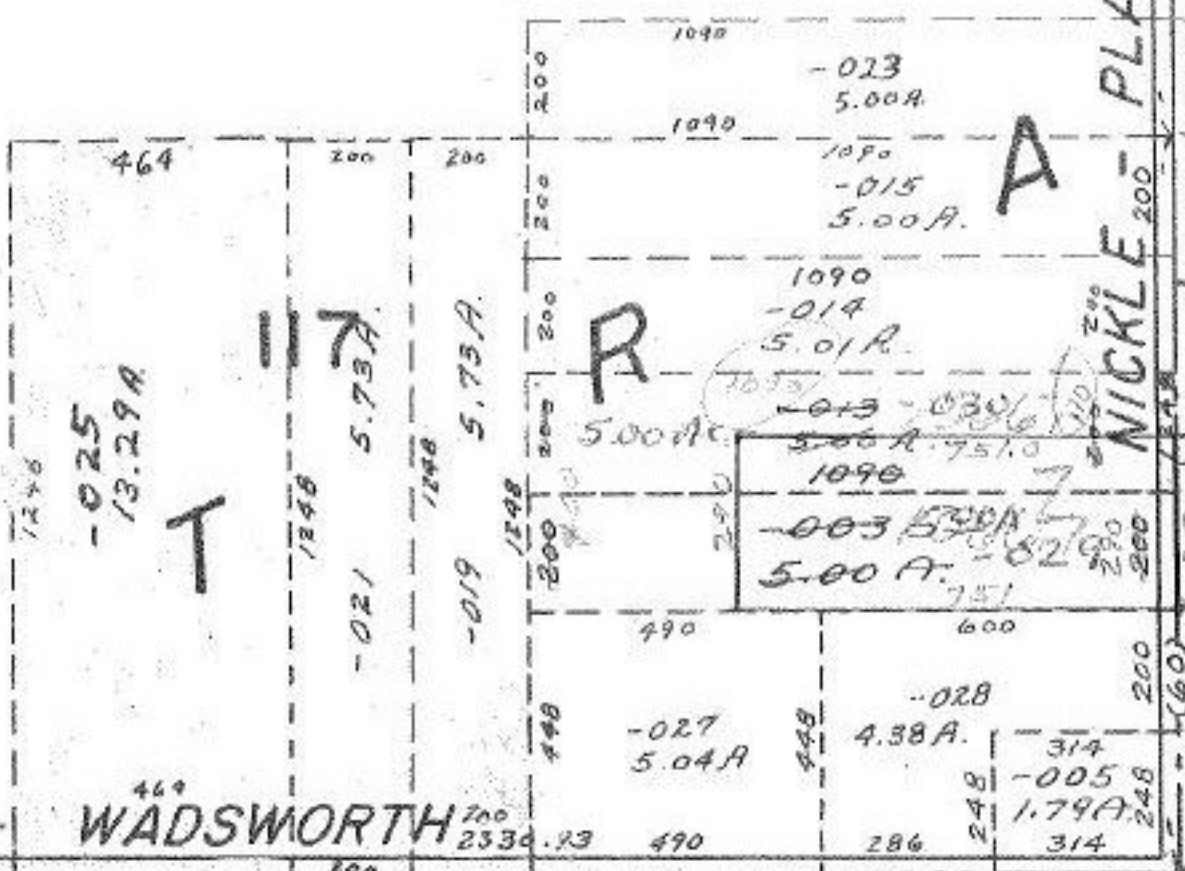

WADSWORTH

JUN 27 1977

APPROVED LORAIN CO. MAP DEPT.	
DATE	6/24/77
PAGE	12 A
BY	L. W. Hall, C.E.
VOID AFTER	

-015
17.79 A

-013
9.00 A

-011
8.46 A

-003
22.31 A

-001
31.72 A

-010
41.22 A