


10681-0-4B

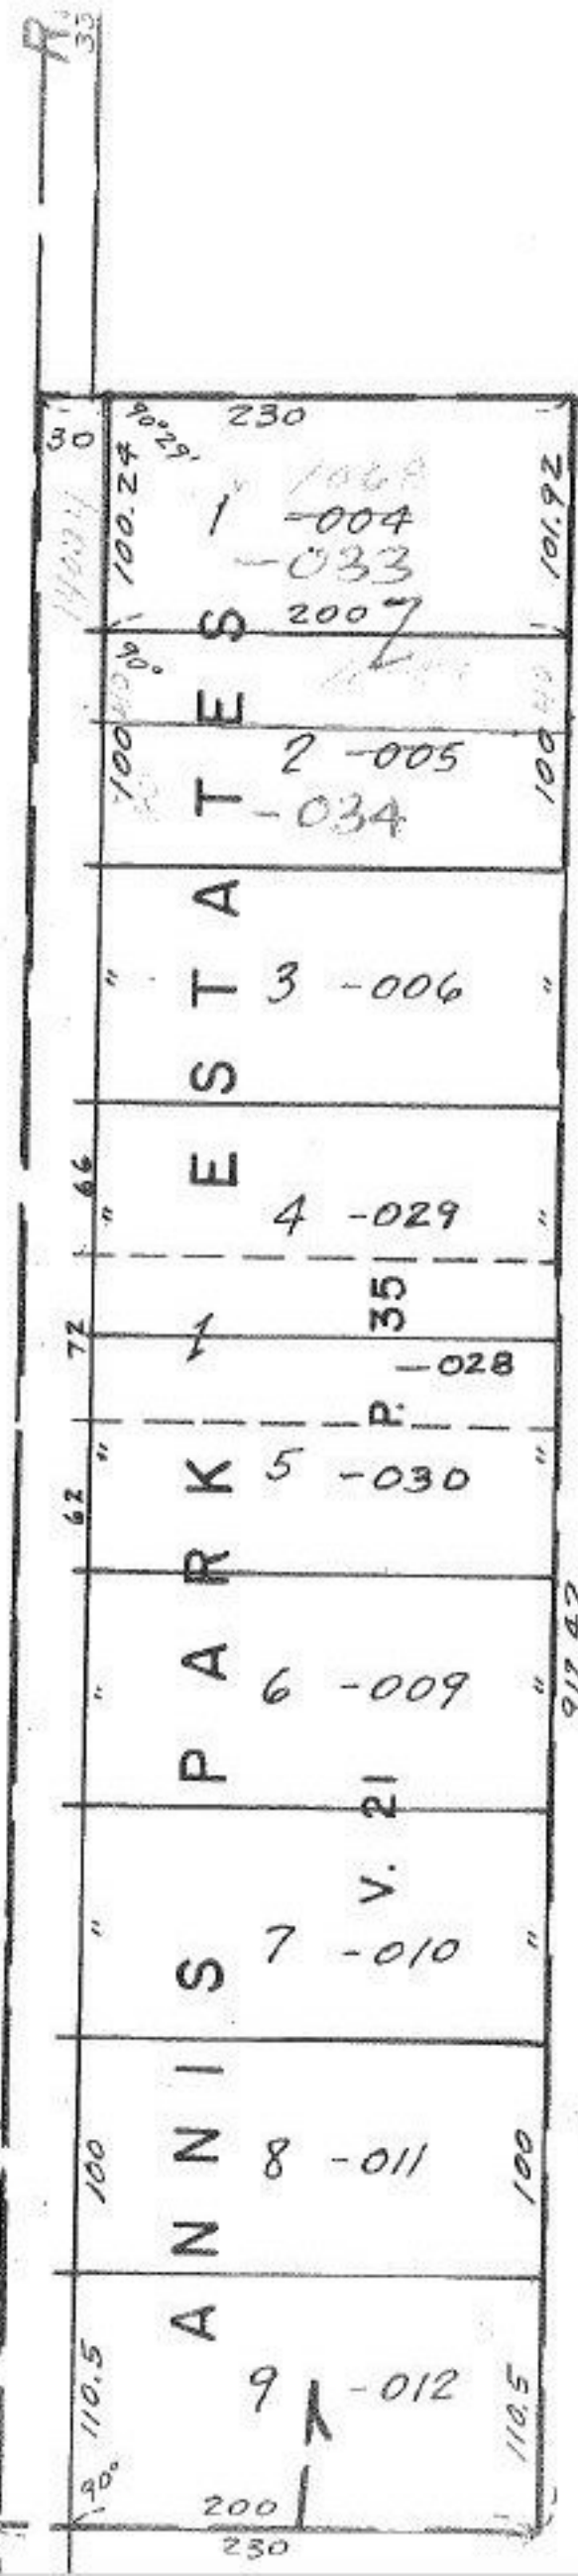

JUL 06 1977

10681

APPROVED LORAIN CO. MAP DEPT.	
DATE	6/28/77
PAGE	9-00-004B
BY	L. W. Hall
VOID AFTER	

-A