


00-004-A

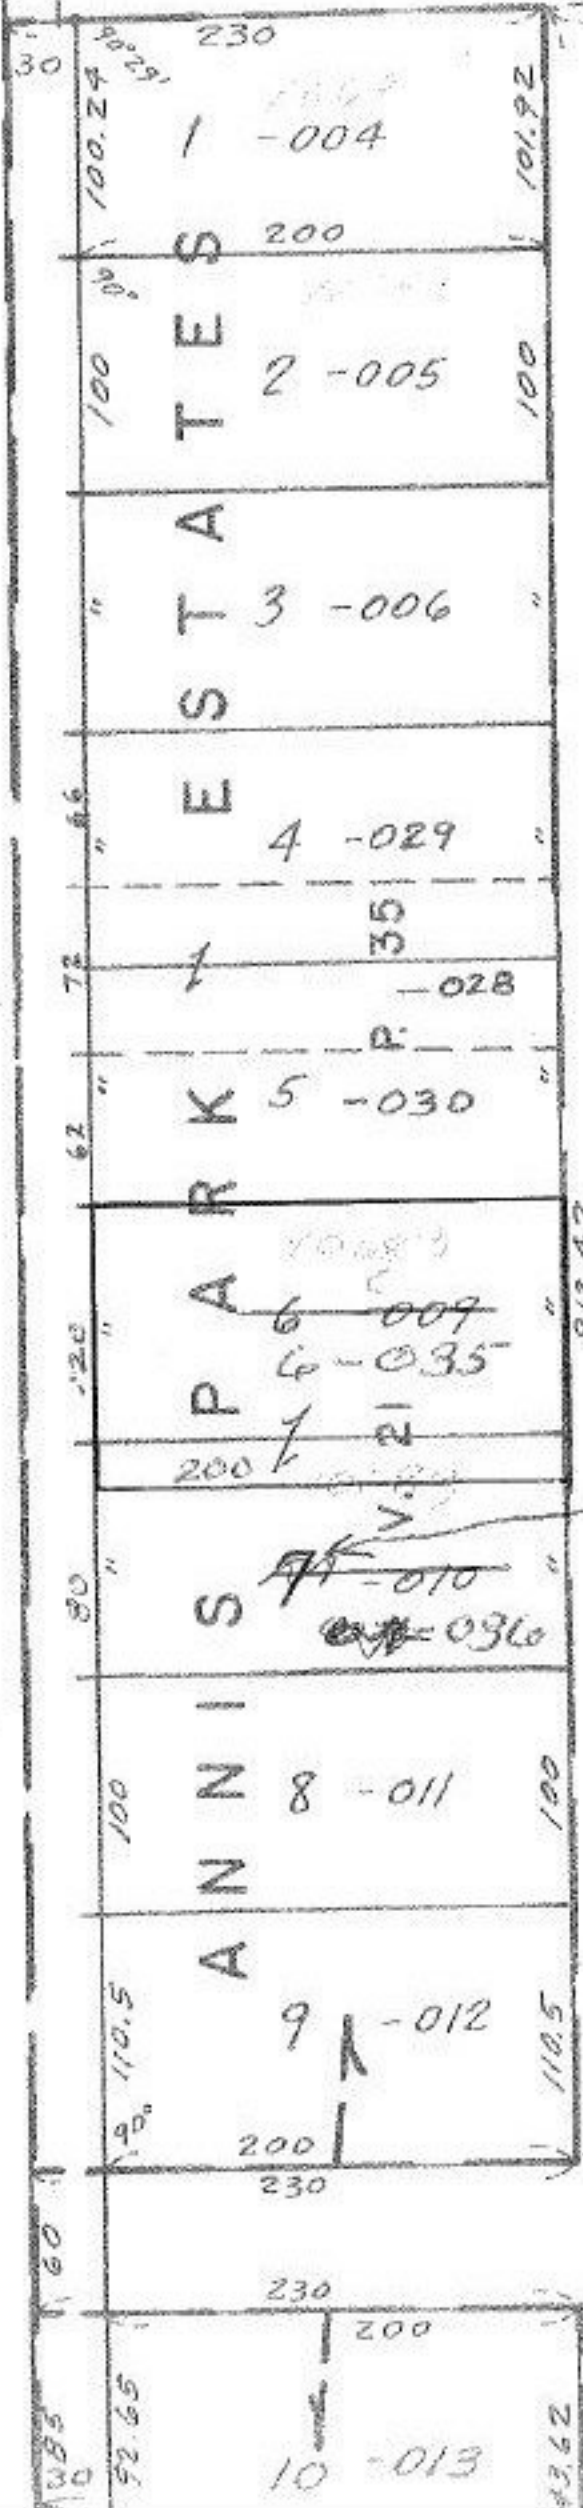

10683
10-28

Leave Number 7

JUL 06 1977

C.F.
8-24-77

APPROVED LORAIN CO. MAP DEPT.	
DATE	6/29/77
PAGE	09-00-004/13
BY	L. W. Hall (C. W. Hall)
VOID AFTER	