


10684

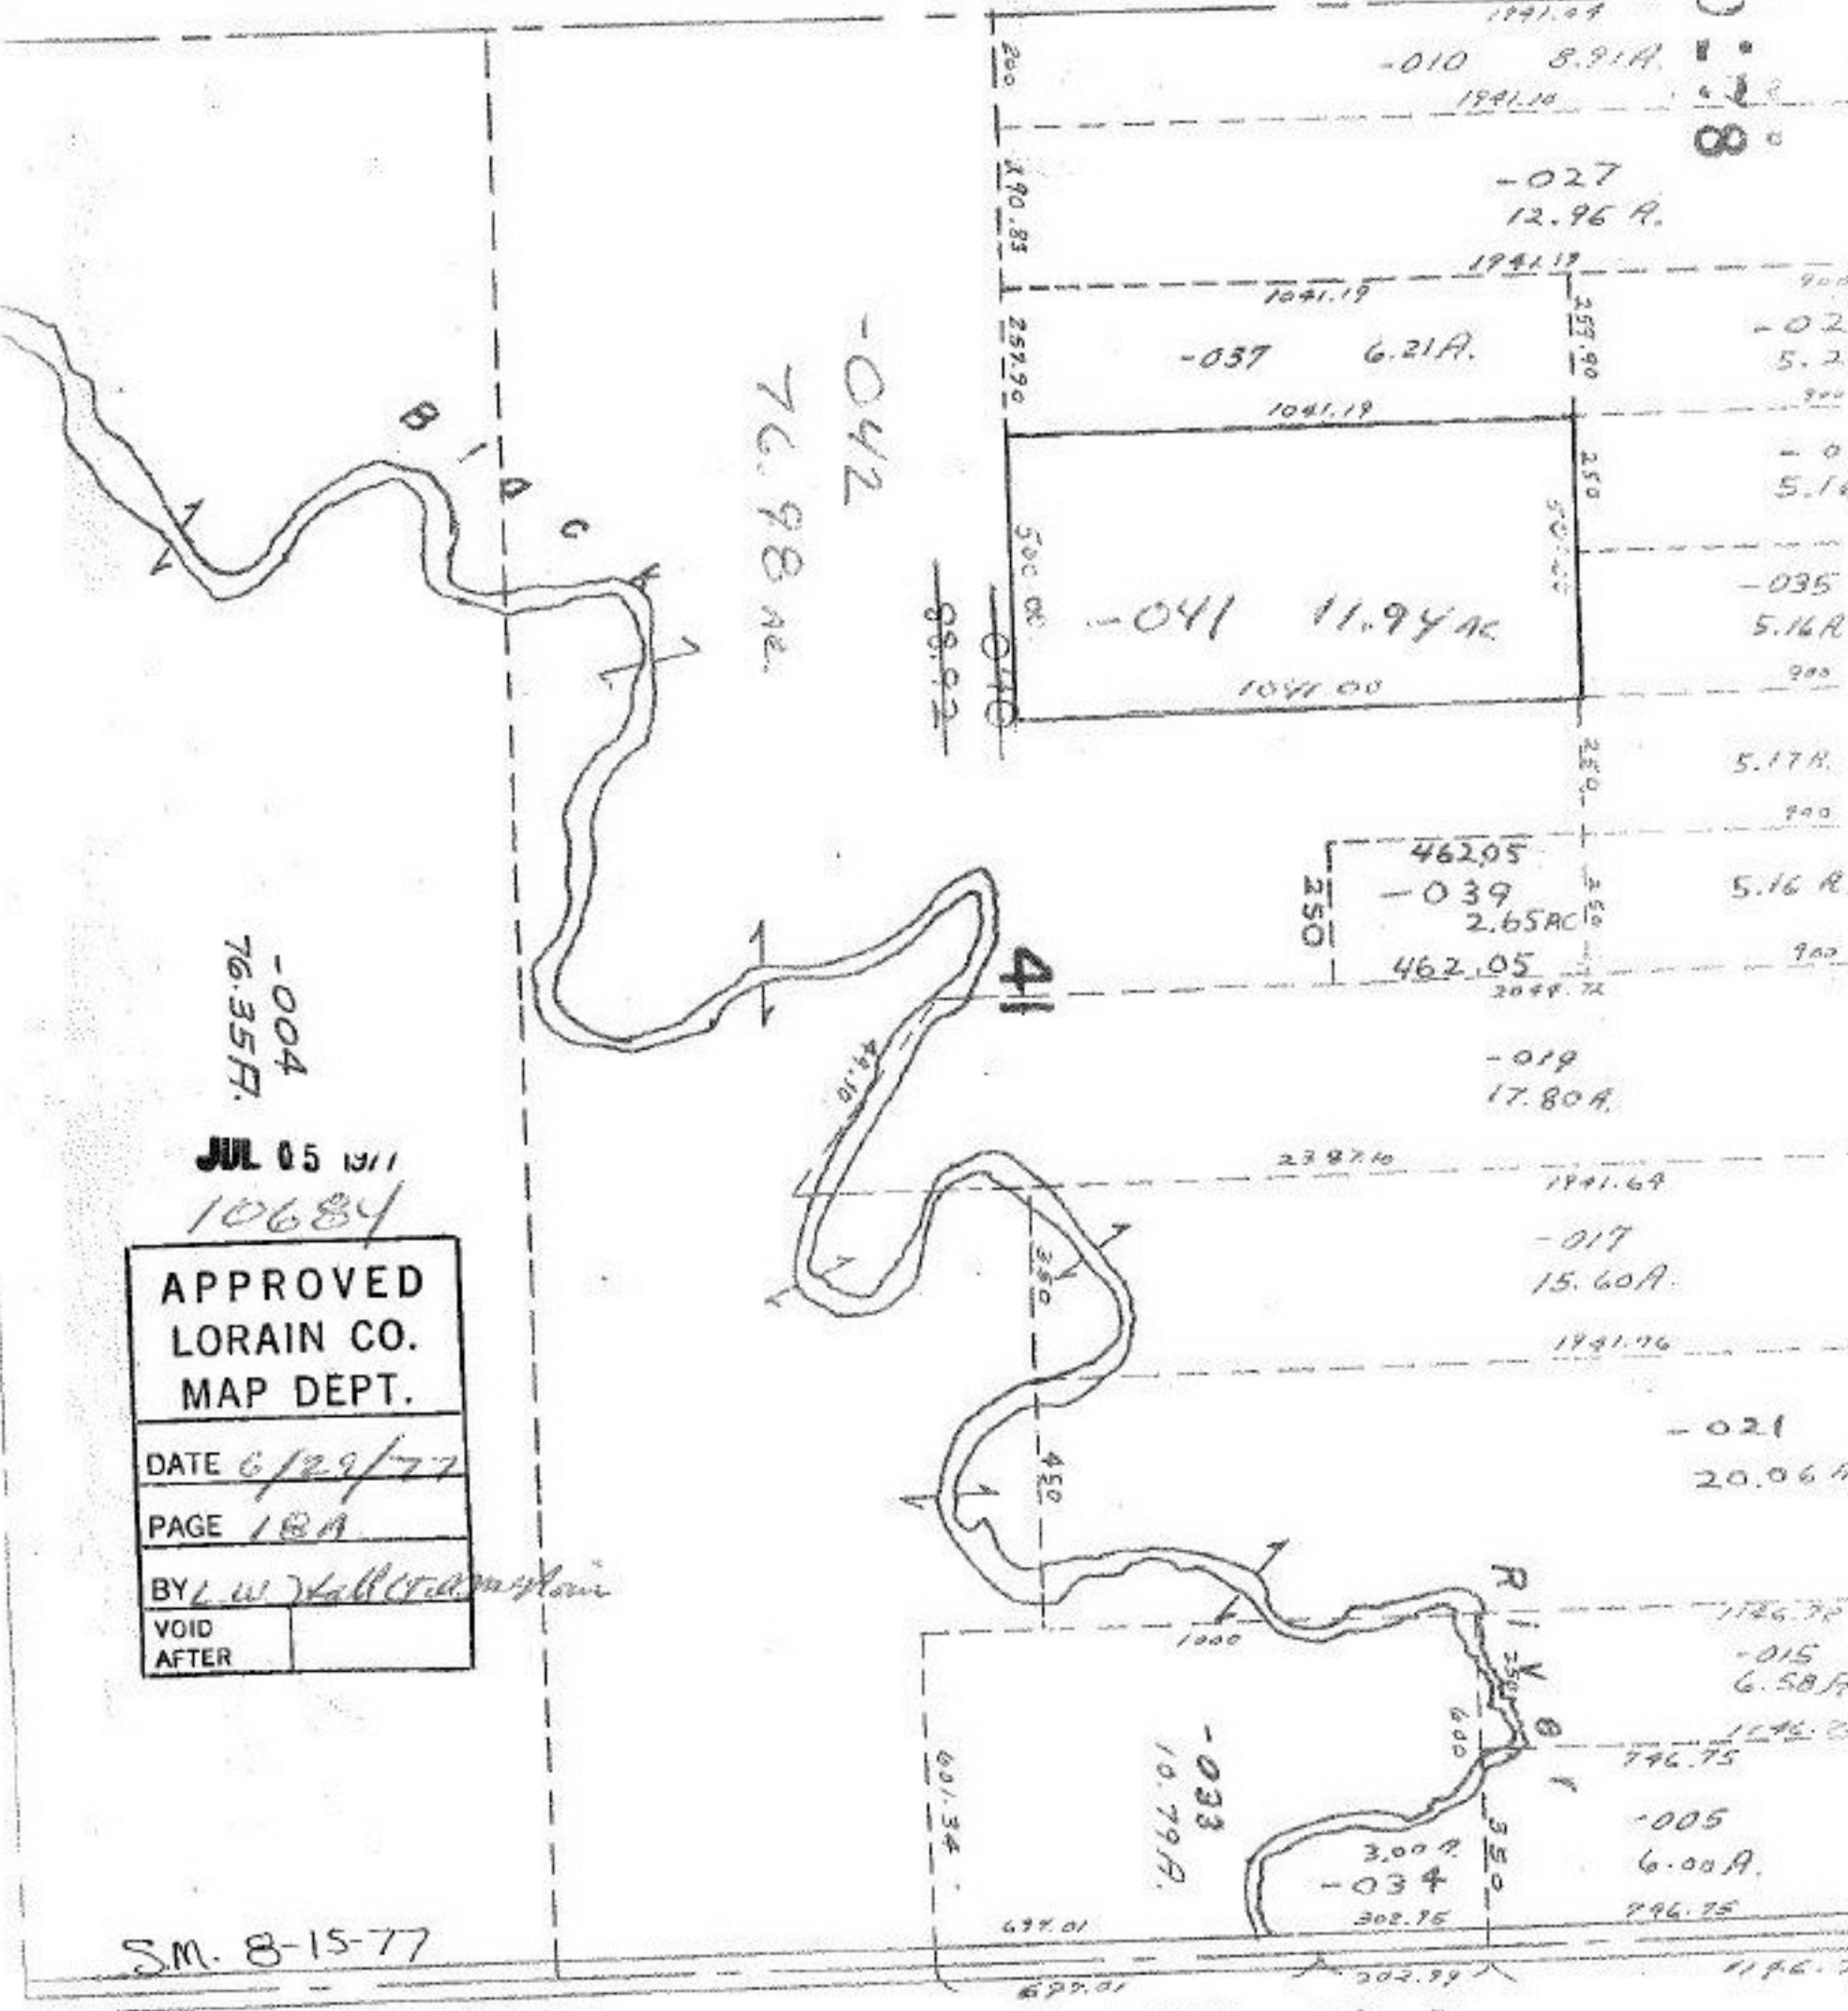

-004  
76.35 F.

JUL 05 1977  
10684

APPROVED LORAIN CO. MAP DEPT.	
DATE	6/29/77
PAGE	18A
BY	L. W. Hall (C. A. M. Hall)
VOID AFTER	

S.M. 8-15-77

SEE 18-B