


1070?

SEE 10-00-00

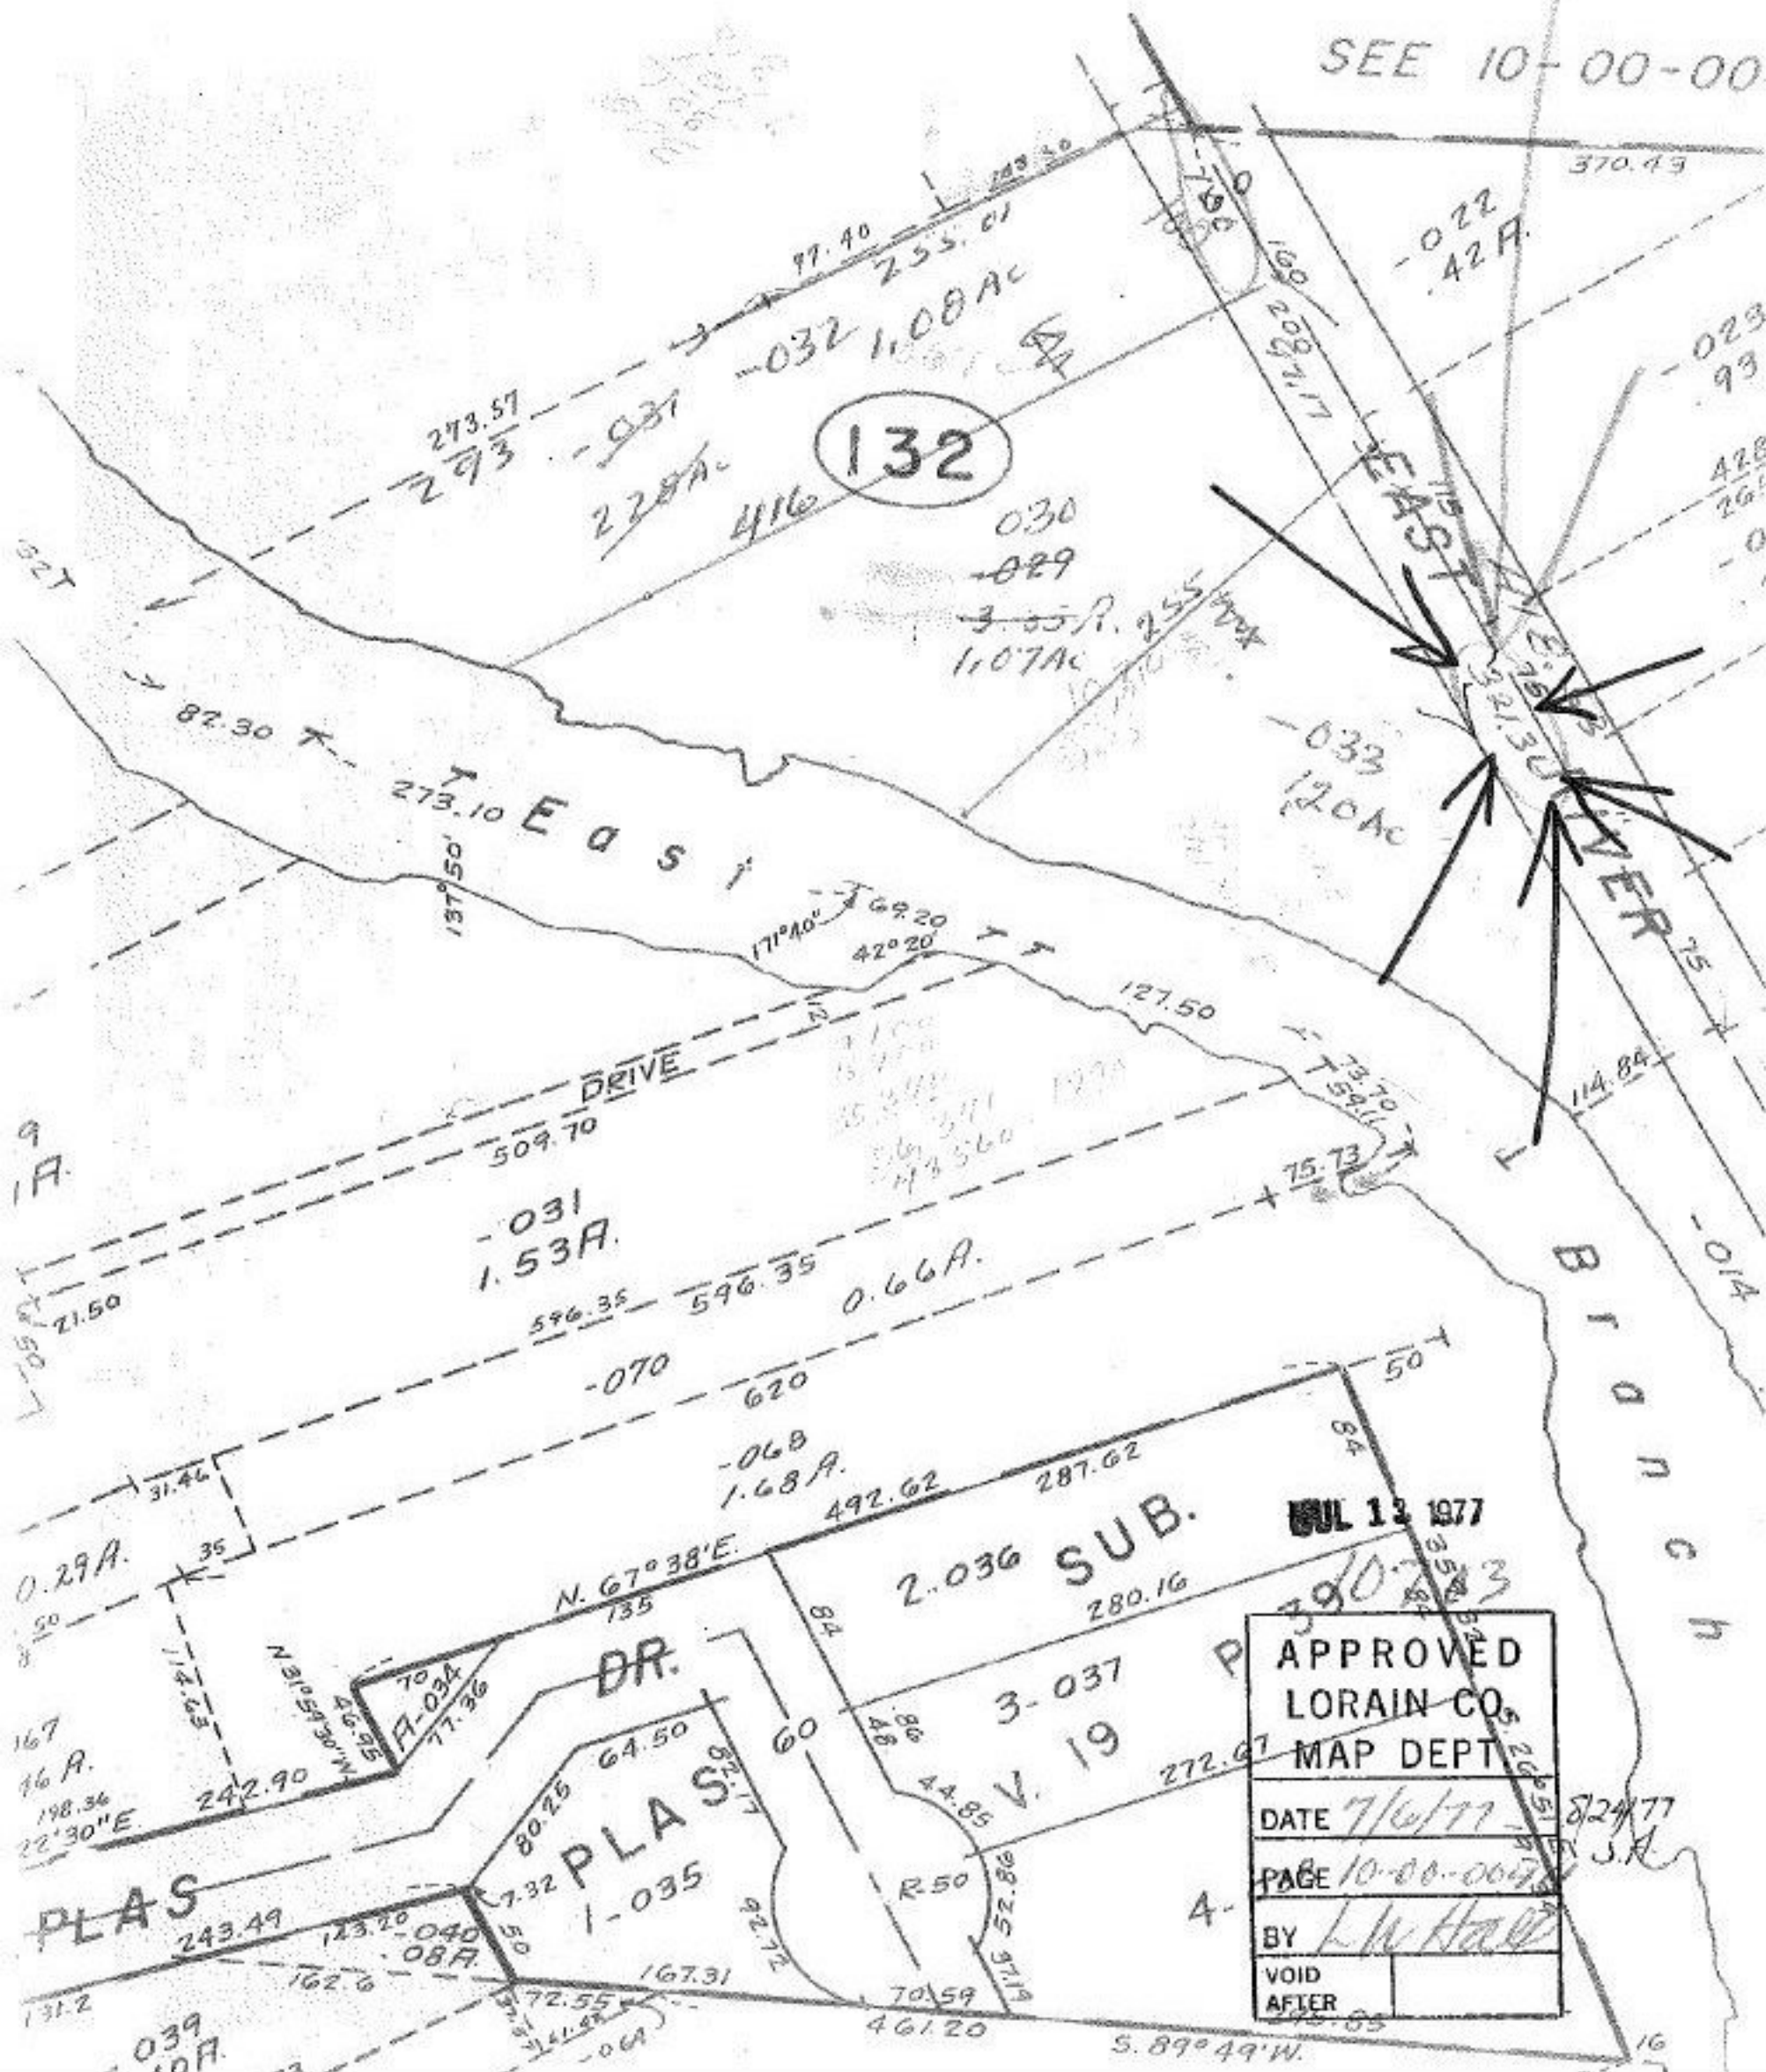

JUL 12 1977

APPROVED
 LORAIN CO.
 MAP DEPT.

DATE 7/6/77

PAGE 10-00-007

BY L. W. Hall

VOID
 AFTER

8/24/77

S. 89° 49' W.