



10704

-001  
7.32A  
When Completed Send  
Copy of Page To  
App. Dept.

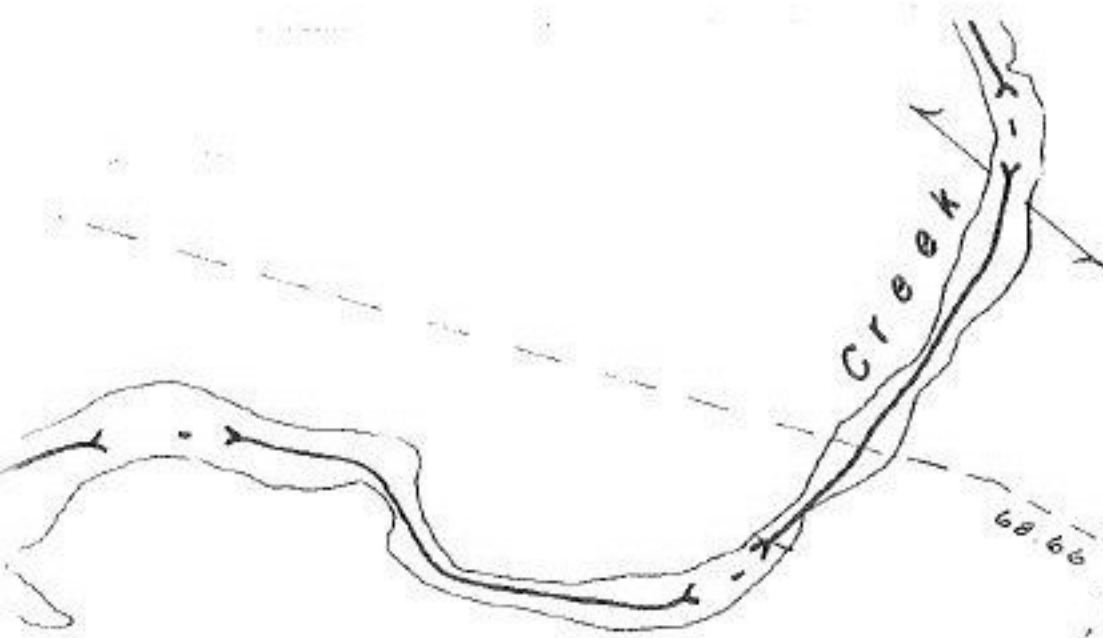

**#10704**  
APPROVED  
LORAIN CO.  
MAP DEPT.  
DATE 11-15-77  
PAGE 5-00-06 A+B  
BY *Robert*  
VOID  
AFTER  
11-15-77

7  
7.41

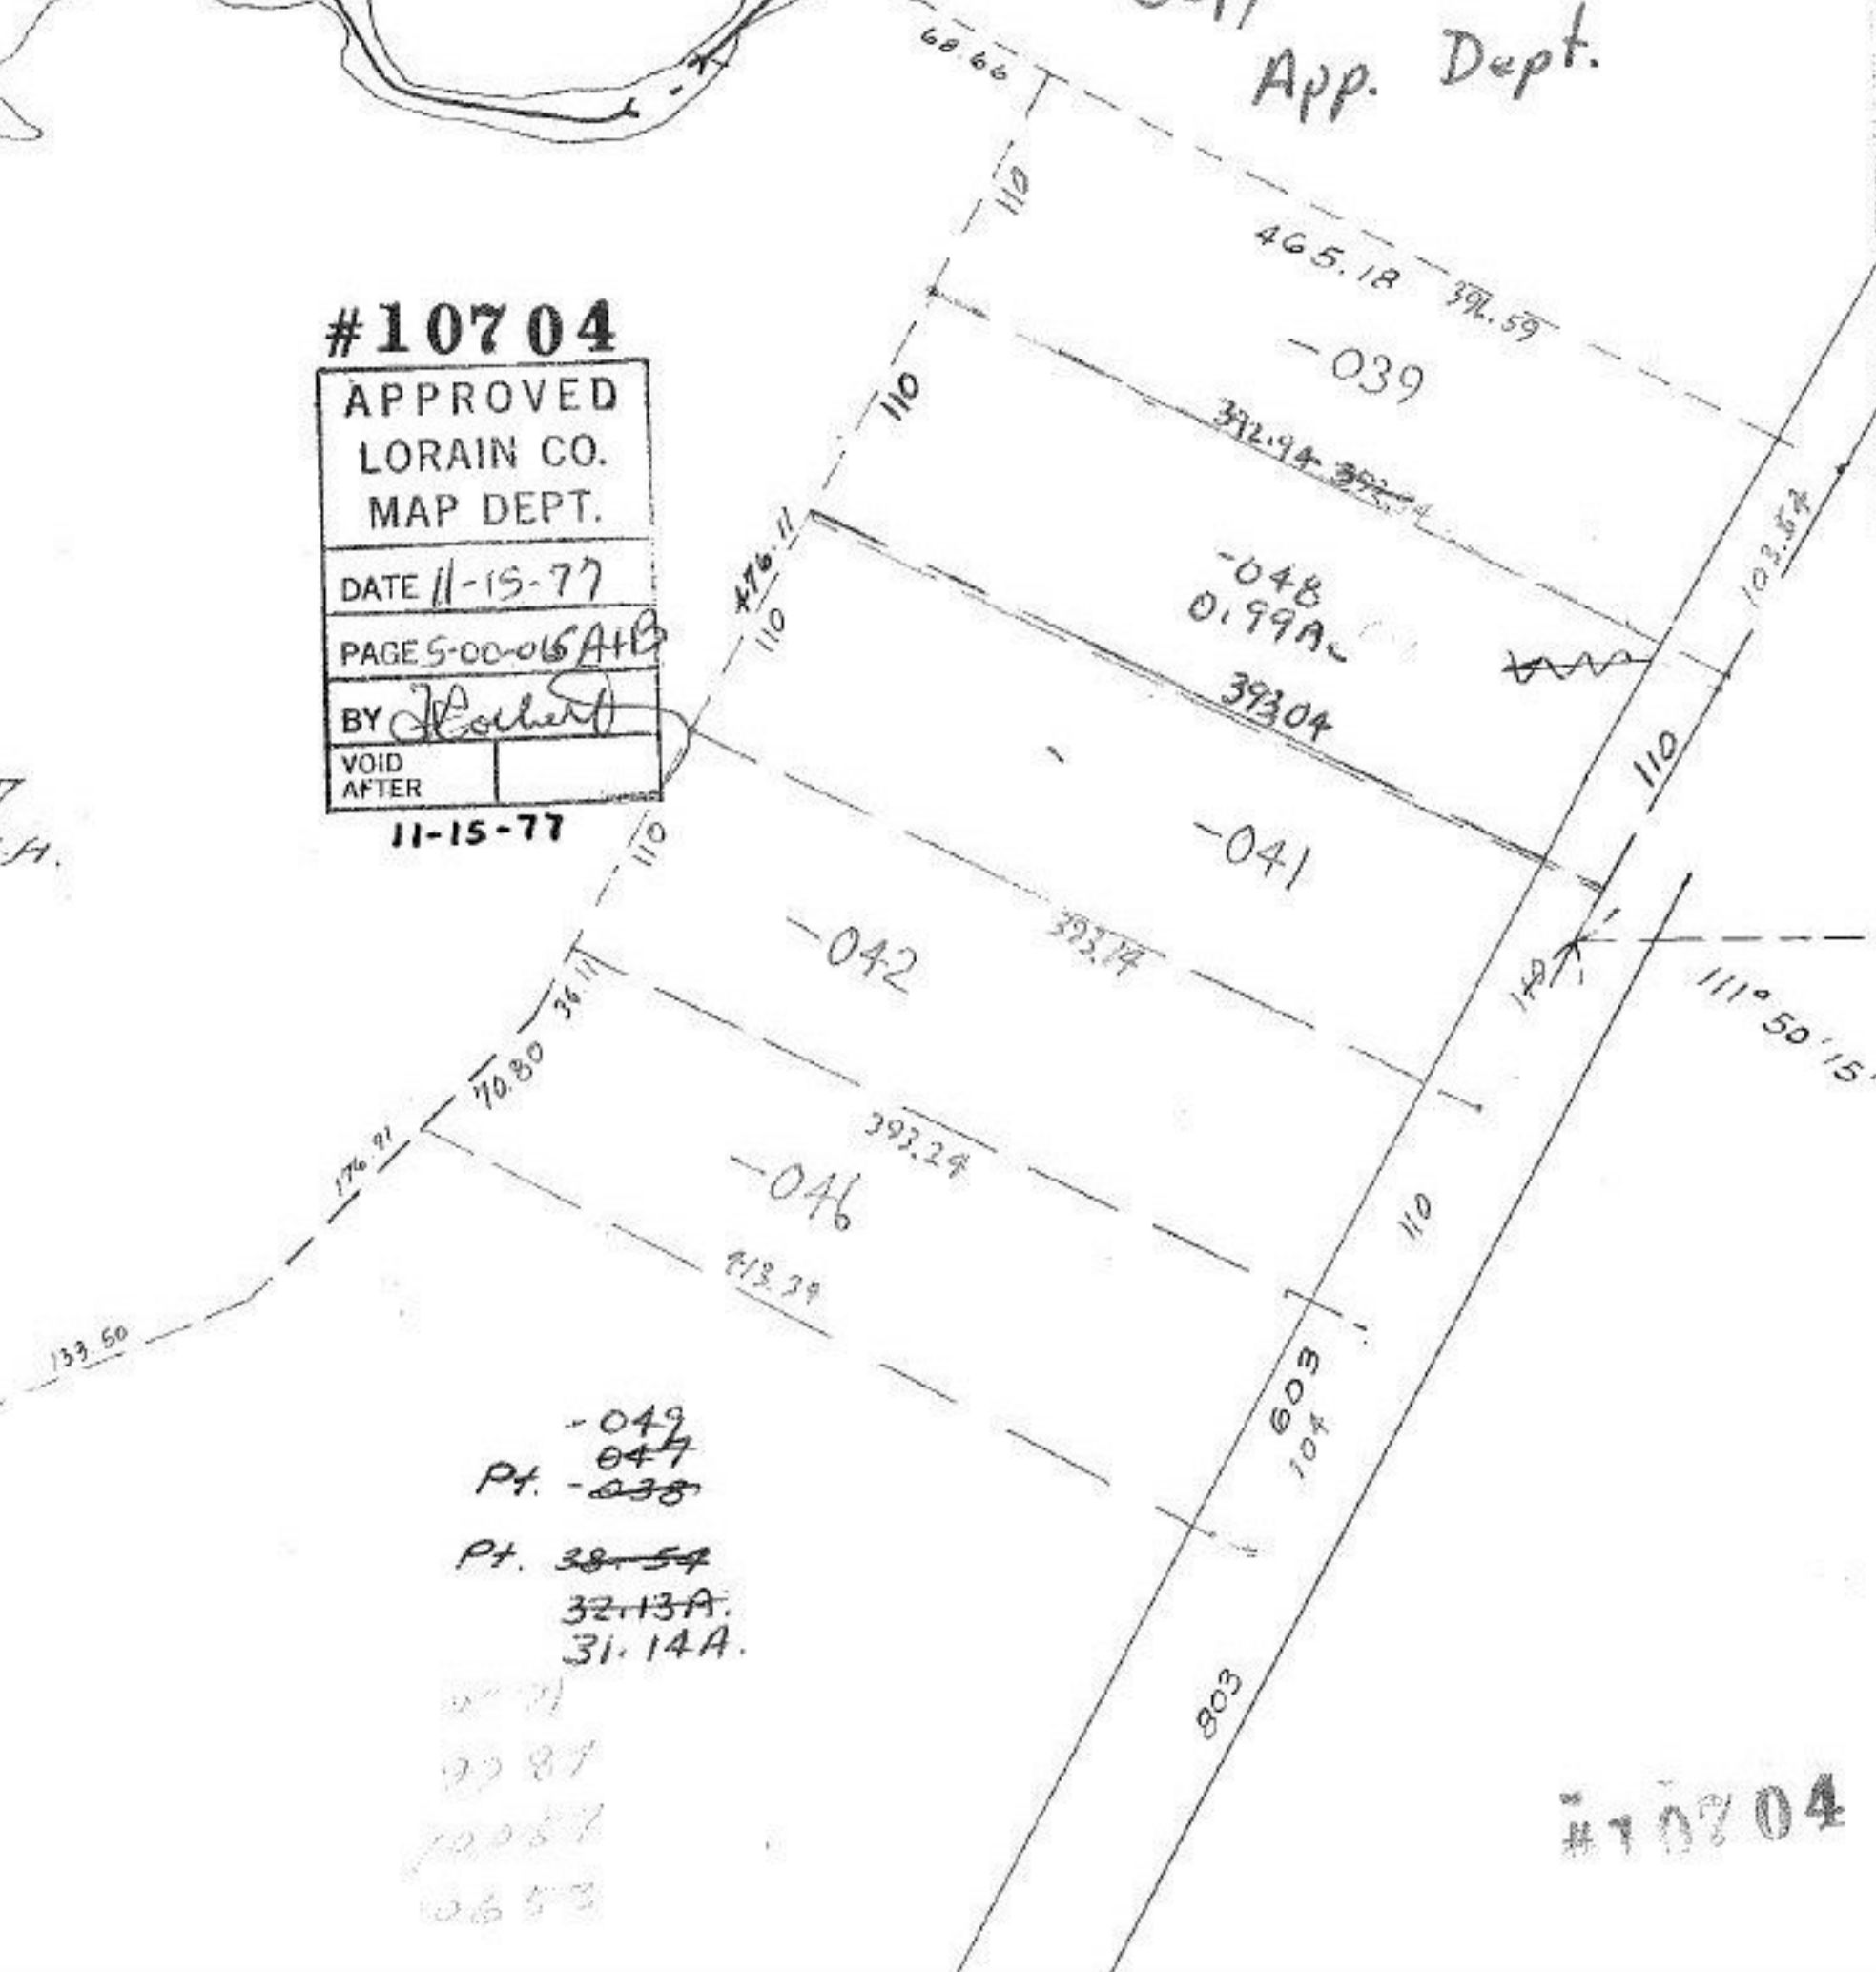

-049  
Pt. -047  
-038  
Pt. 38-54  
32-13A.  
31-14A.

27-71  
22-87  
20-67  
20-53

#10704