

SEE 4-00-02.

10710


Pt 04-00-026-108-001

RD. 60

10710

JENNIE

PT 1.53A

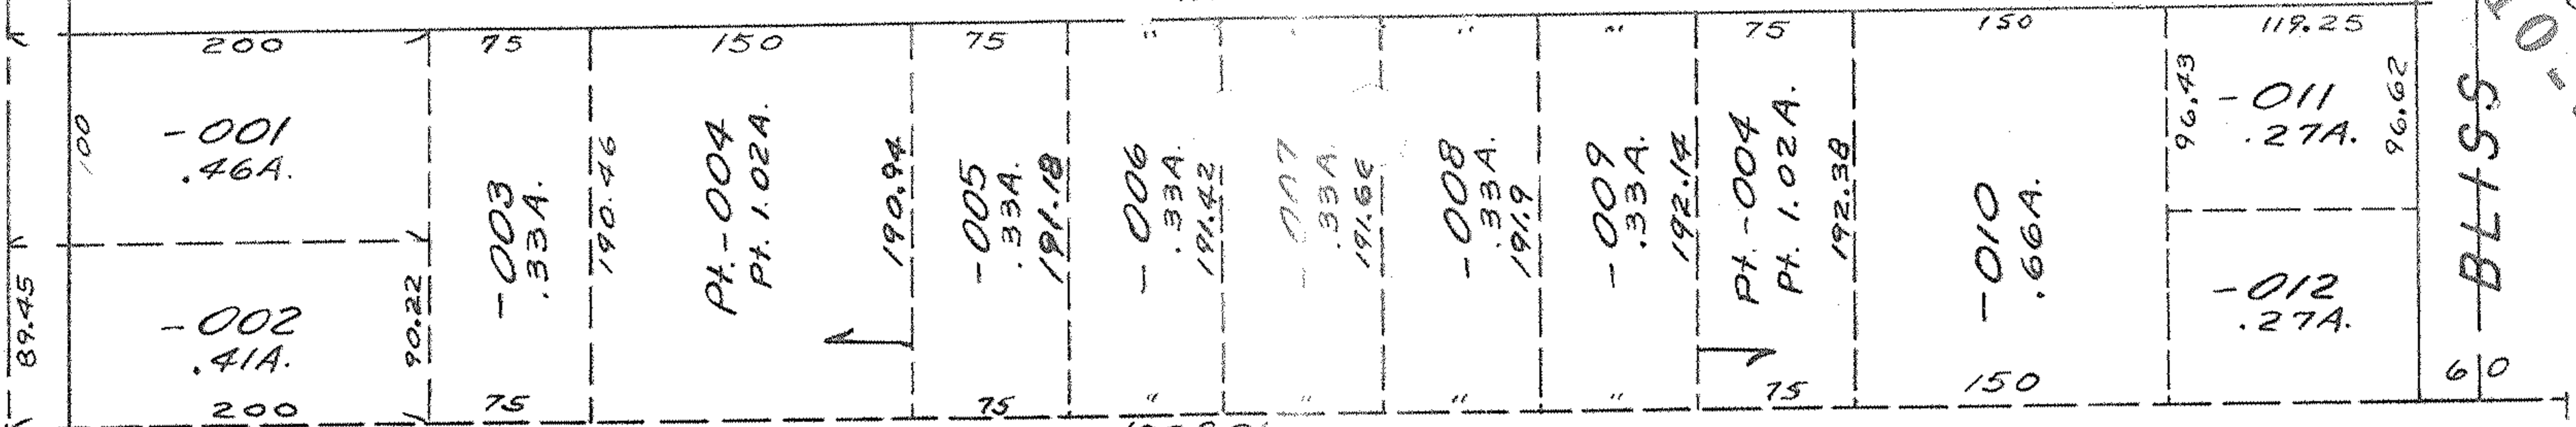

Nitsche, Ann Margaret 10/11/73

DV-382 Pg 415

-013 5.78A.

DV 1069 Pg 420

APPROVED
LORAIN CO.
MAP DEPT.

DATE 7/19/77

PAGE 4-00-026A

BY _____

VOID AFTER _____

-041

2.96 Ac

~~5.78A~~ W/out MEAS

040

2.82 A

1228.24

$$\frac{1228.24 \times 100}{824} = 2,819$$

$$\frac{1228.24}{43.56} = 28.19$$

-039 5.74 A.

Richards, Joan F.

11/5/75

Deed Vol 1135

Pg 917

103

1228.24

330
300

-038 .94 A.

SEE 4-00-026-P