


10-78

10731

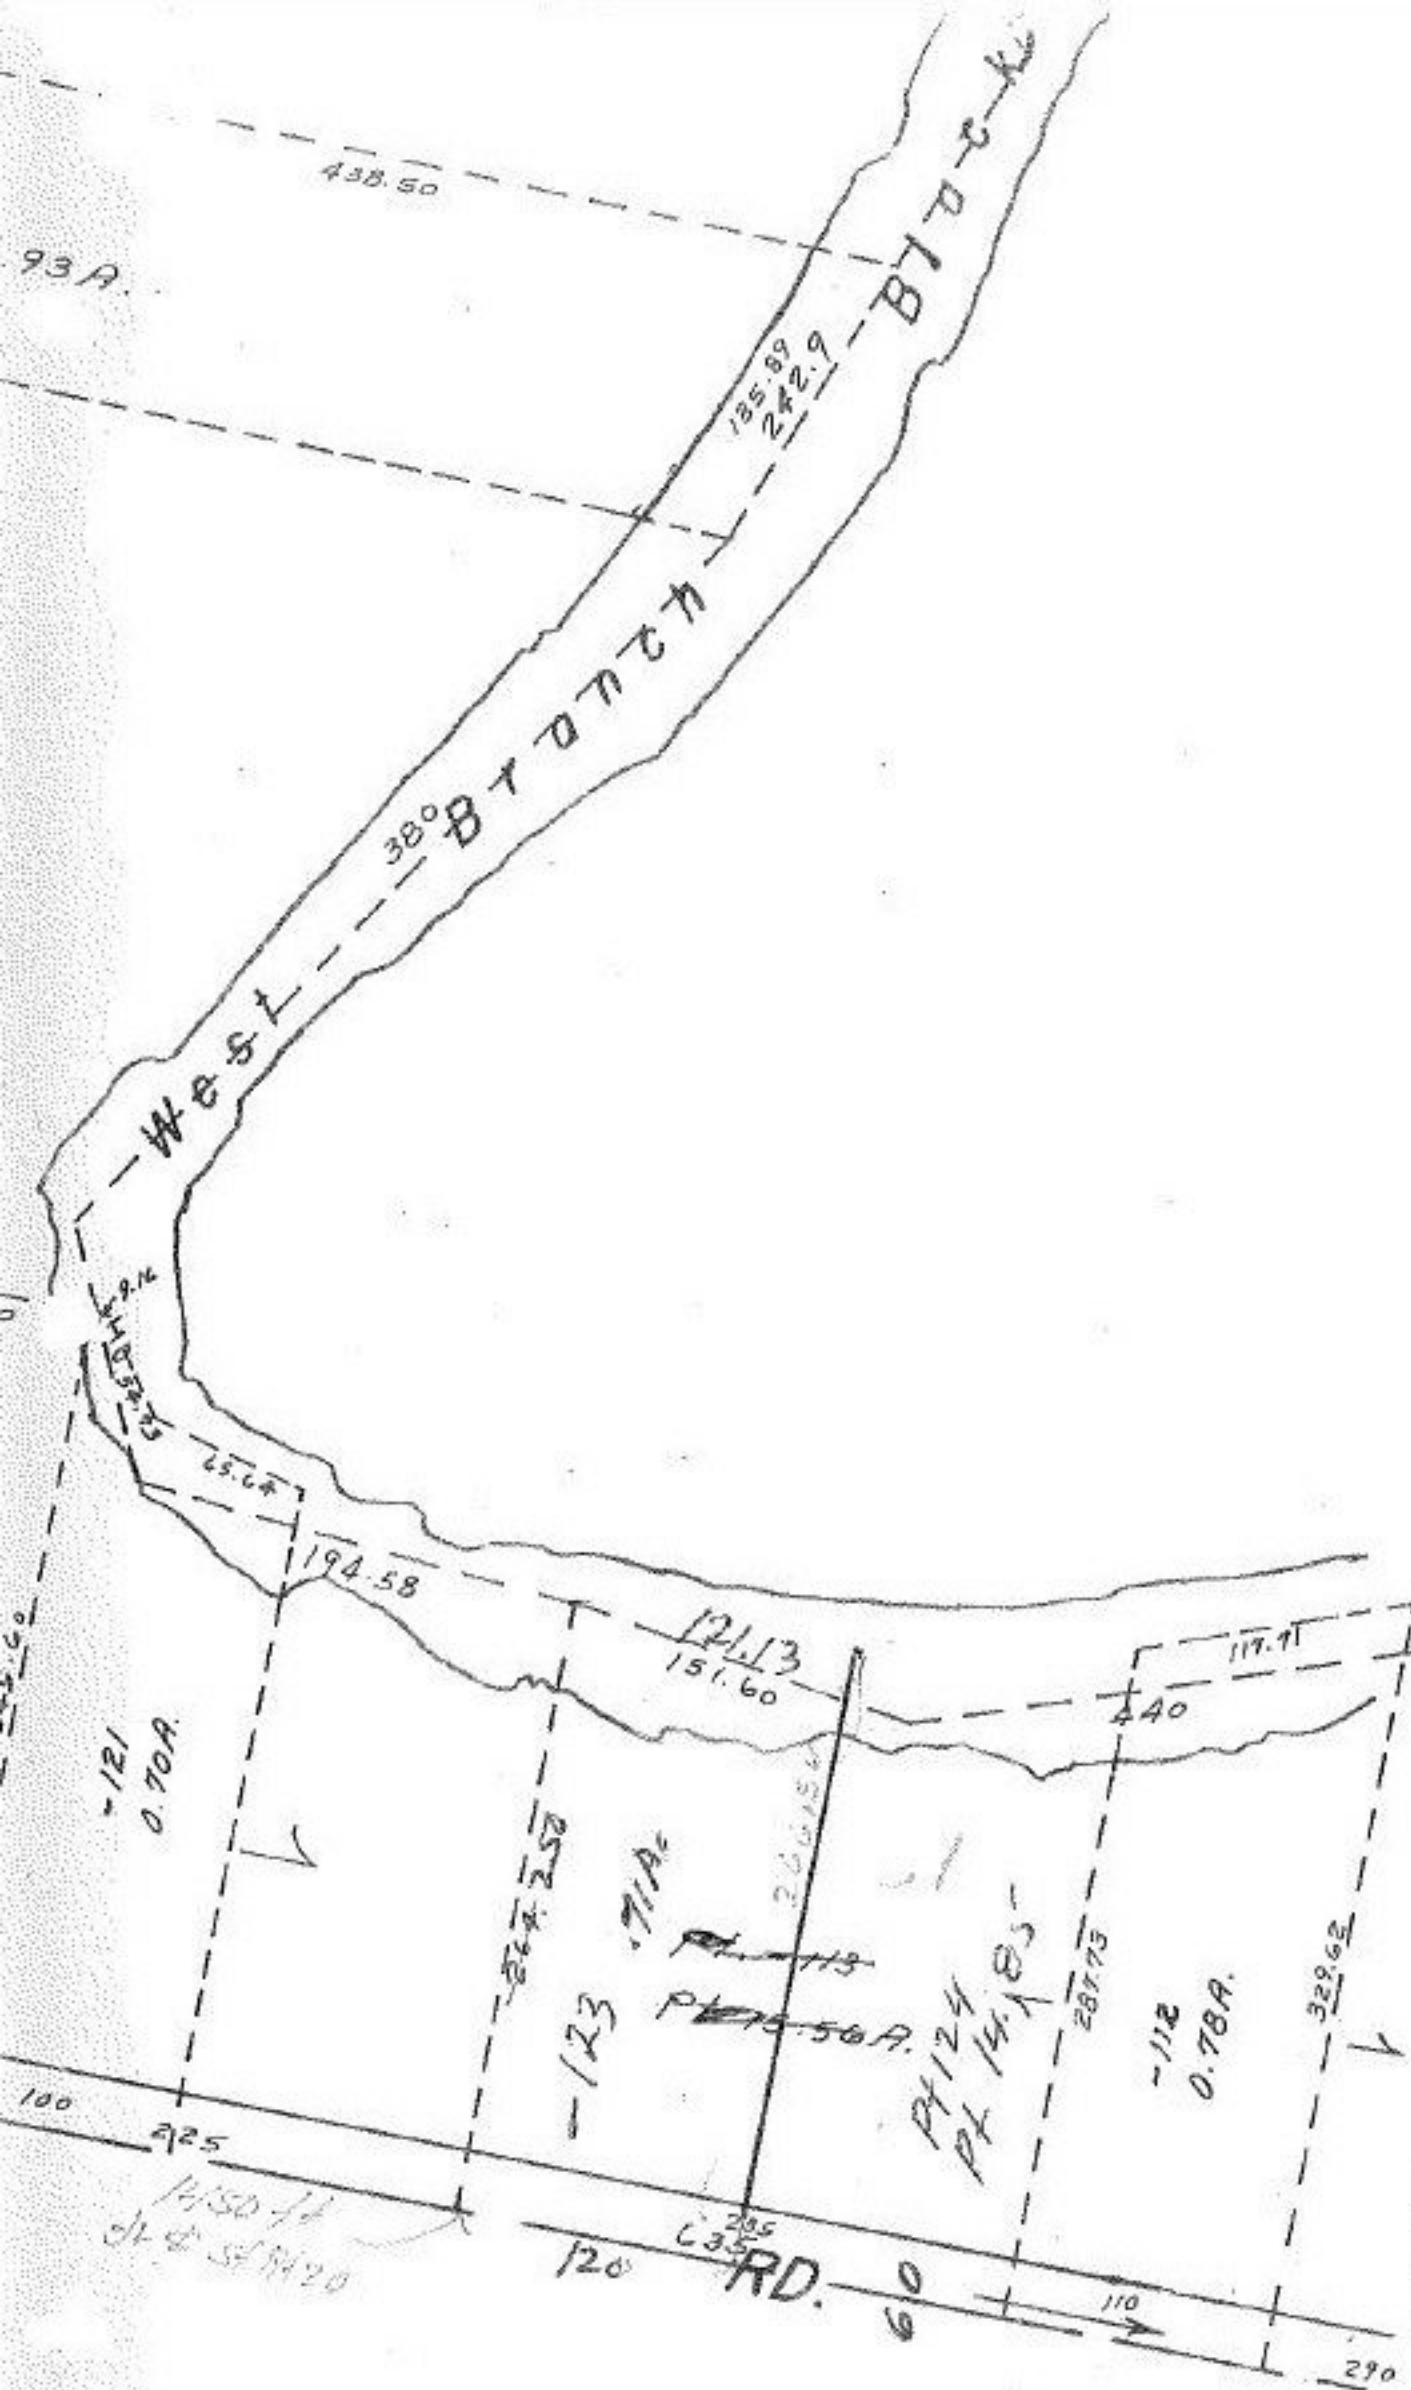

JUL 22 1977

10731

APPROVED LORAIN CO. MAP DEPT.	
DATE 7/13/77	8/12/77
PAGE 10-00-012/3 JC	
BY <i>LW</i>	
VOID AFTER	