


LAND - OBERLIN

10-78

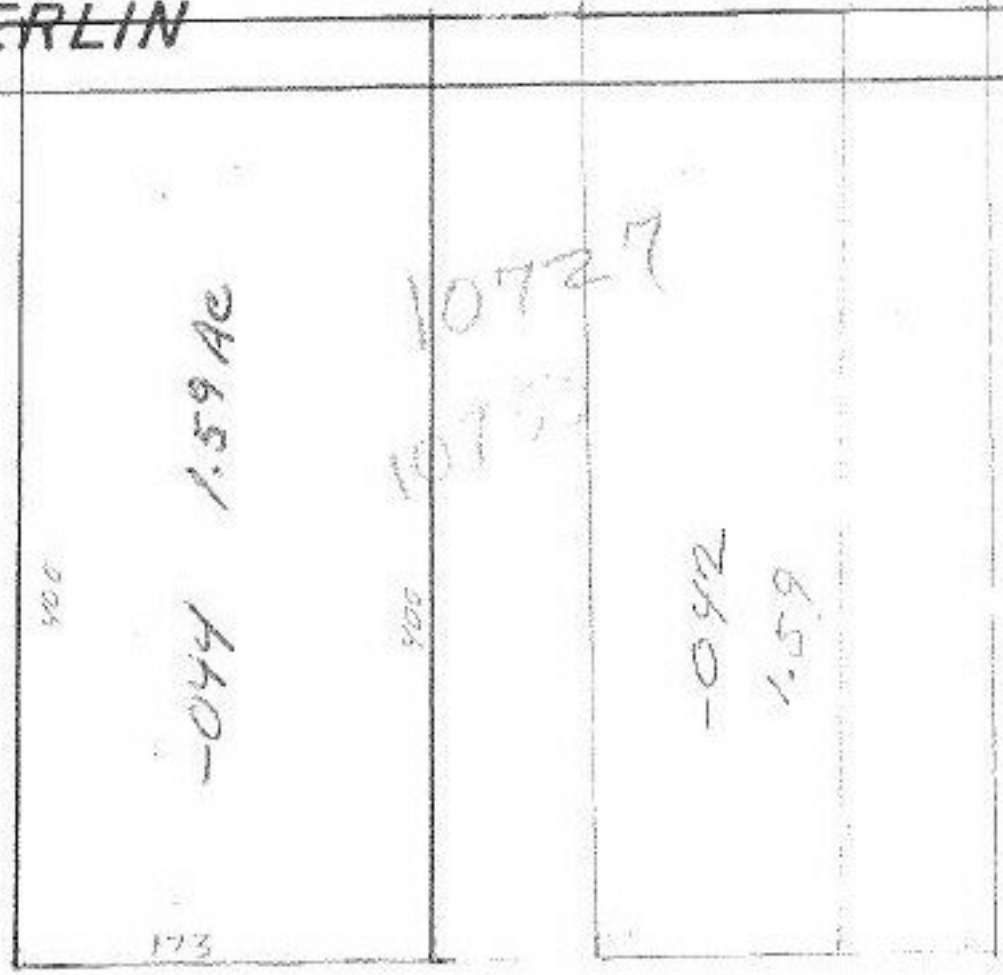

28
264
-006

10753

APPROVED LORAIN CO. MAP DEPT.	
DATE 7/21/77	
PAGE 9-00-089B	
BY L. W. Hall (T.M. J. Main)	
VOID AFTER	

JUL 22 1977

JA
8/25/77

~~032~~
38-78A

~~043~~
37-19

~~045~~
35.60

FL
75
P

4.12