


10784

SEE 9-H

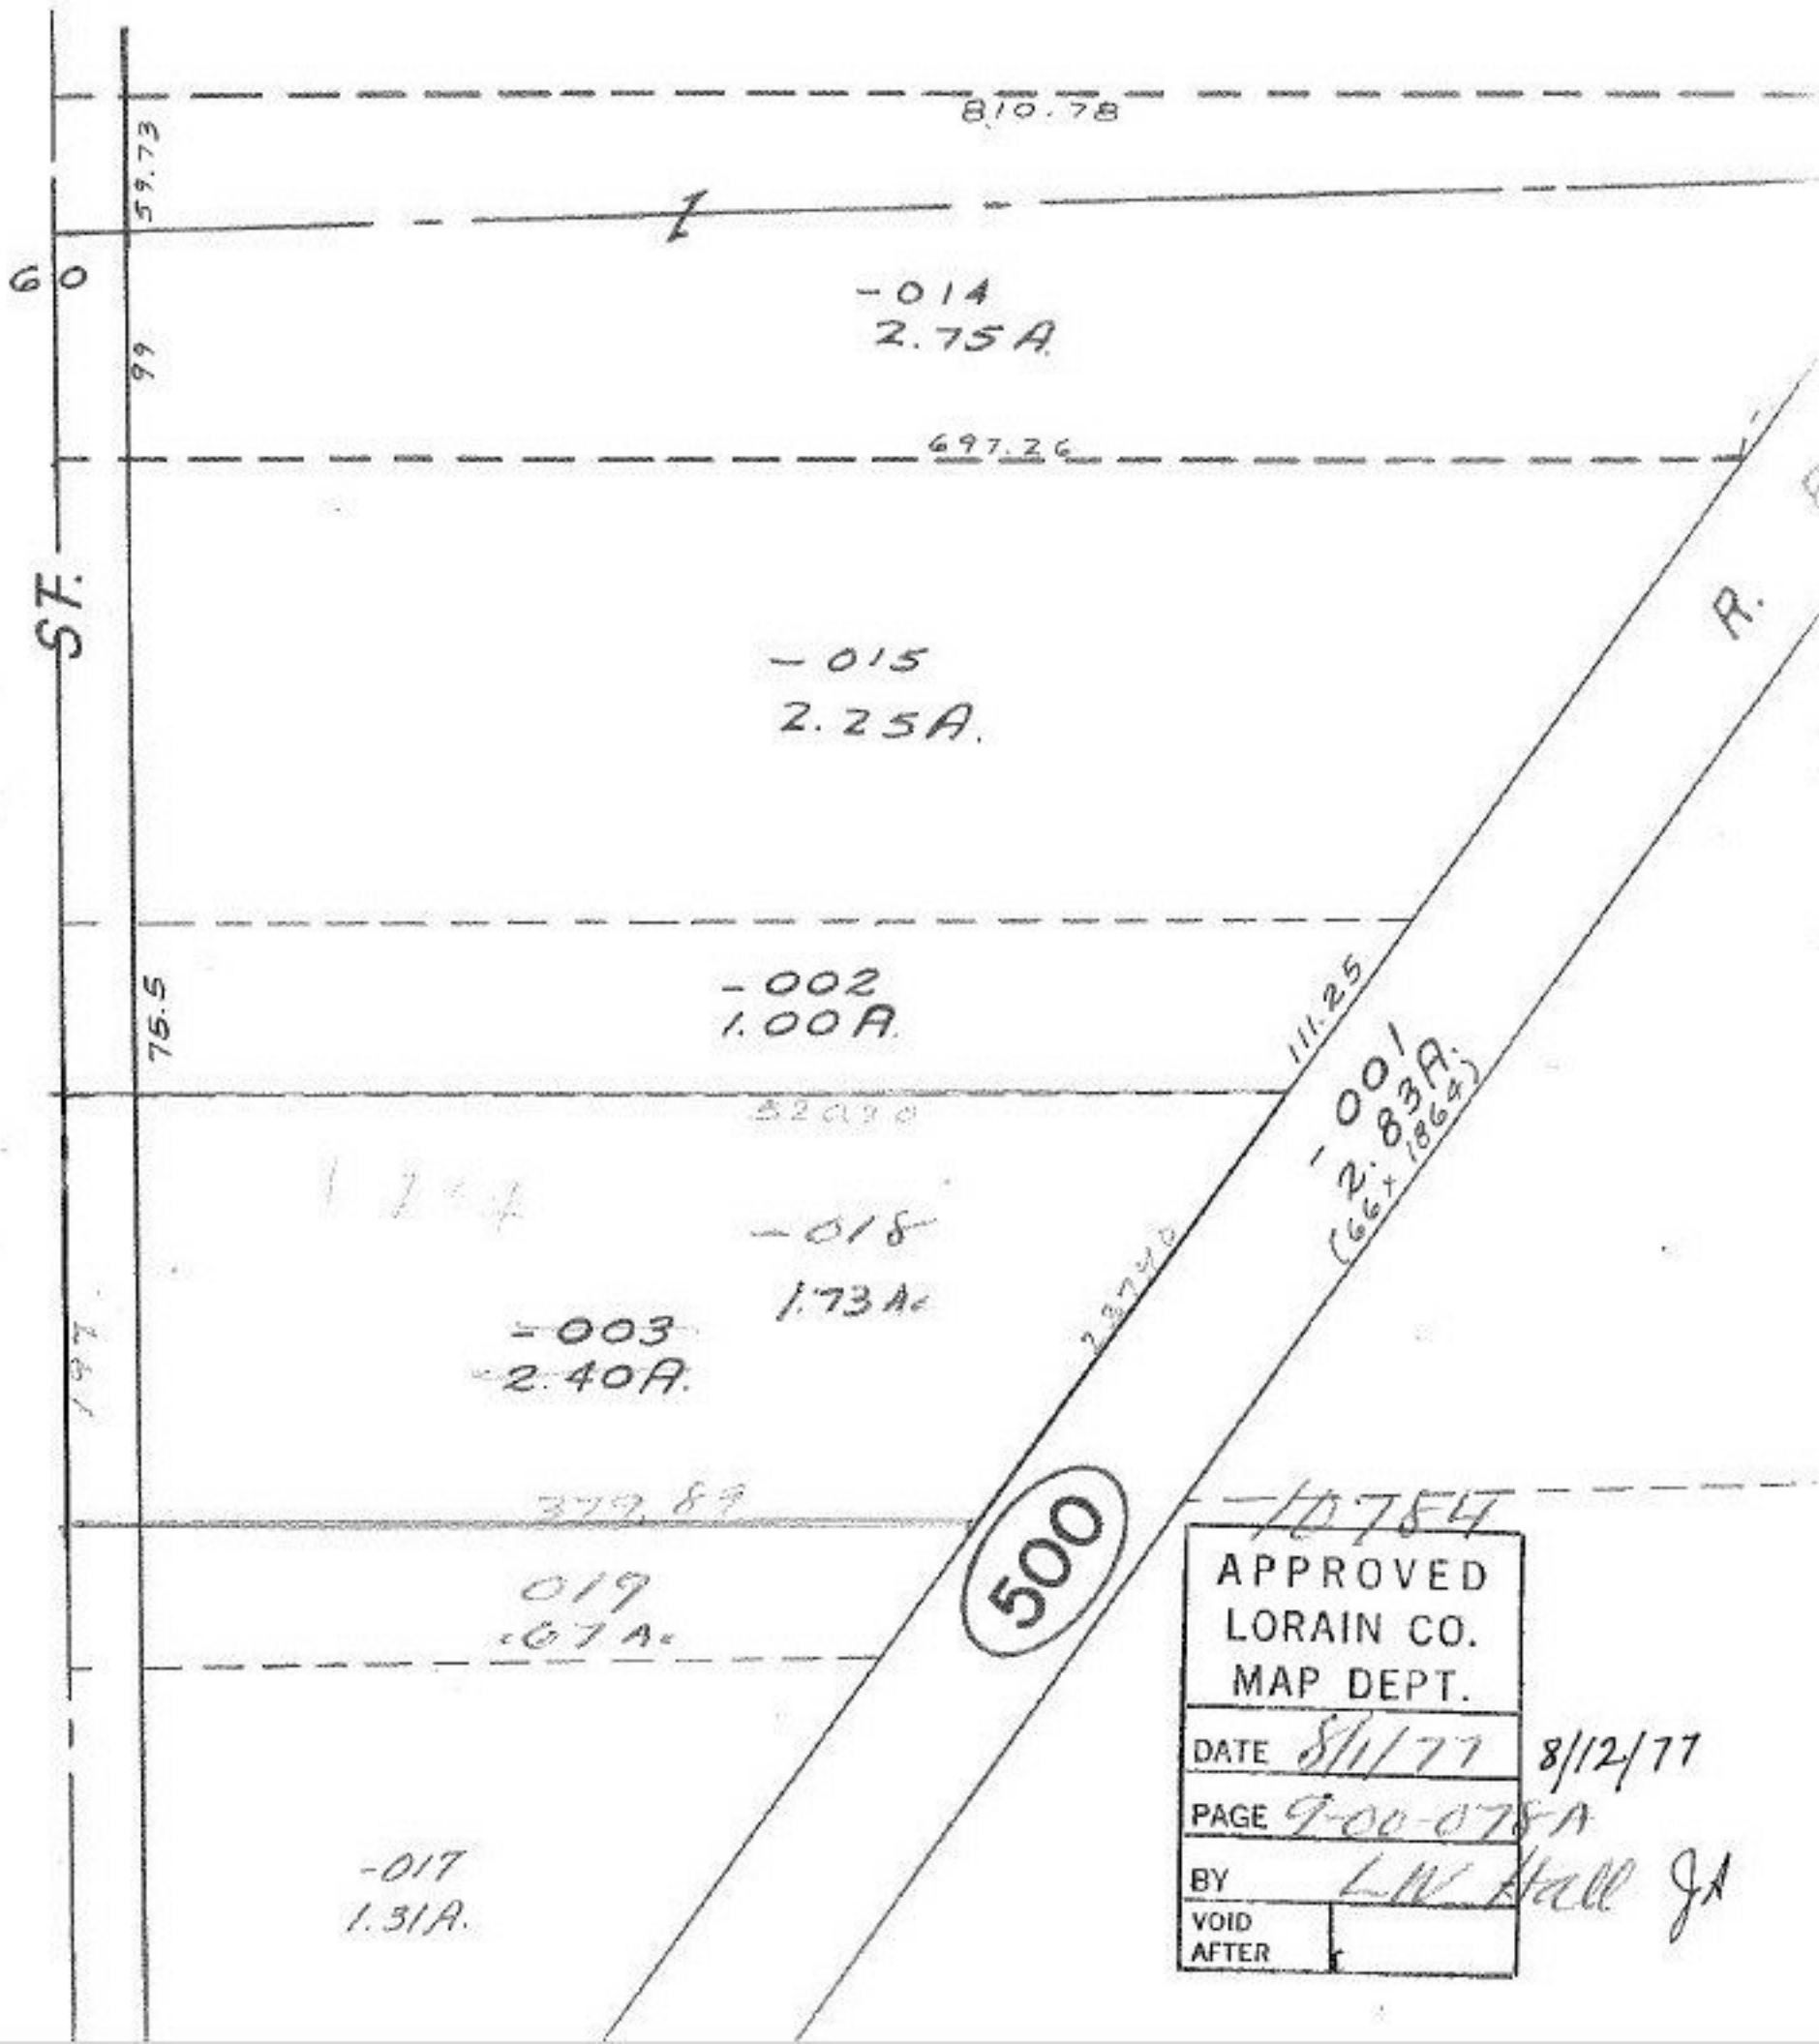

APPROVED LORAIN CO. MAP DEPT.	
DATE	8/1/77 8/12/77
PAGE	9-00-078A
BY	L.W. Hall JA
VOID AFTER	