


10-502  
10-502

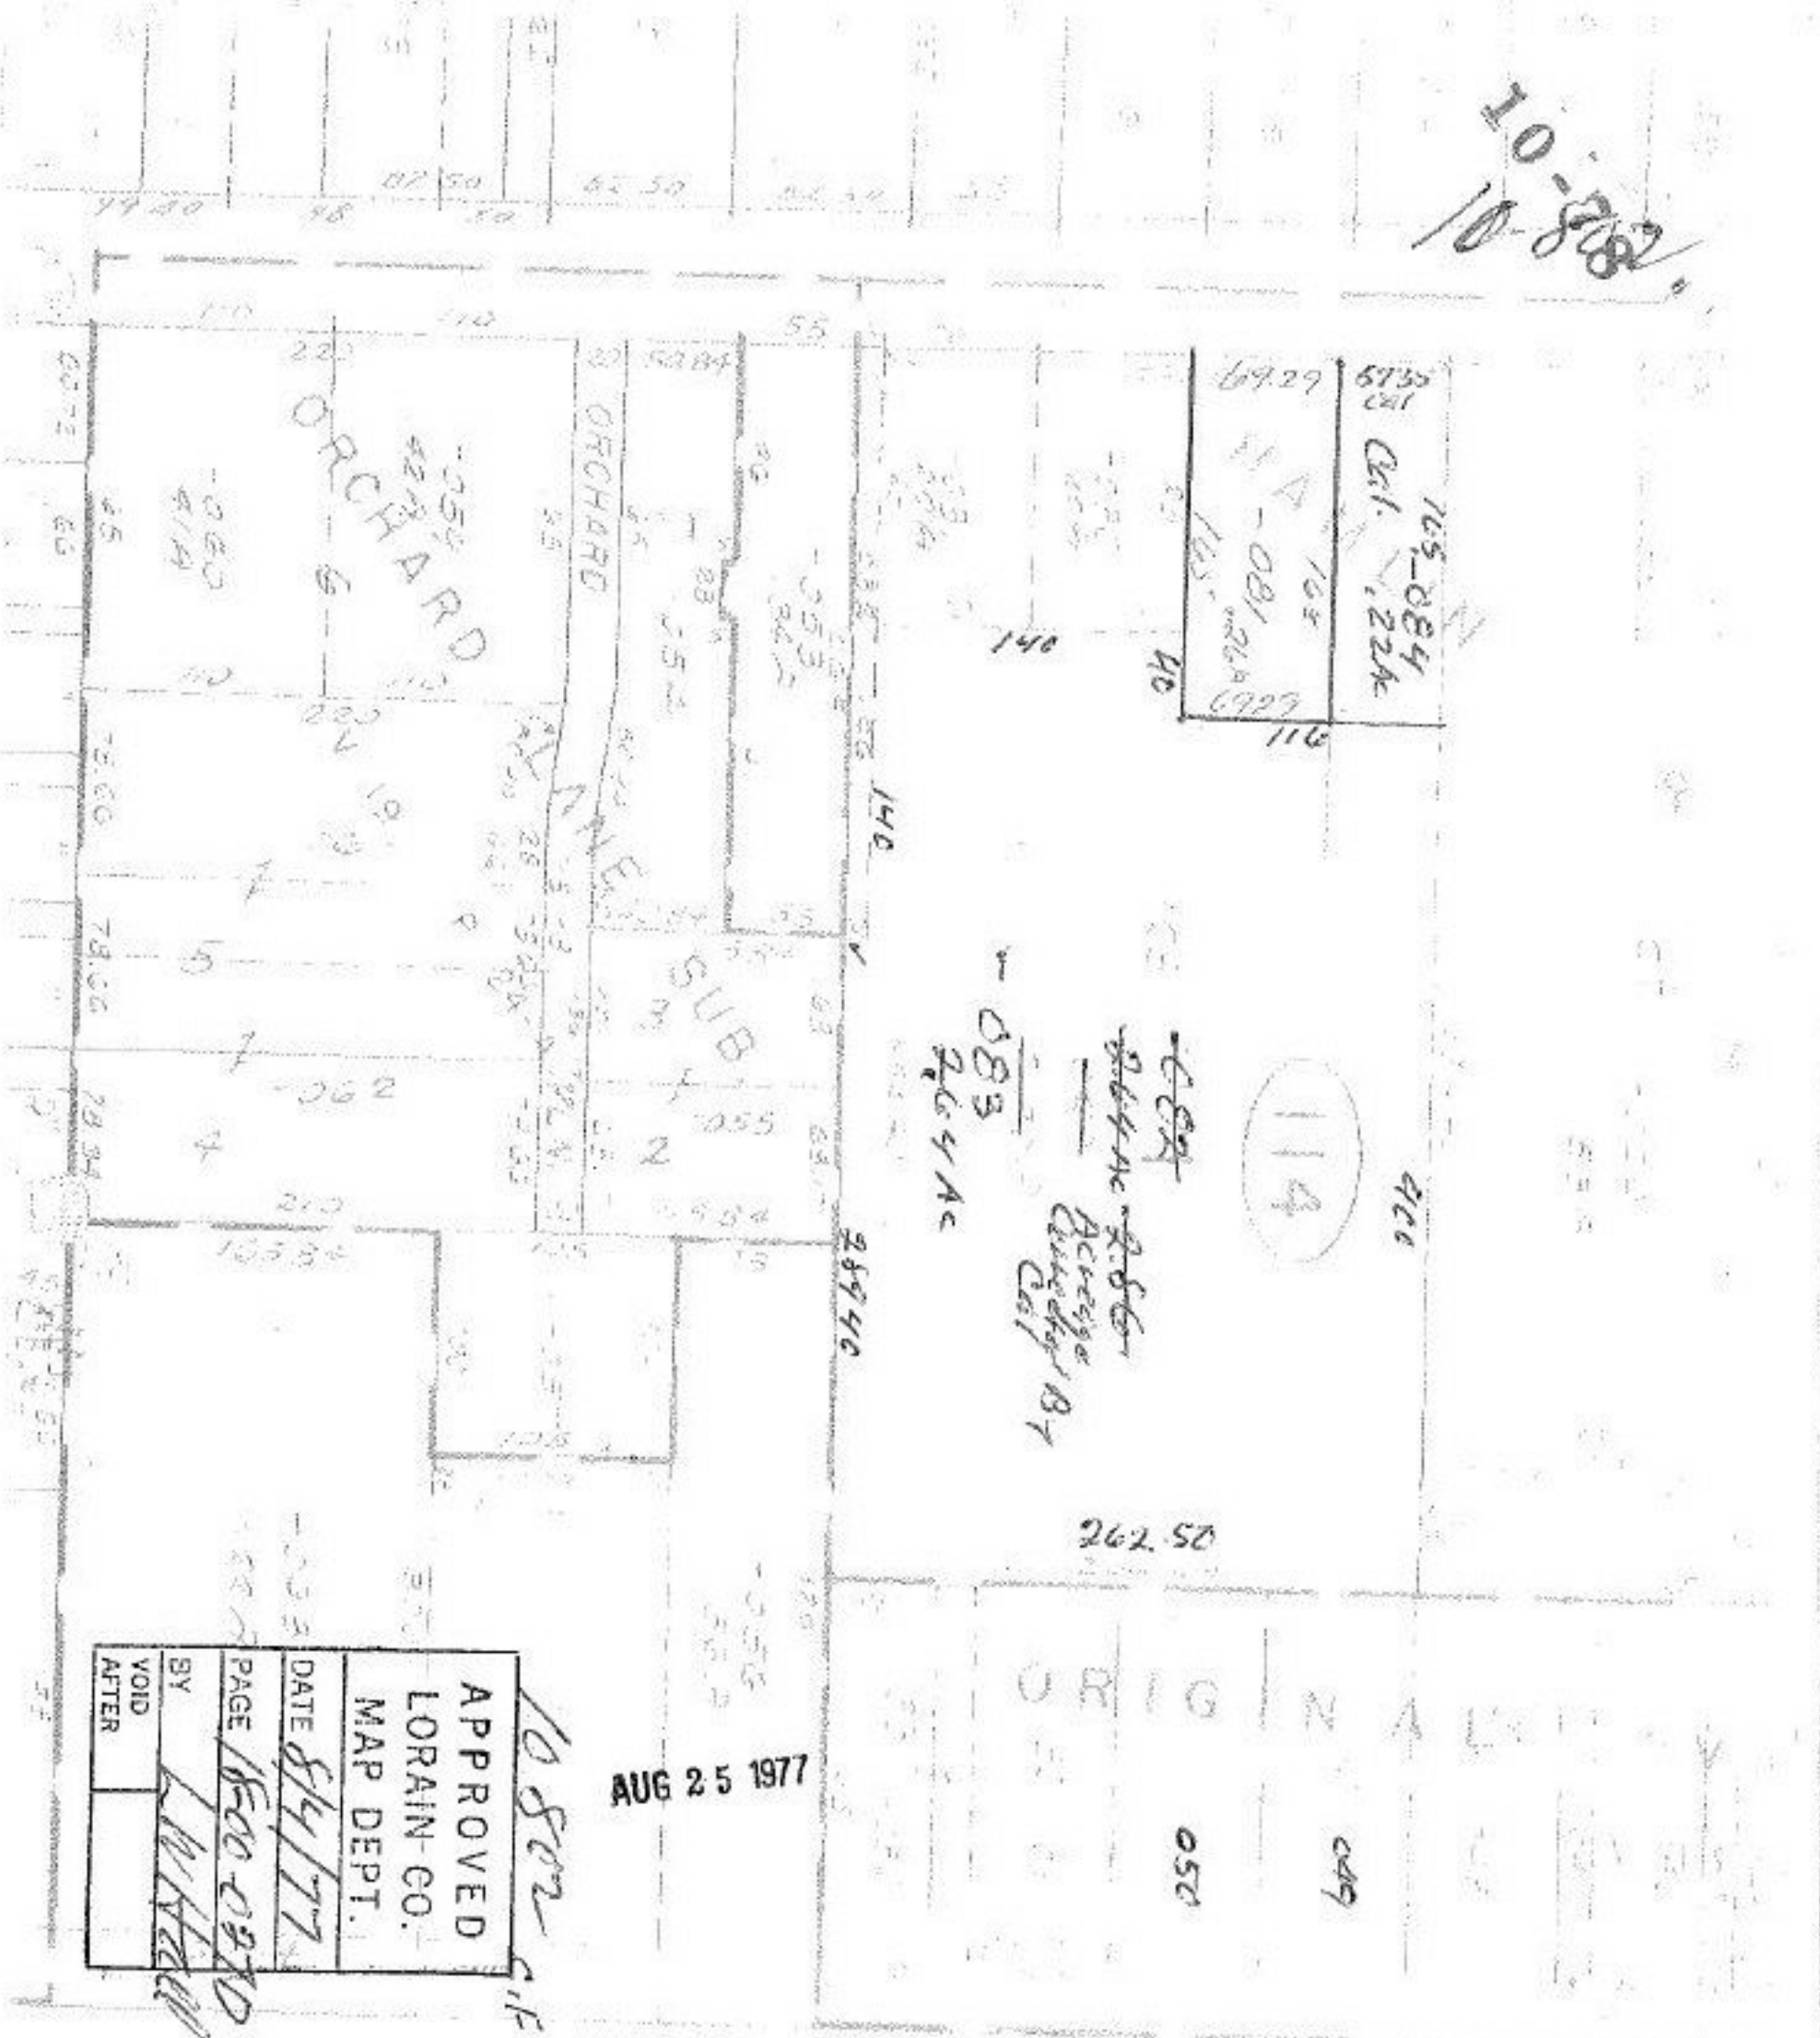

APPROVED	10-502
LORAIN-CO.	C.F.
MAP DEPT.	
DATE	8/4/77
PAGE	1500-0220
BY	[Signature]
VOID	
ALTER	

AUG 25 1977

SEP 18 00-022 0