
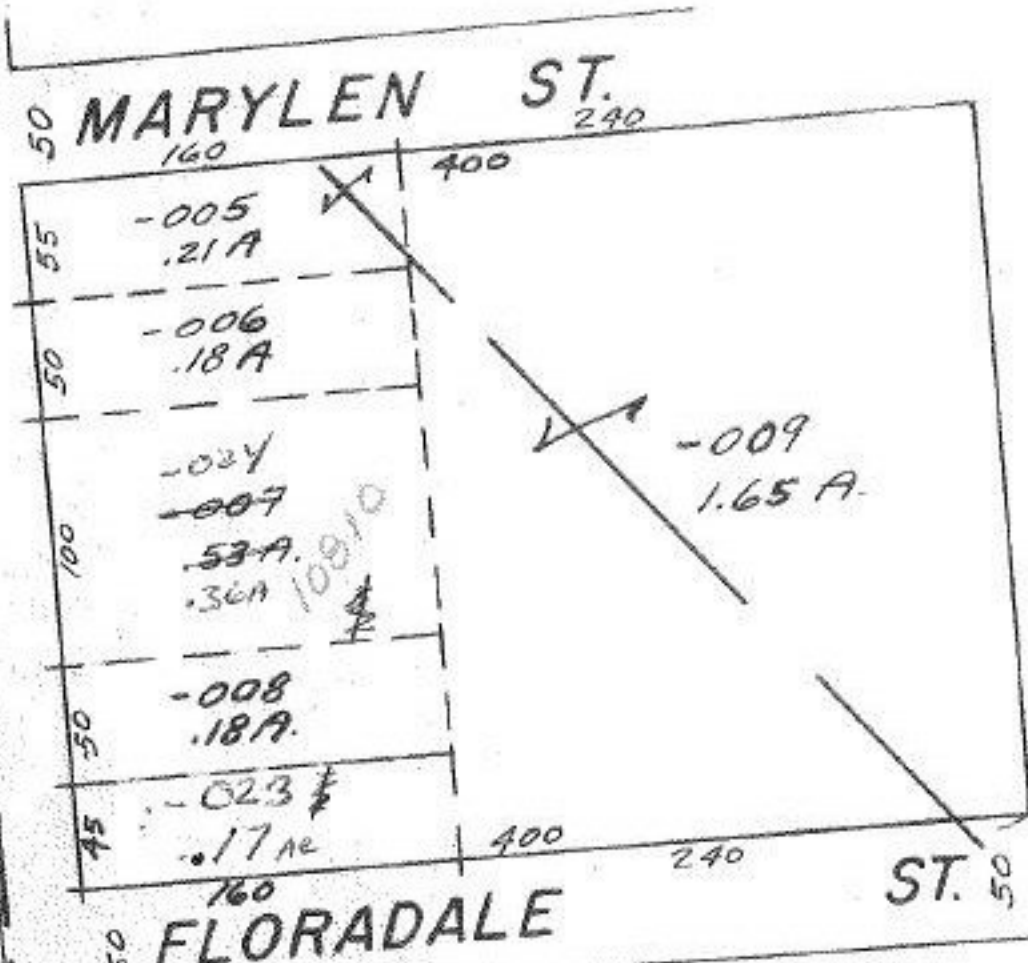


10810

10-28

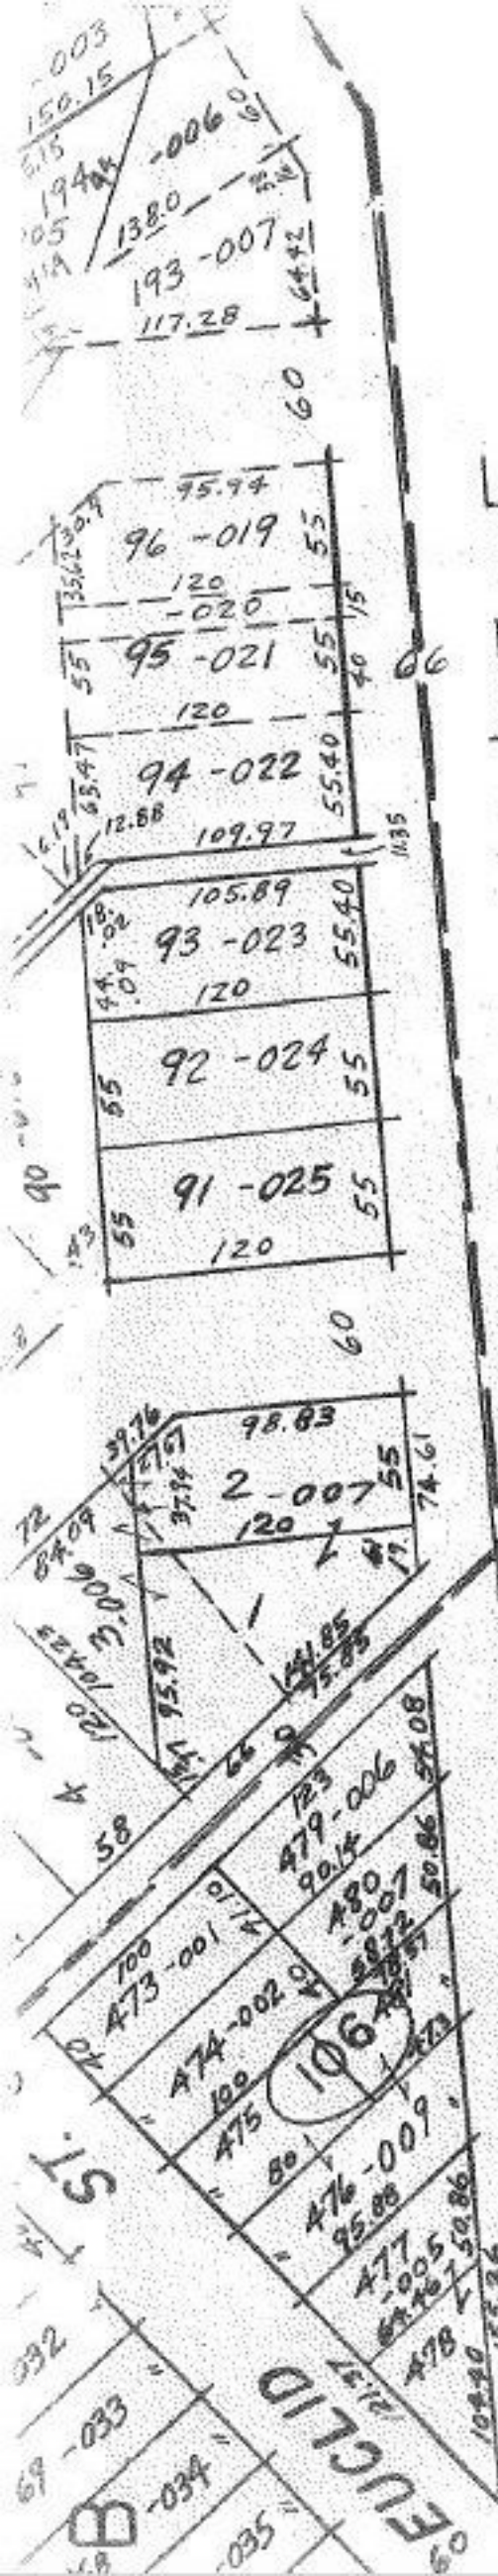

10810 C.F. 8-25-77
 APPROVED LORAIN CO. MAP DEPT. AUG 24 1977
 DATE 8/5/77
 PAGE 6-83
 BY L.W. Hall
 VOID AFTER

EUCLID ST.

MARYLEN ST.

FLORADALE ST.