


11821

82-101

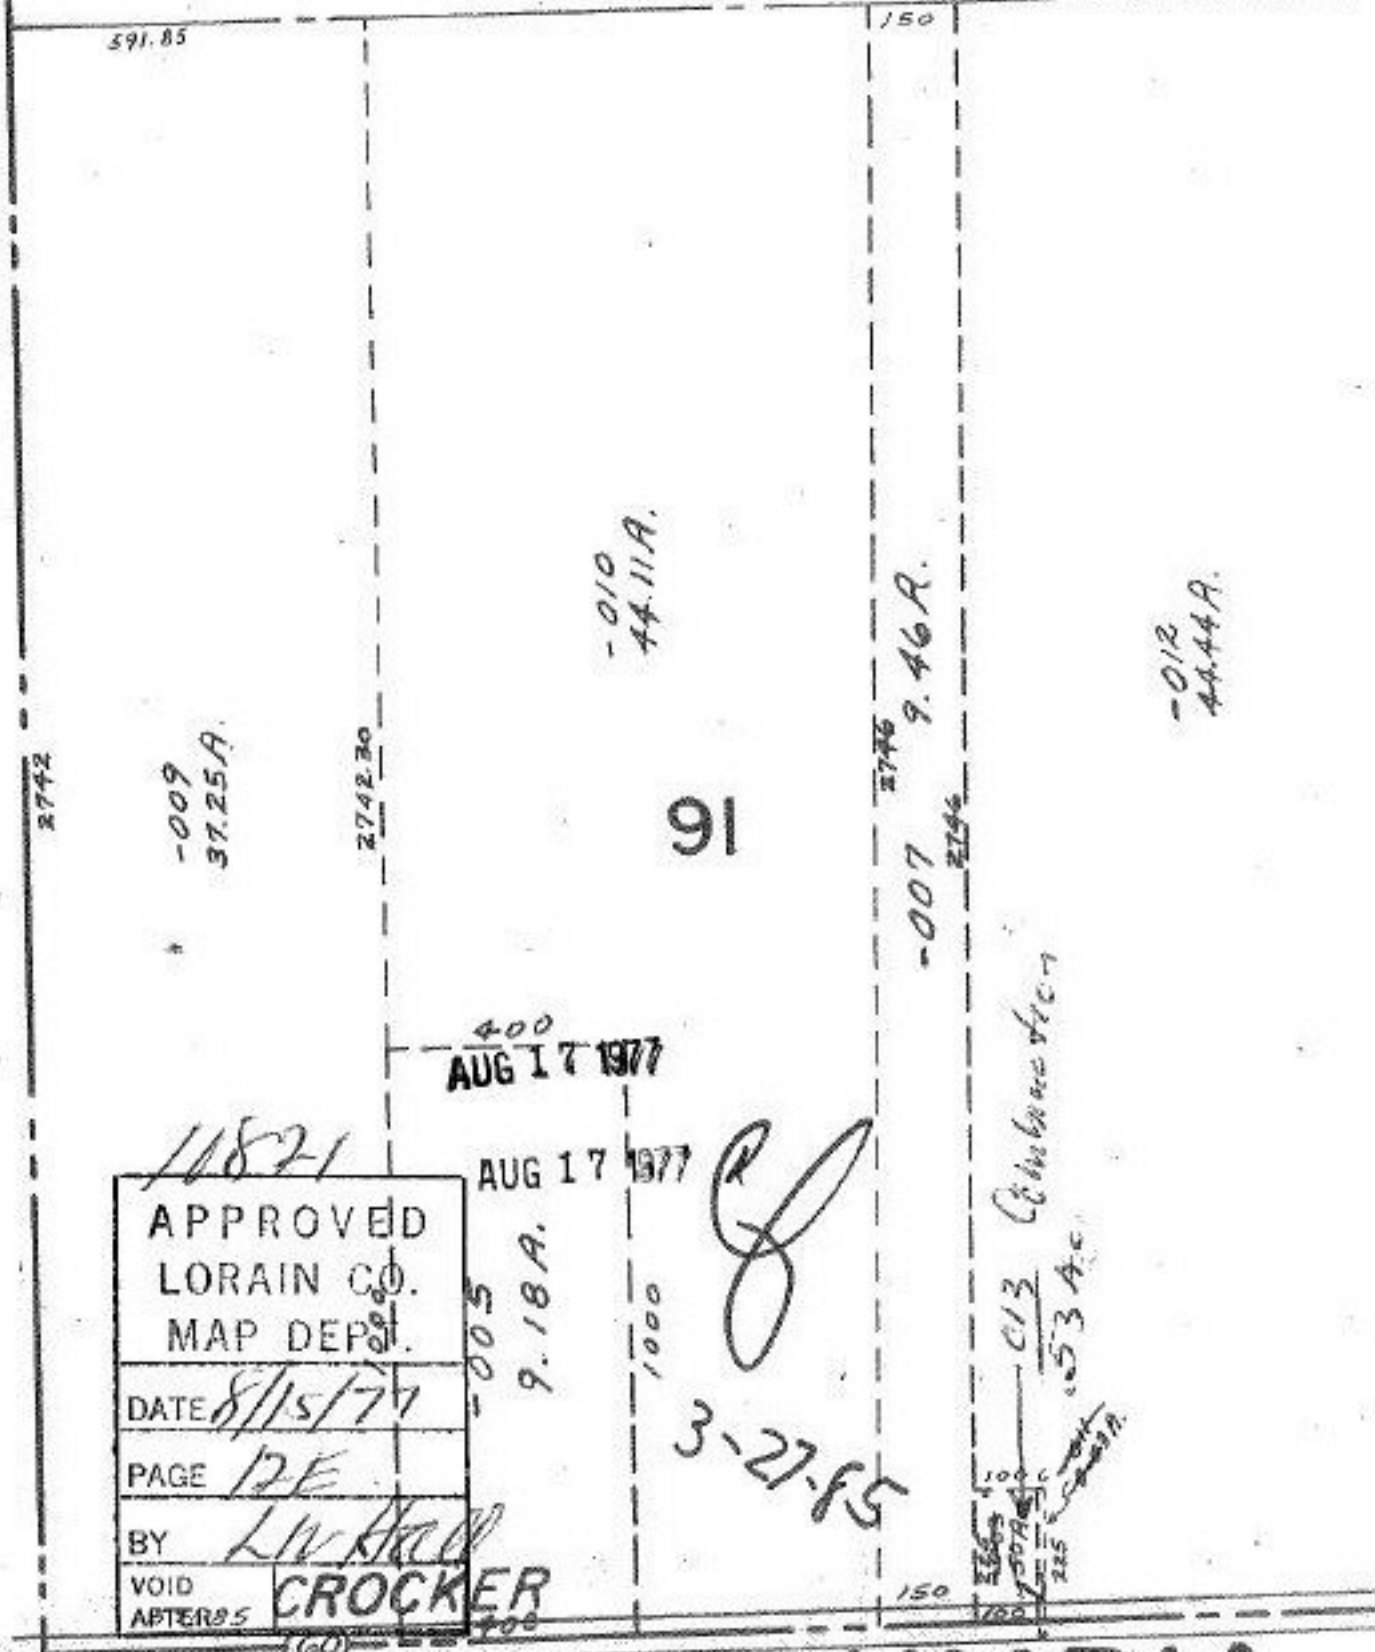

copyright 1962
7-19-77

12-E

COLUMBIA