


IA TWP.

SCALE: 1" = 400'

LOTS 51 THRU 55, 66

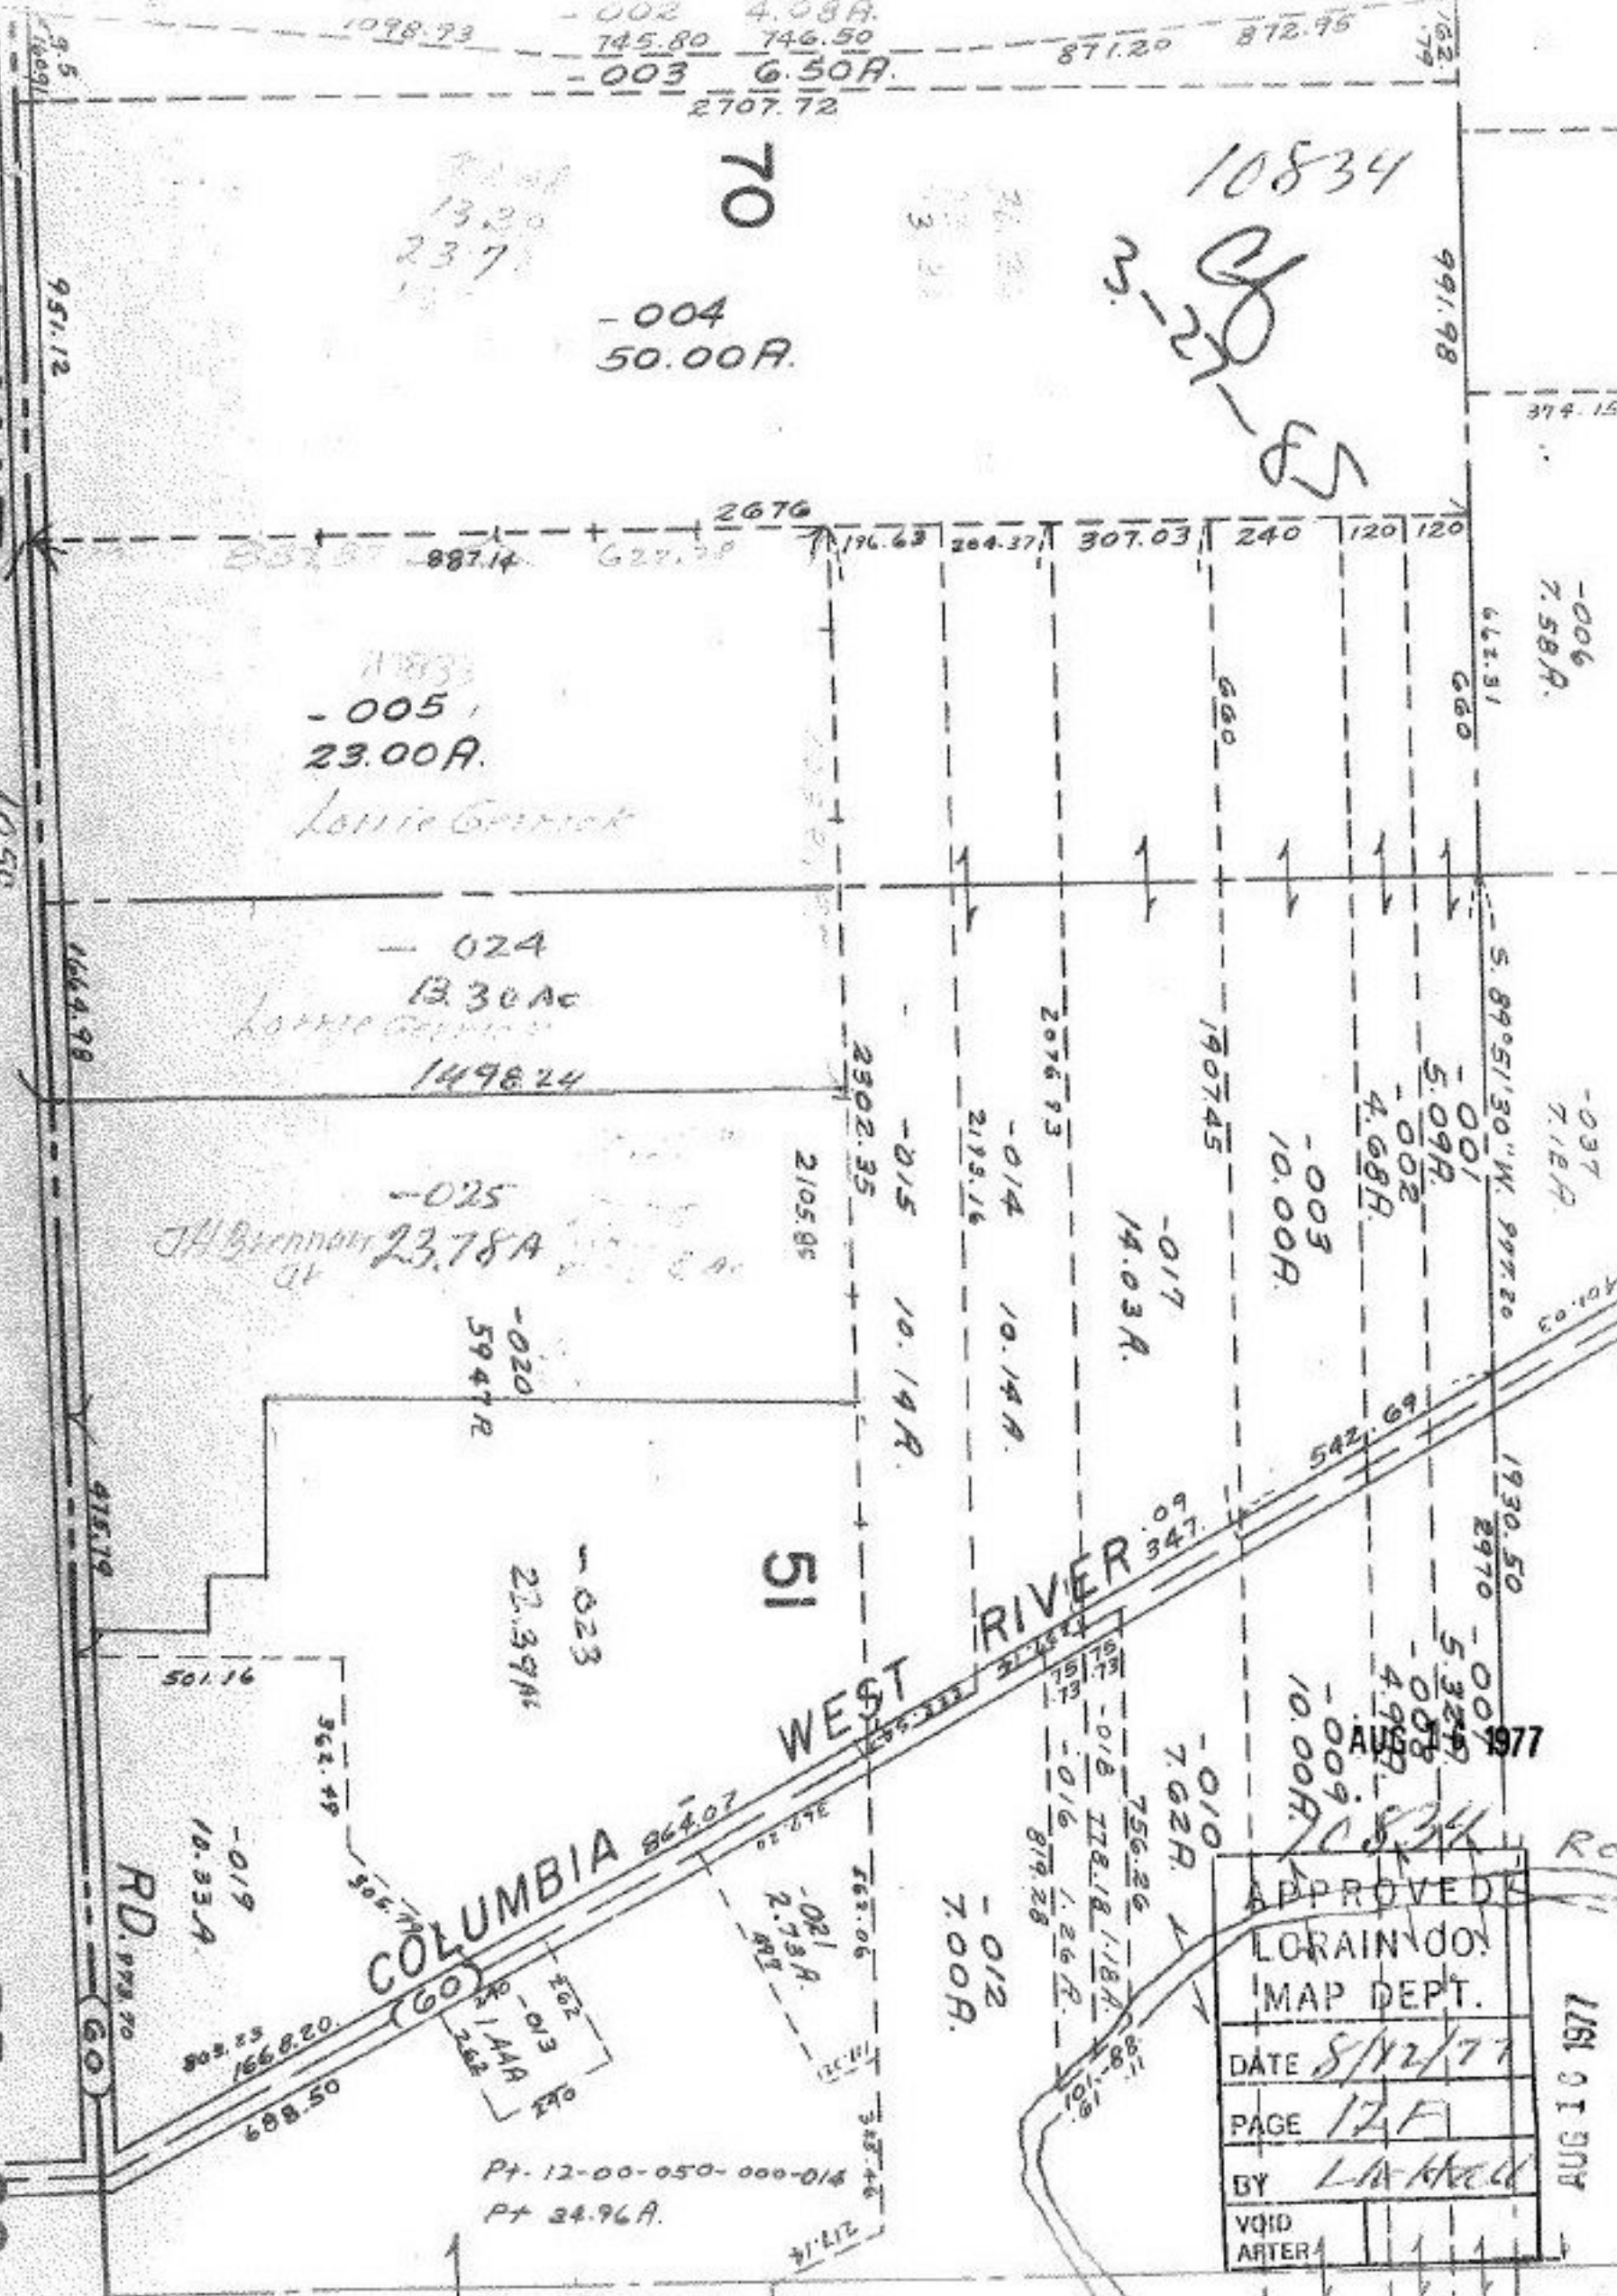

10834
[Handwritten signature]

11833
 -005
 23.00A.
Louise G. [unclear]

-024
 13.30Ac
Louise G. [unclear]
 1498.24

-025
 23.78A
J.A. Brennan

-023
 22.39Ac

-019
 18.33A

-012
 7.00A

APPROVED	
LORAIN DOY	
MAP DEPT.	
DATE	8/12/77
PAGE	12A
BY	L.A. [unclear]
VOID	
ARTER	

Pt. 12-00-050-000-014
 Pt 34.96A.

AUG 10 1977