


-004

10851
10-18-77

T
R
A
C

-003
64.06 A.

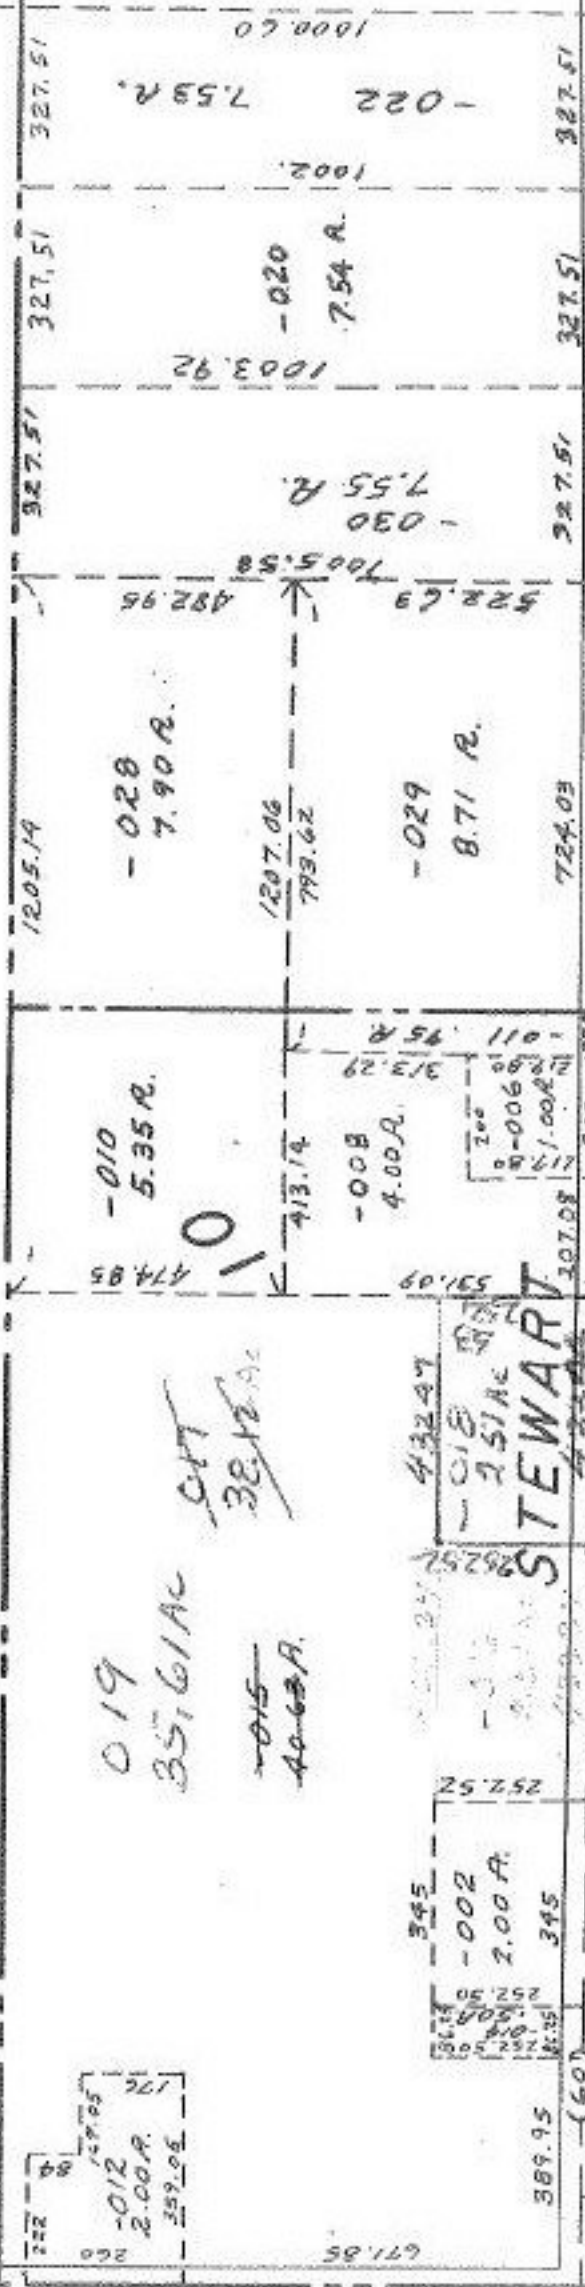

-005
52.00 A.

10851 C.7

APPROVED	
LORAIN CO.	
MAP DEPT.	
DATE	8/17/77
PAGE	216
BY	LW HAW
VOID	
AFTER	

AUG 17 1977

80