

10852

RD.

161.59
1.004
0.32
270
161.89
384.90
1663.04
325.79

~~033~~
56.57A
035
55.12 AC

987.92
270.08
4.29 AC
-024
556.70
-026 1.40 A.
513.52

19.04 A.
-031

1035.85

PEASELEY

SEP 1 1977

APPROVED
LORAIN CO.
MAP DEPT.

DATE 8/17/77


PAGE 15

BY L.W. HARR

VOID AFTER

-008
46.23A.

1402.50
9/6/77

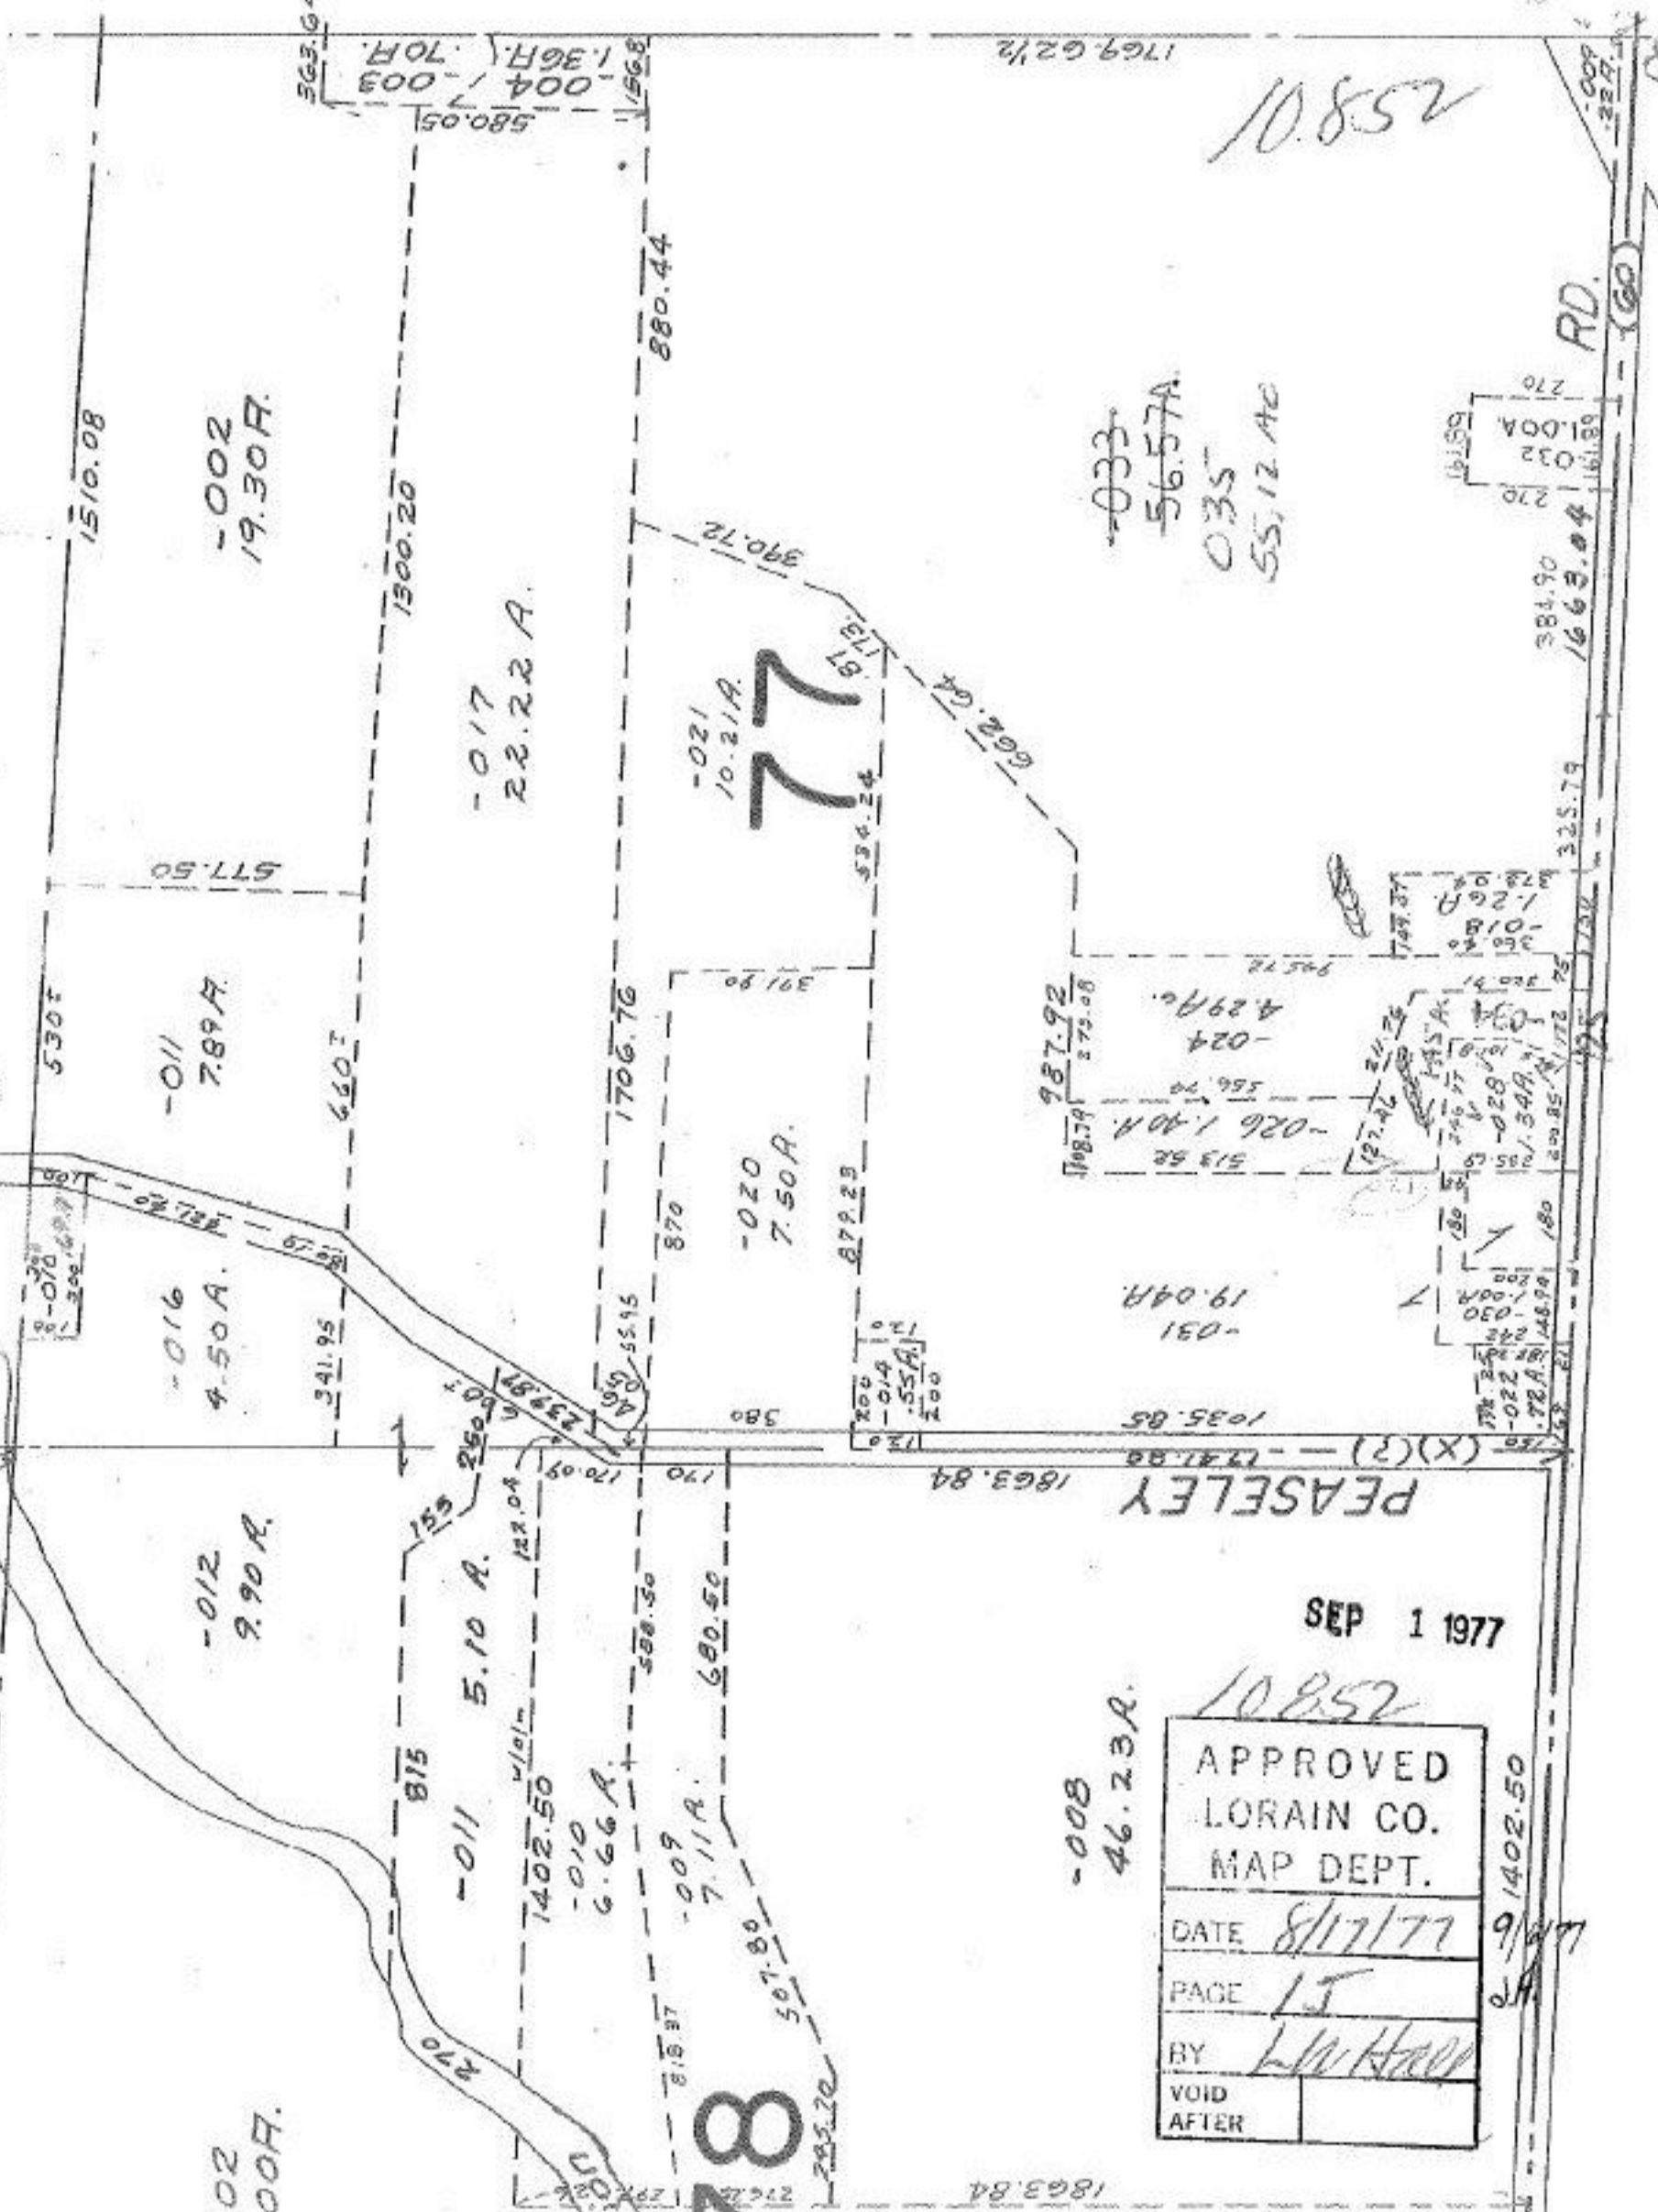

-002
19.30A.

-011
7.89A.

-016
4.50A.

-012
9.90A.

-017
22.22A.

-020
7.50A.

-021
10.21A.

-010
6.66A.

-009
7.11A.

-031
19.04A.

-024
4.29A.

-026
1.40A.

002
4.00A.

78

77

10852

1769.62 1/2

580.05
1.36A.
1.70A.
563.64

1510.08

1300.20

880.44

390.72

173

534.24

301.90

870

580

170

588.50

680.50

507.80

285.20

270.20

1863.84

1863.84

1035.85

19.04 A.

513.52

987.92

270.08

4.29 AC

556.70

-026 1.40 A.

513.52

19.04 A.

1035.85

127.22

211.25

145.5 A.

120.90

1.20 A.

130.00

179.37

195.72

170

170

