


SEE 5-00-060-B 254

POSTER - PARK 300 160 RD. 044 15Ac

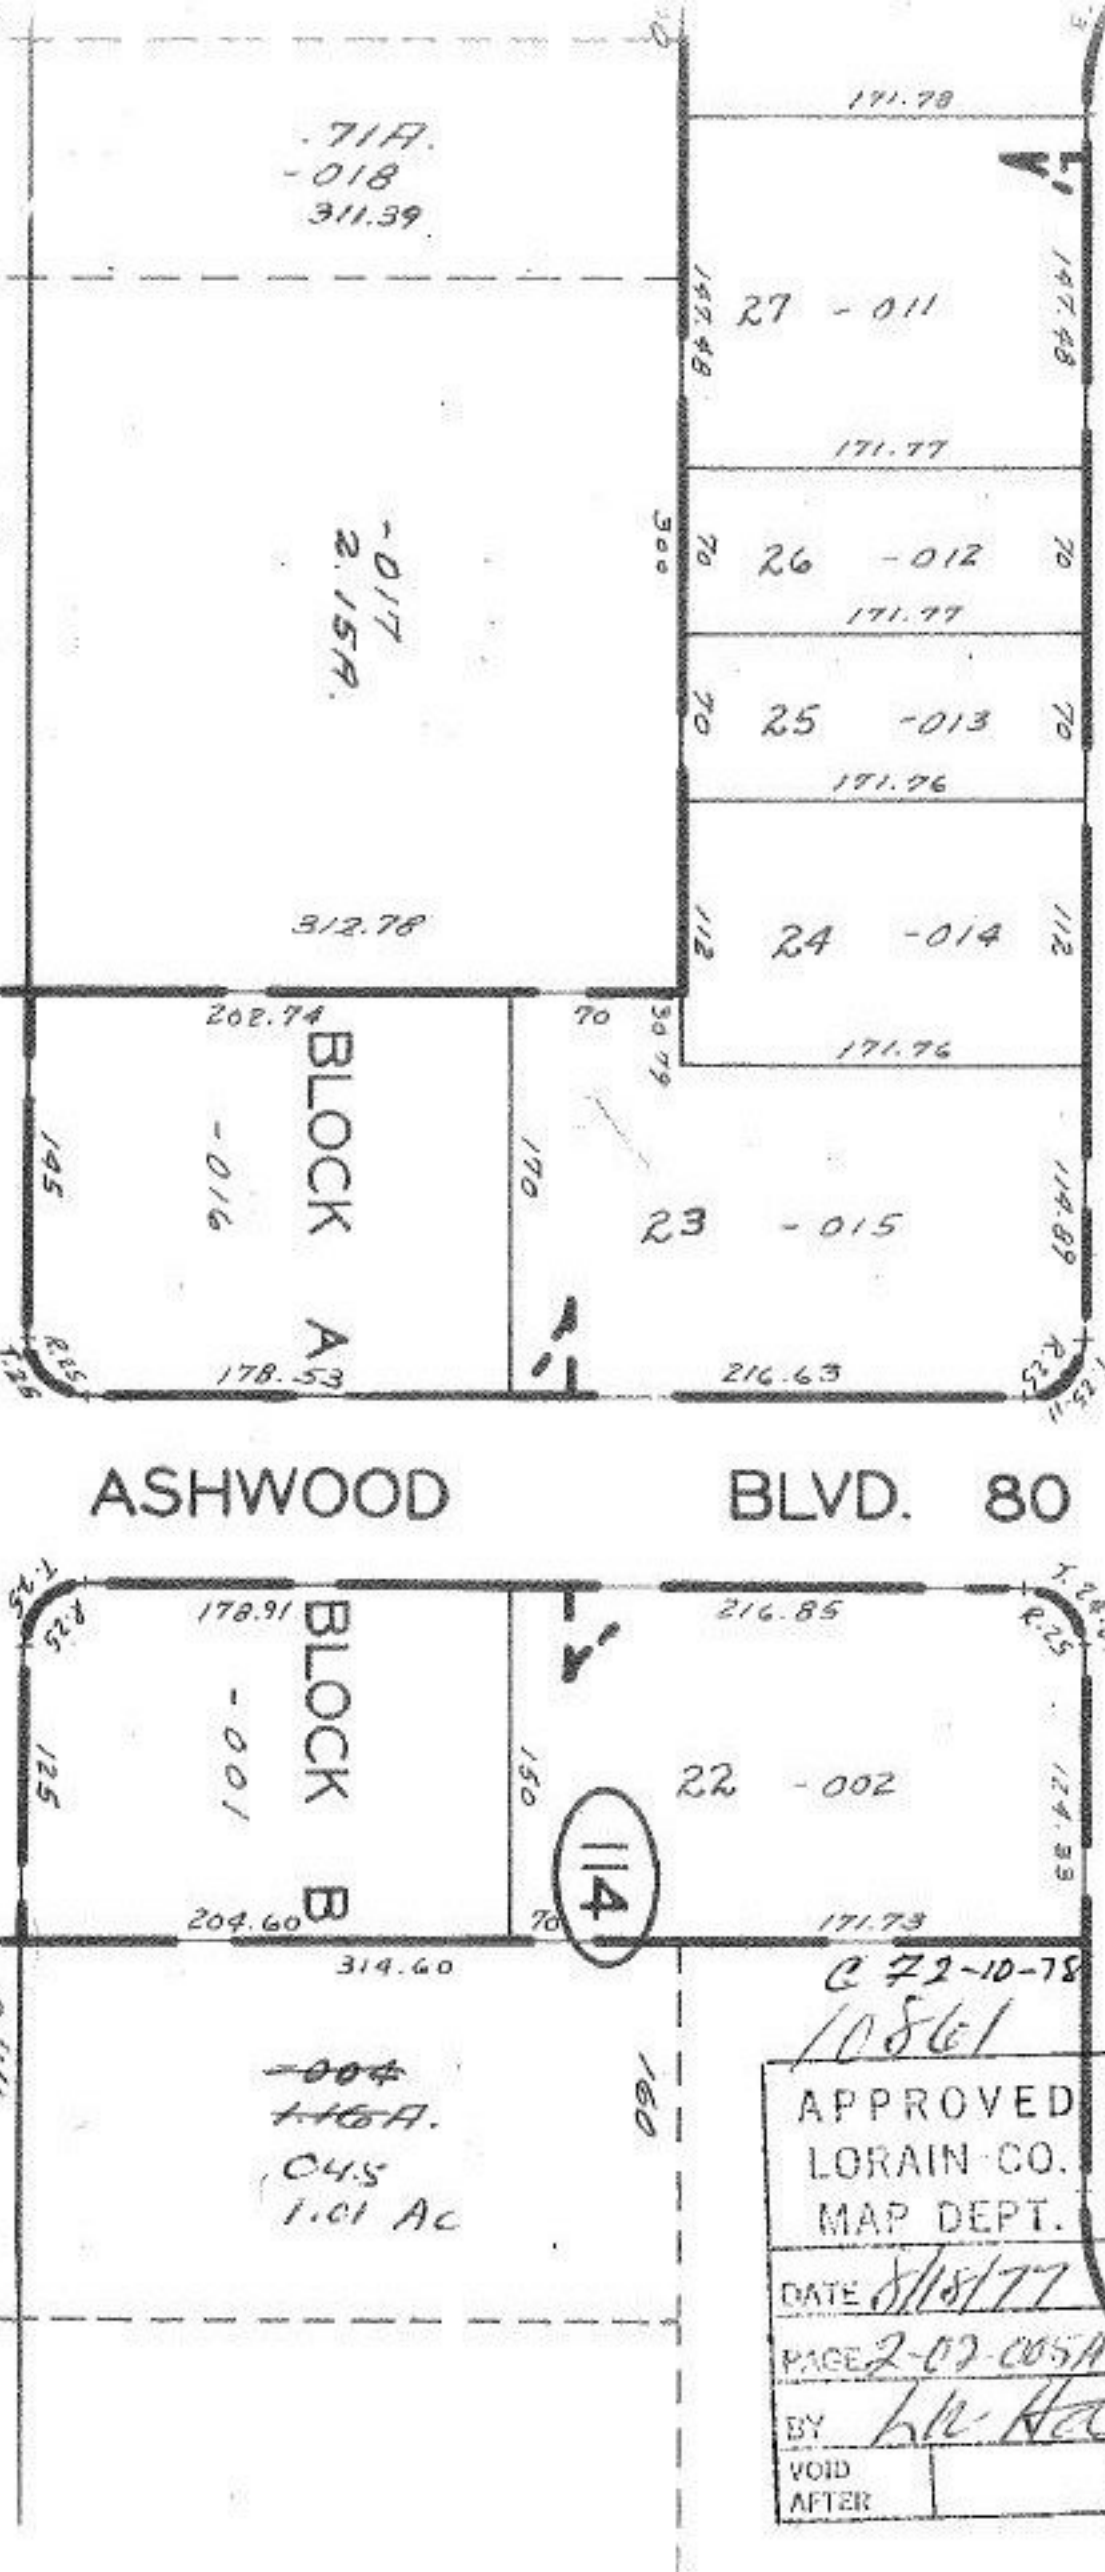

71A.
-018
311.39

-017
2.15A.

312.78

202.74
-016
178.53

ASHWOOD BLVD. 80

178.91
-001
204.60

~~004~~
1.16A.
045
1.01 Ac

27 - 011

26 - 012

25 - 013

24 - 014


23 - 015

22 - 002

APPROVED
LORAIN CO.
MAP DEPT.

DATE 8/18/77
PAGE 2-02-005A
BY *h. h. Hall*
VOID AFTER

HERBERT VOL. 27 PG. 61 DR. 60

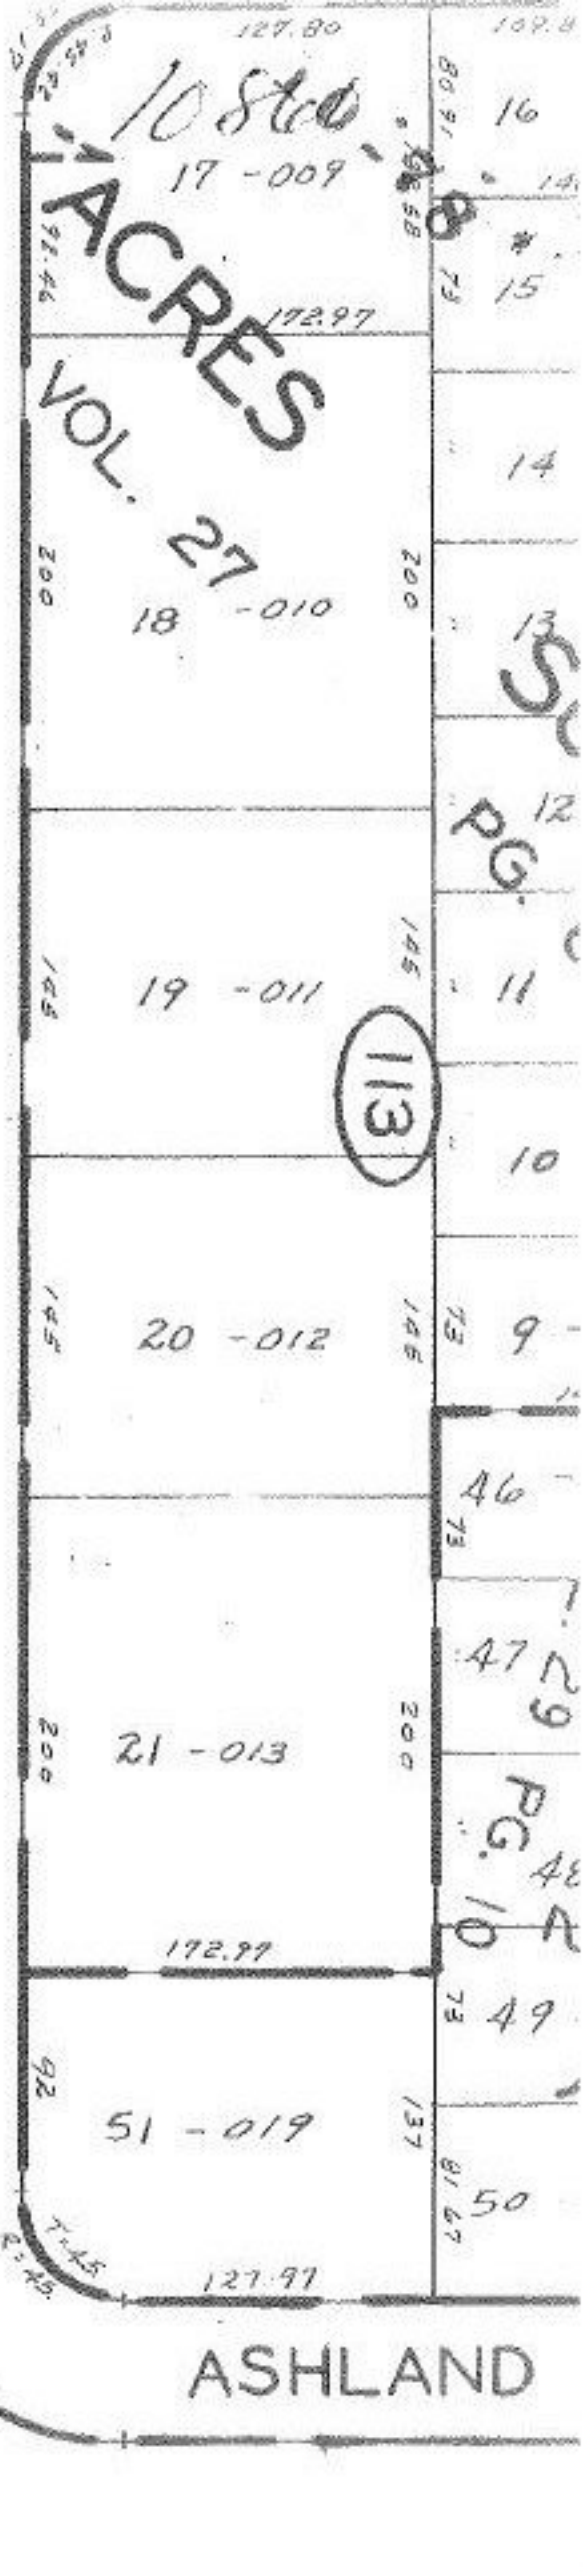

10861 ACRES VOL. 27

17 - 009

18 - 010

19 - 011

20 - 012

21 - 013

51 - 019

ASHLAND

113

114

16
15
14
13
12
11
10
9
46
47
48
49
50