


357.92
168.96
168.96

10863

10-48

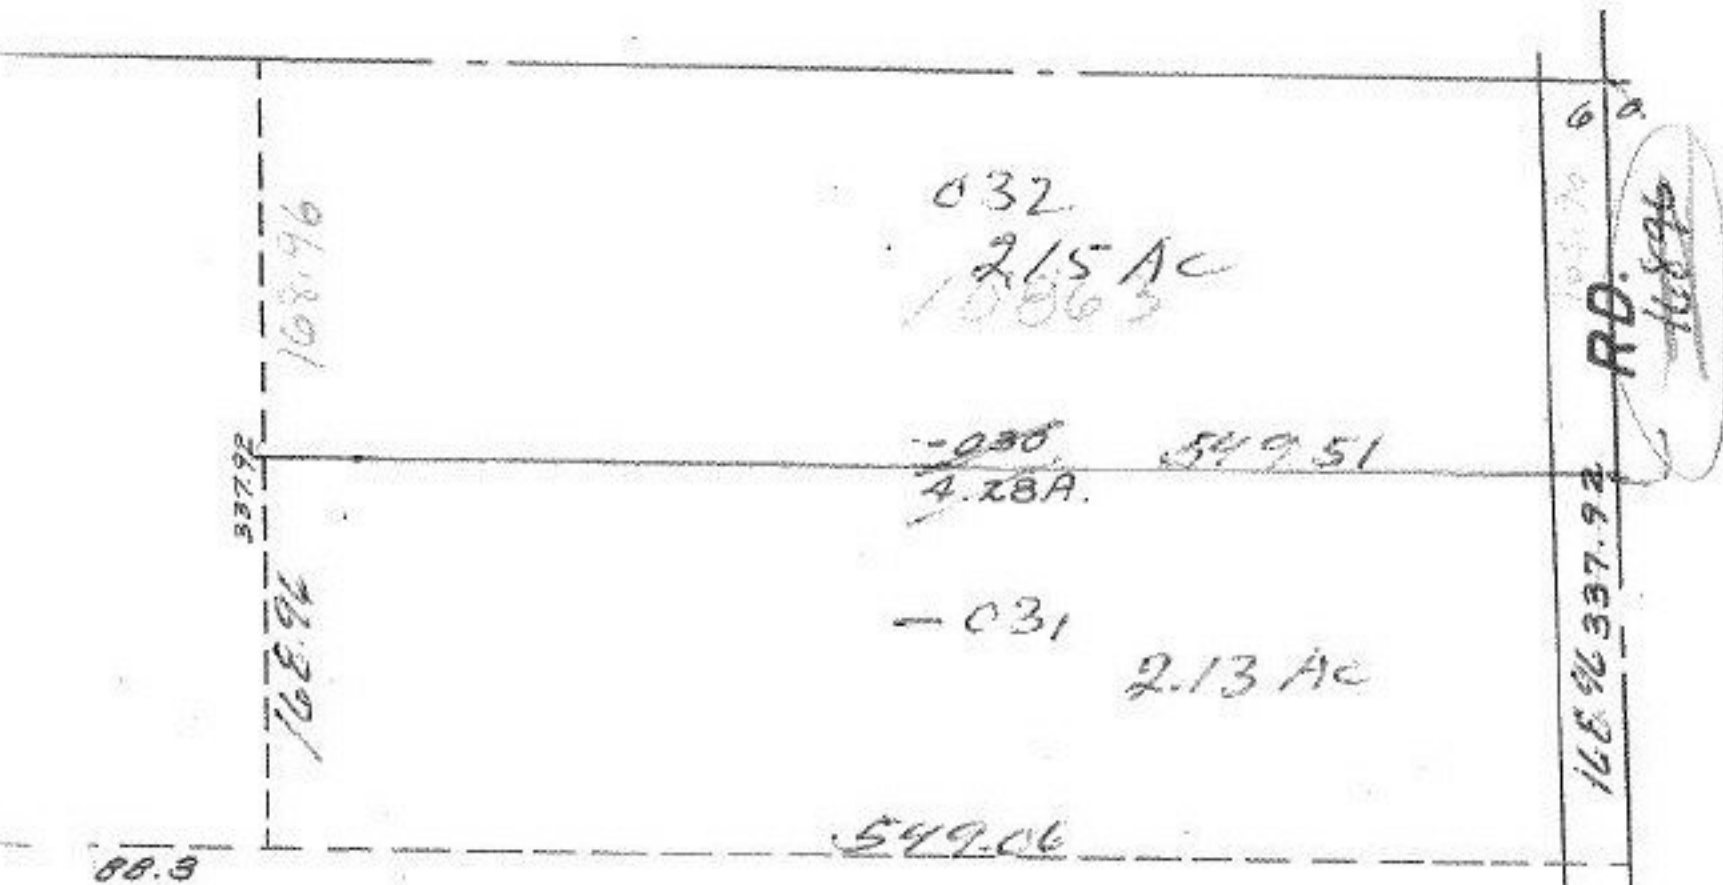

10863

APPROVED	
LORAIN CO.	
MAP DEPT.	
DATE	8/18/77
PAGE	01-00 - 038B
BY	L. W. Hall
VOID AFTER	

AUG 19 1977
Aug. 23, 1977 JB.

210
97A.

768