

10870

219.68, 81.0

420.18

219.68

200.50

C.F.

Survey Deed

279

APPROVED
LORAIN CO.
MAP DEPT.

DATE 8-22-77

PAGE 15-H


BY L. W. HALL C.T.D. (Mr. Hall)

VOID AFTER

AUG 22 1977

88

150
-003
1,004
290

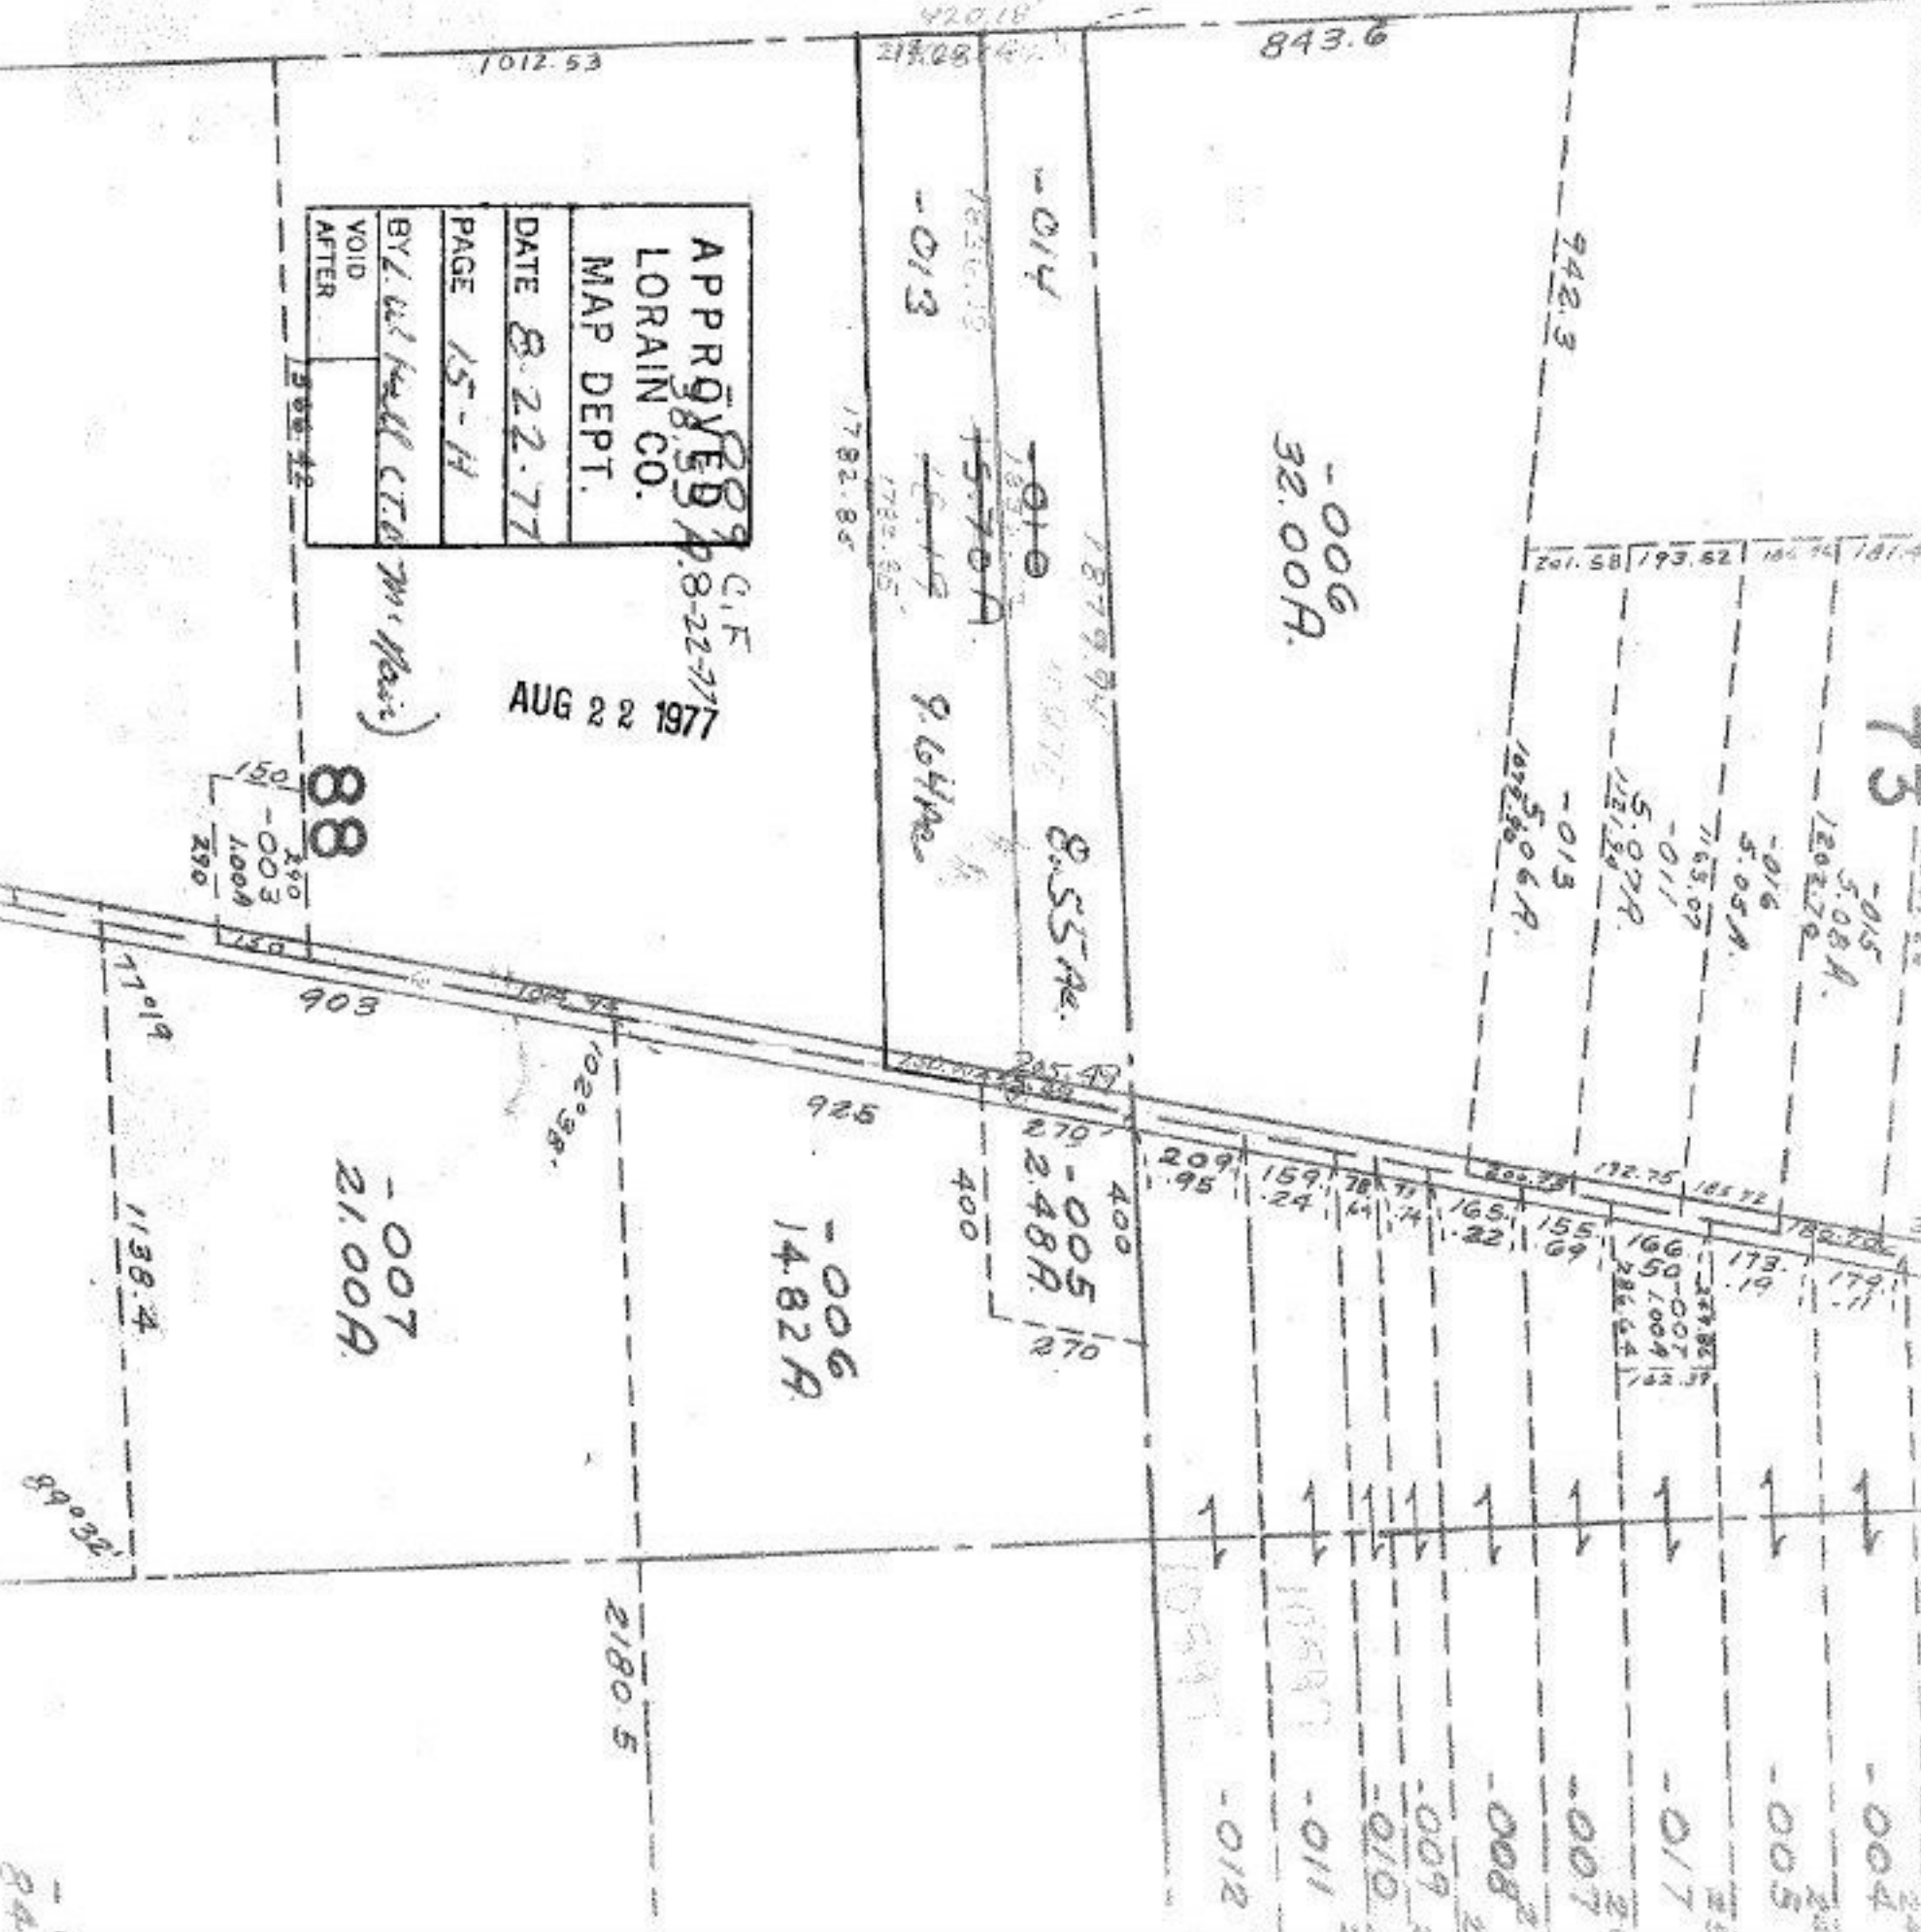

73

-015
5.08 A.
1202.70

-016
5.05 A.
1163.07

-011
5.07 A.
121.34

-013
5.06 A.
1425.60

8.55 A.
1879.94

9.64 A.
1782.85

-006
14.82 A.
925

-007
21.00 A.
903

-005
2.48 A.
400

-004

-005

-017

-007

-008

-009

-010

-011

-012

84