


SE

#10874

8 1/2'

36

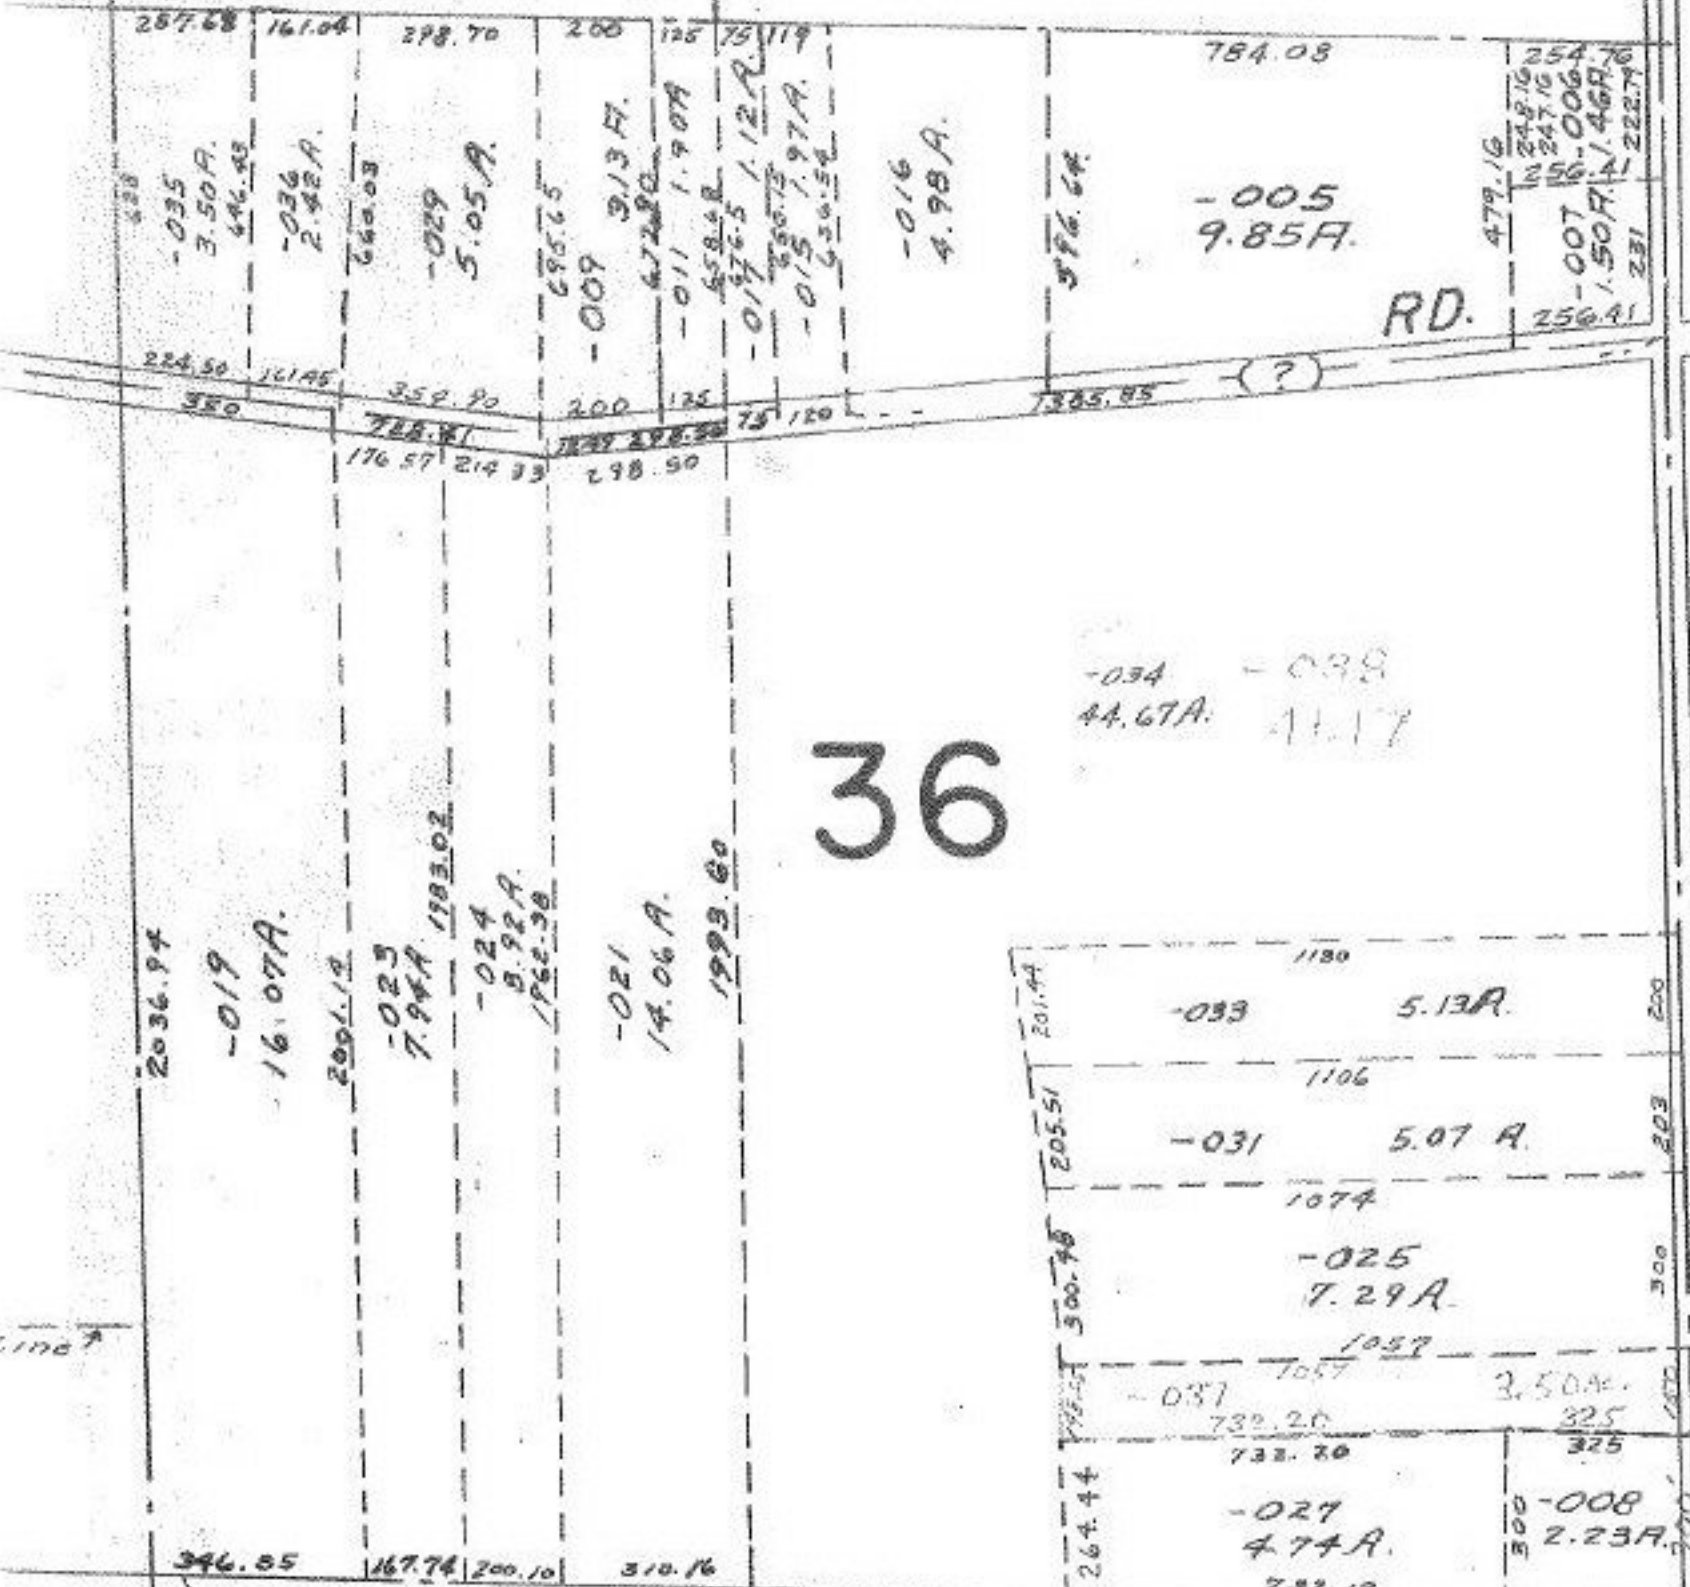

APPROVED  
 LORAIN CO.  
 MAP DEPT.

DATE 8-23-77 8/25/77  
 J.A.

PAGE 1-F

BY L.W. HARR (C.A.M.)

VOID AFTER 10874

-002 78.53A.

SUNNYSIDE