


PECK - WADSWORTH

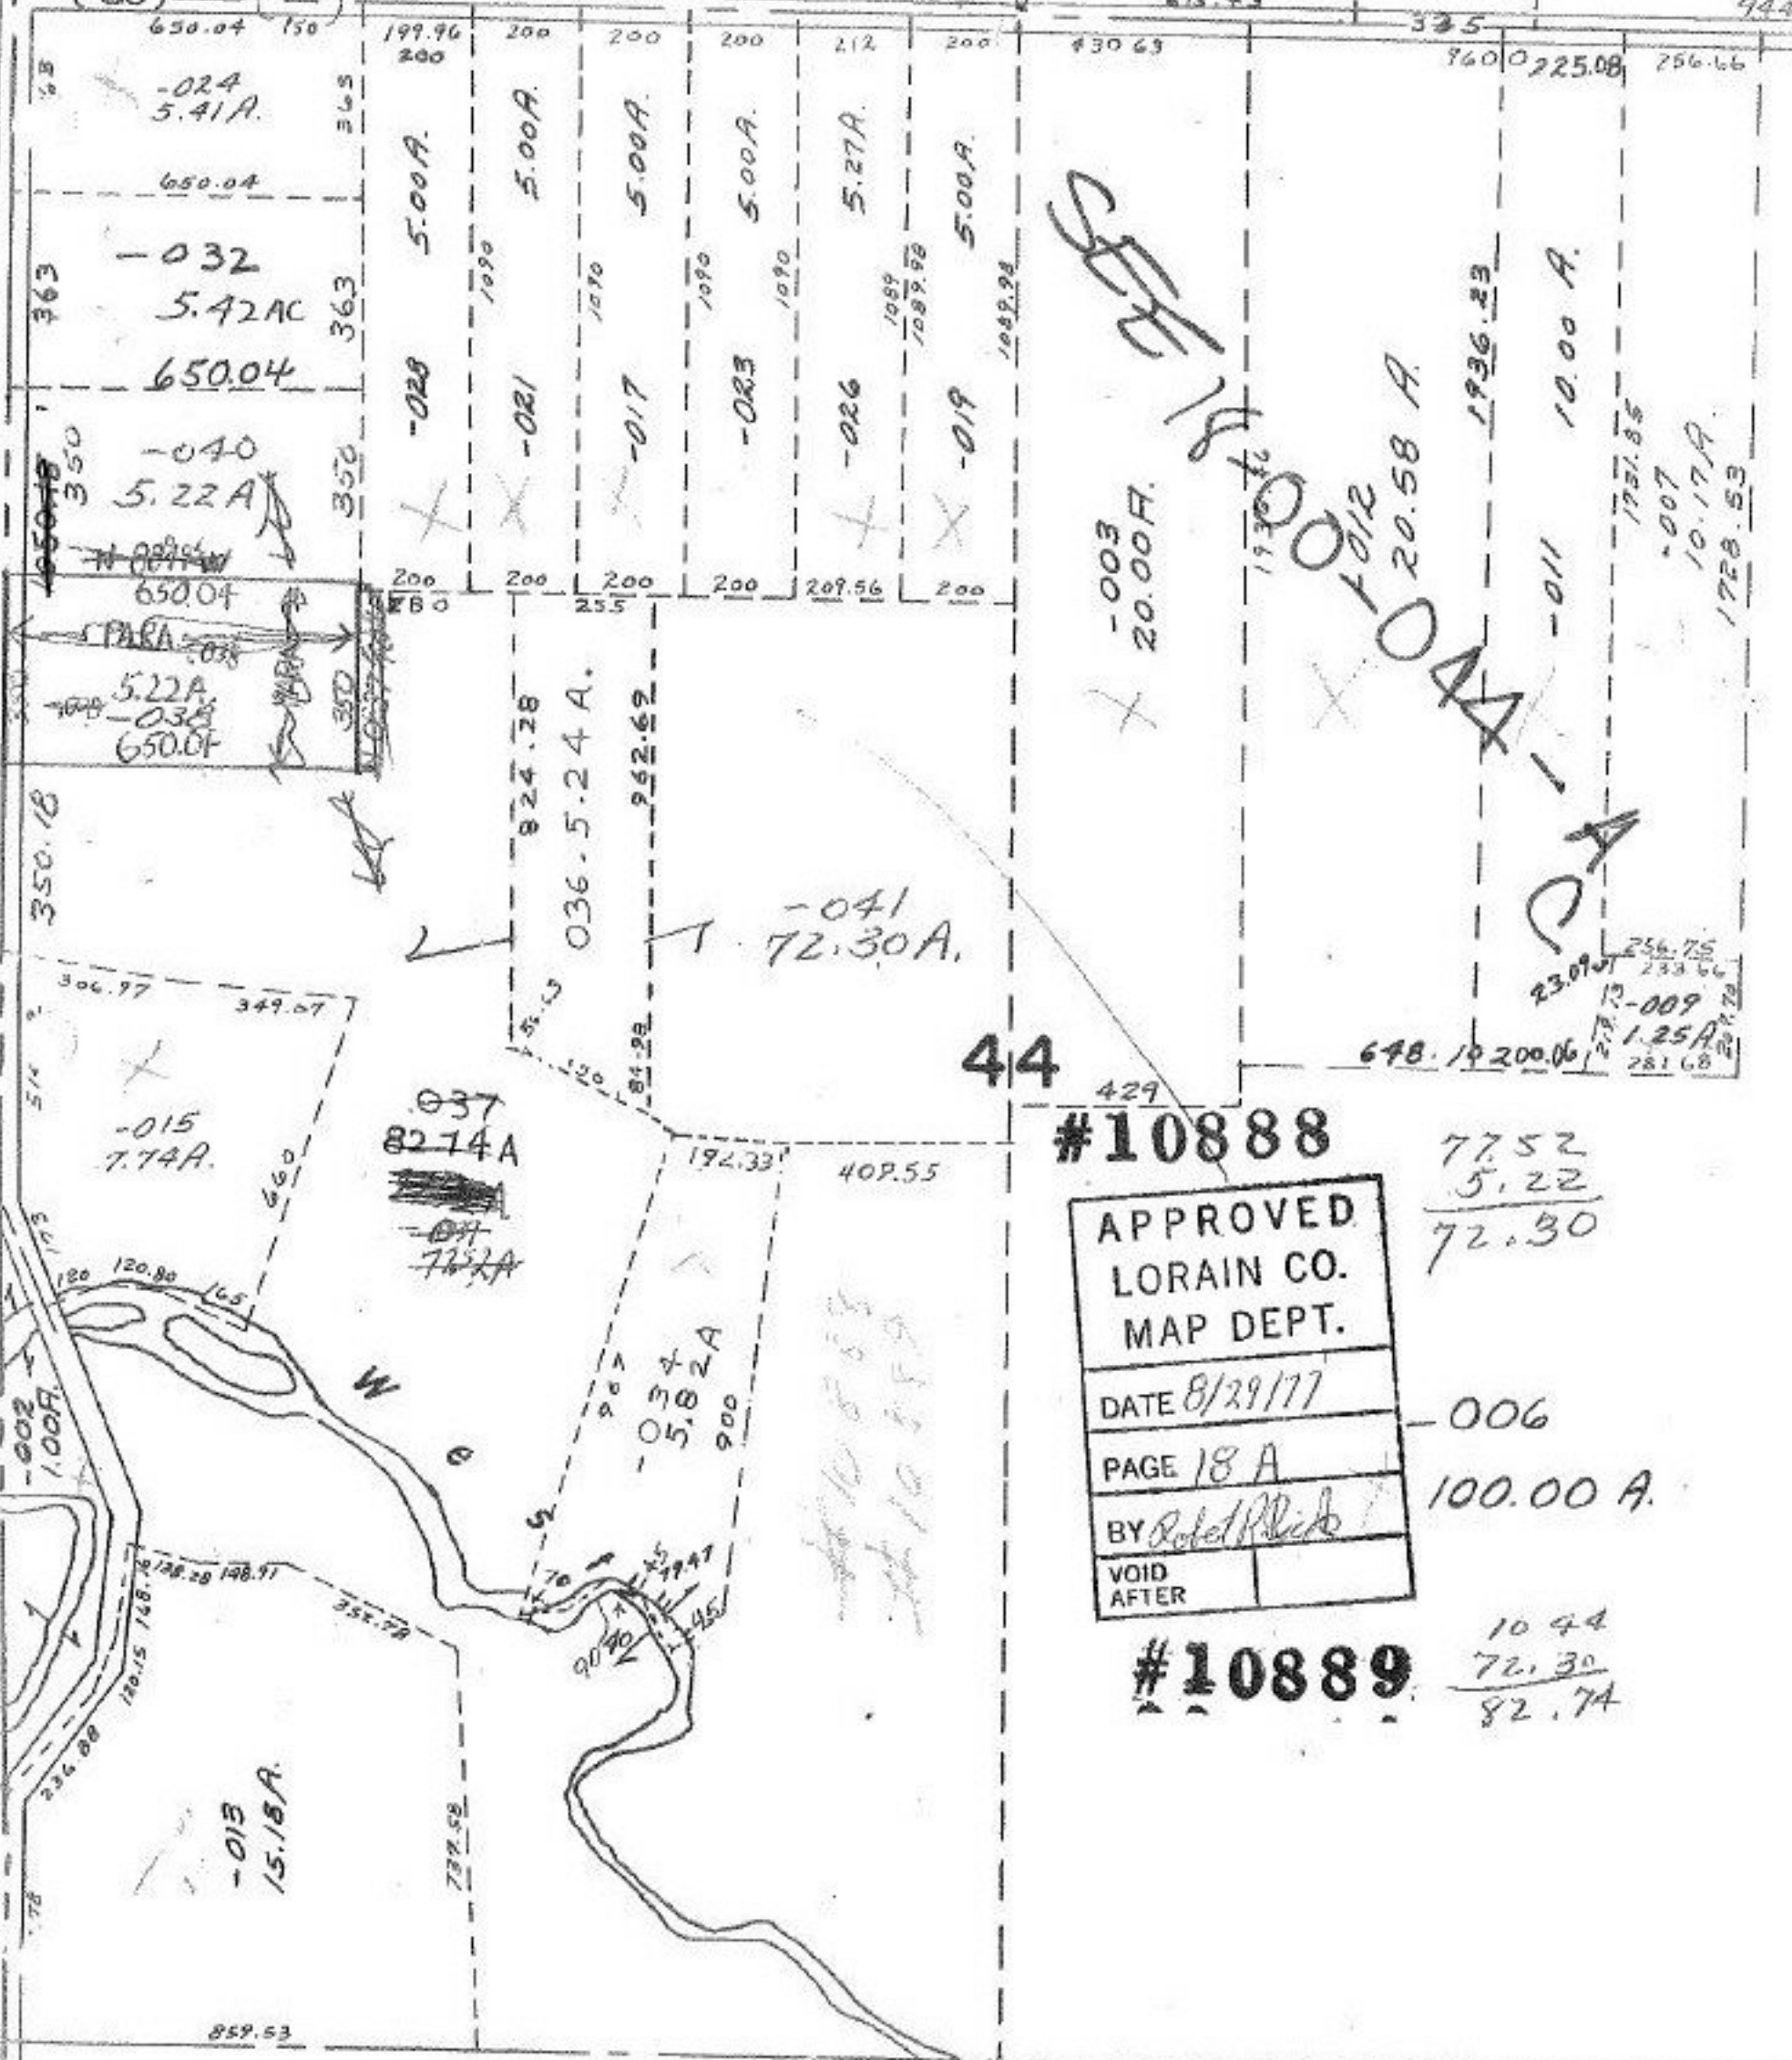

44

#10888

APPROVED
LORAIN CO.
MAP DEPT.
DATE 8/29/77
PAGE 18 A
BY Robert R. Dick
VOID
AFTER

77.52
5.22
72.30

006
100.00 A.

#10889

10.44
72.30
82.74

23.09
12-009
1.25 A
281.68

1936.23
1936.23
10.00 A.
1751.85
10.17 A.
1728.53

-003
20.00 A.

1936.23
1012
20.58 A.

225.08
256.66

82.14 A

76.7 A

5.82 A

-013
15.18 A.

-015
7.74 A.

-041
72.30 A.

824.28
036.524 A.

-040
5.22 A

-032
5.42 AC

-024
5.41 A.

Handwritten signature/initials

Handwritten 'CA' vertically

Handwritten notes: 10 8 53, 10 10 153