


108993 10.26

STREET GARGASZ DEDIC

URBAN CIRCLE SOUTH

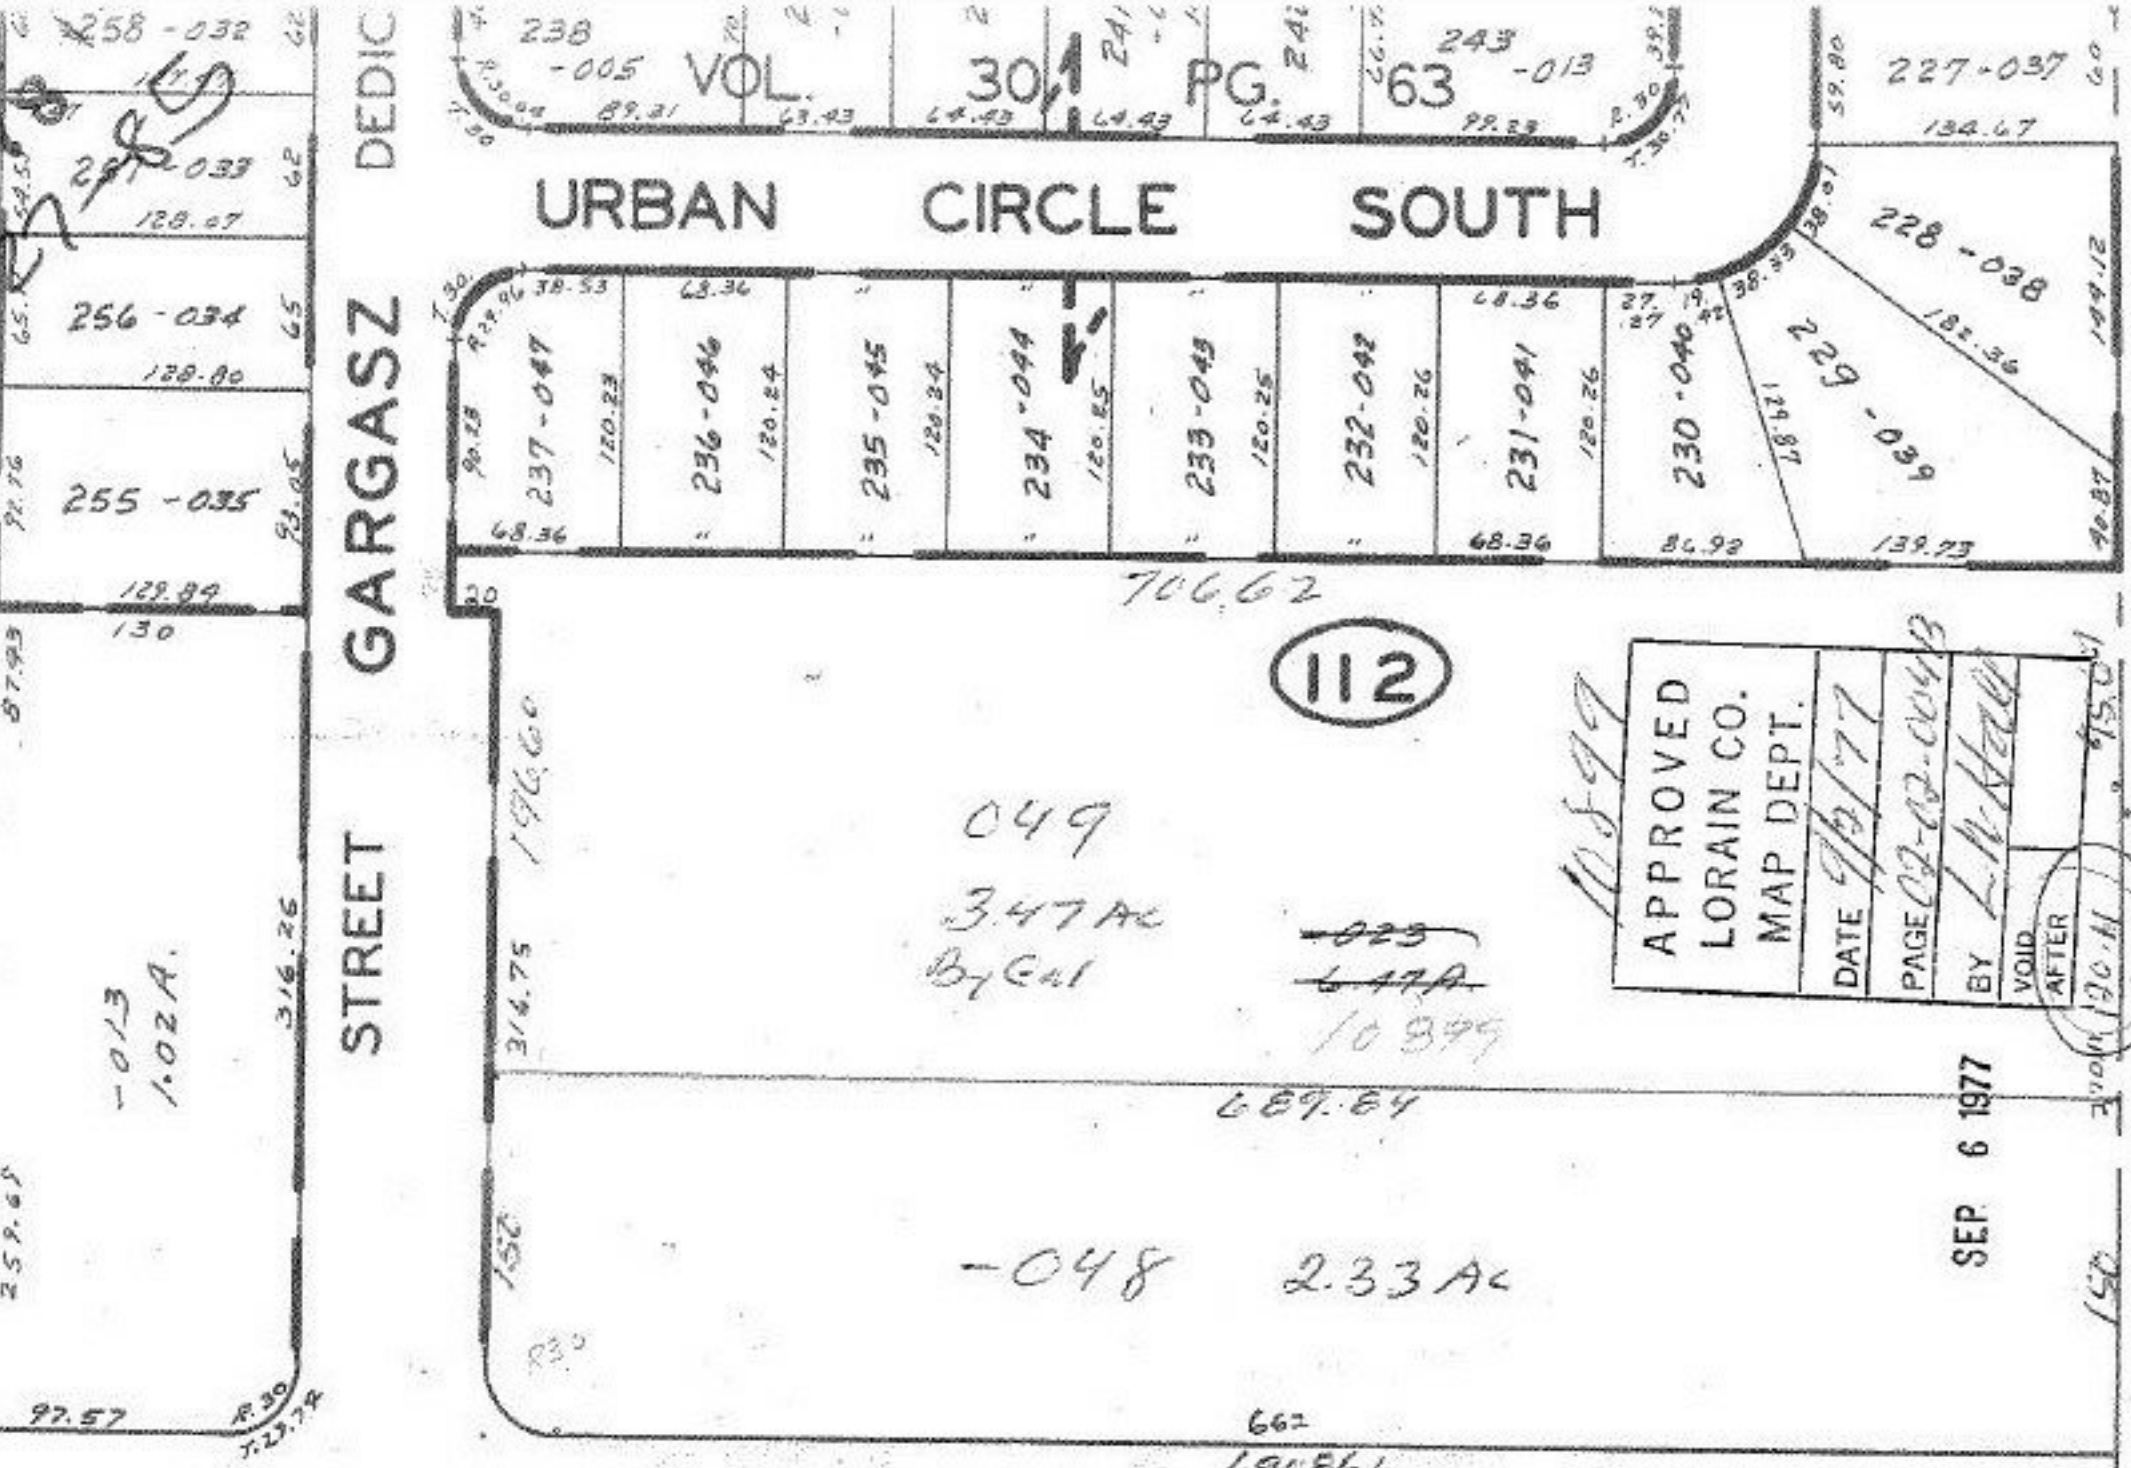

COOPER FOSTER PARK RD.

663  
30  
692

APPROVED	DATE	PAGE	BY	VOID AFTER
LORAIN CO. MAP DEPT.	10/2/77	02-02-0048	L.W. HALL	

SEP 6 1977

