


82-0-78

10908

SEE 7-00-018-D

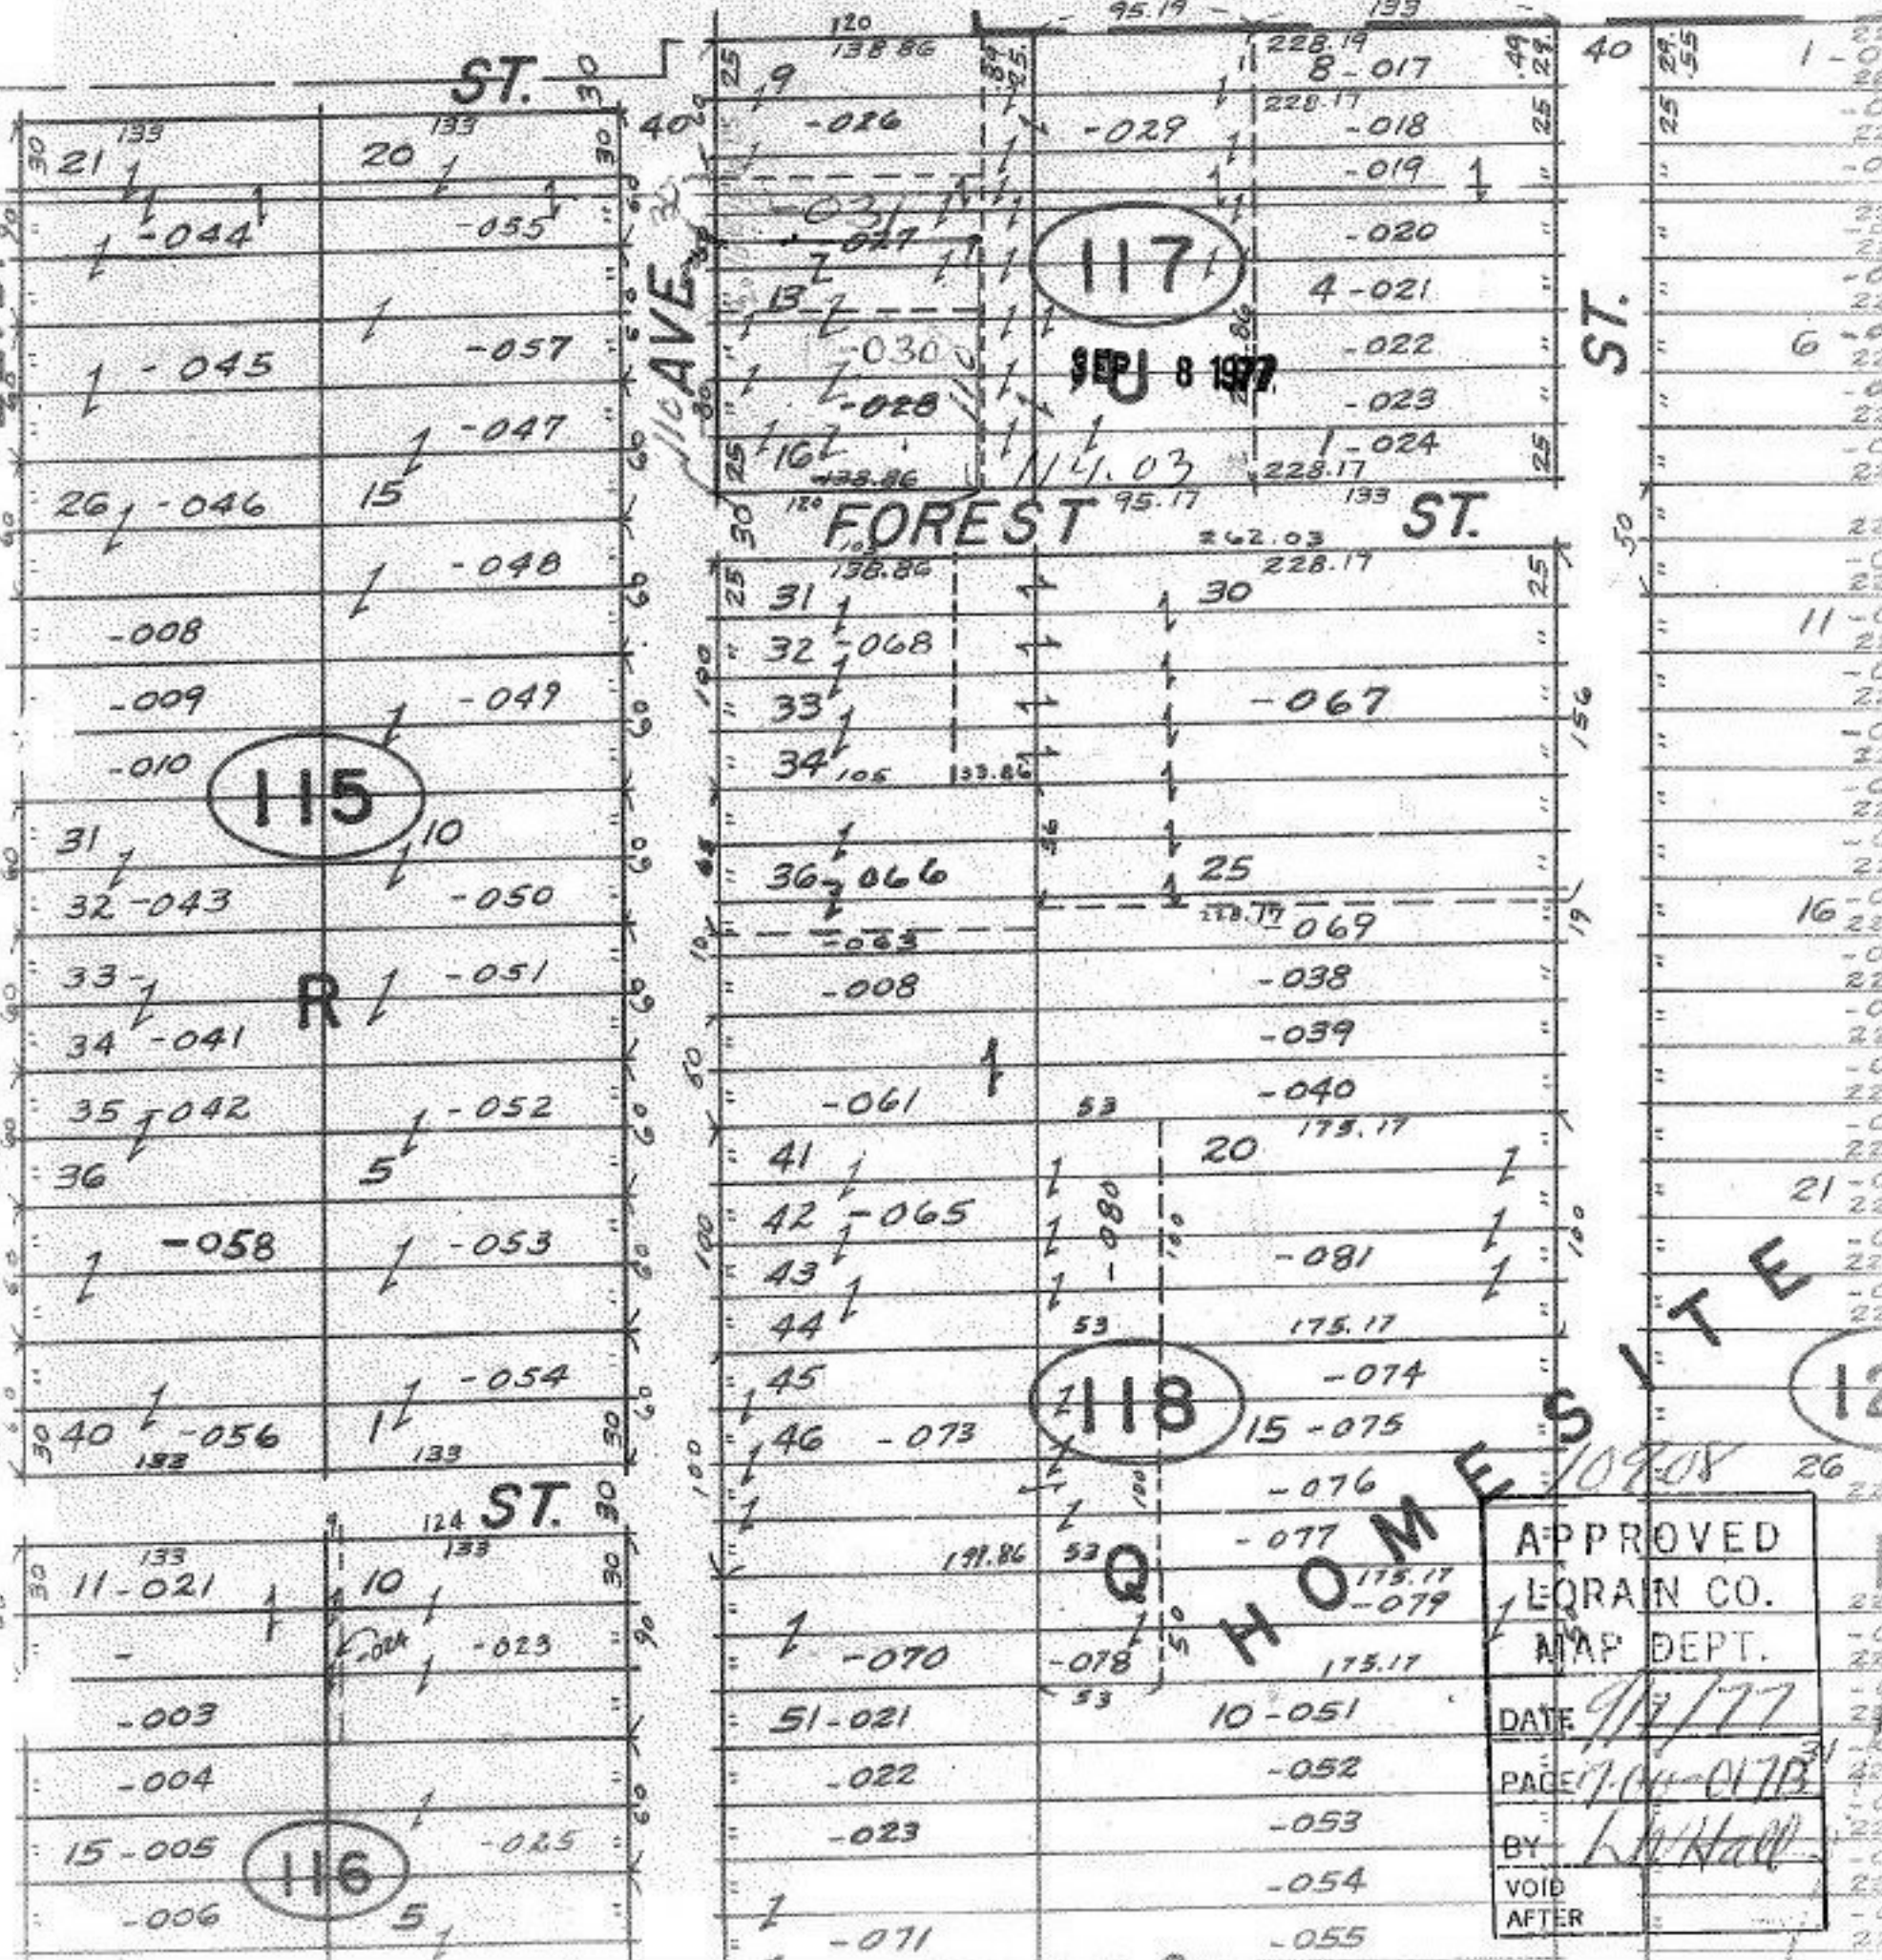

APPROVED
LORAIN CO.
MAP DEPT.
DATE 9/7/77
PAGE 17-00-017B
BY L.H. Hall
VOID AFTER