


216/1

Check This Transfer

COOPER FOSTER PARK

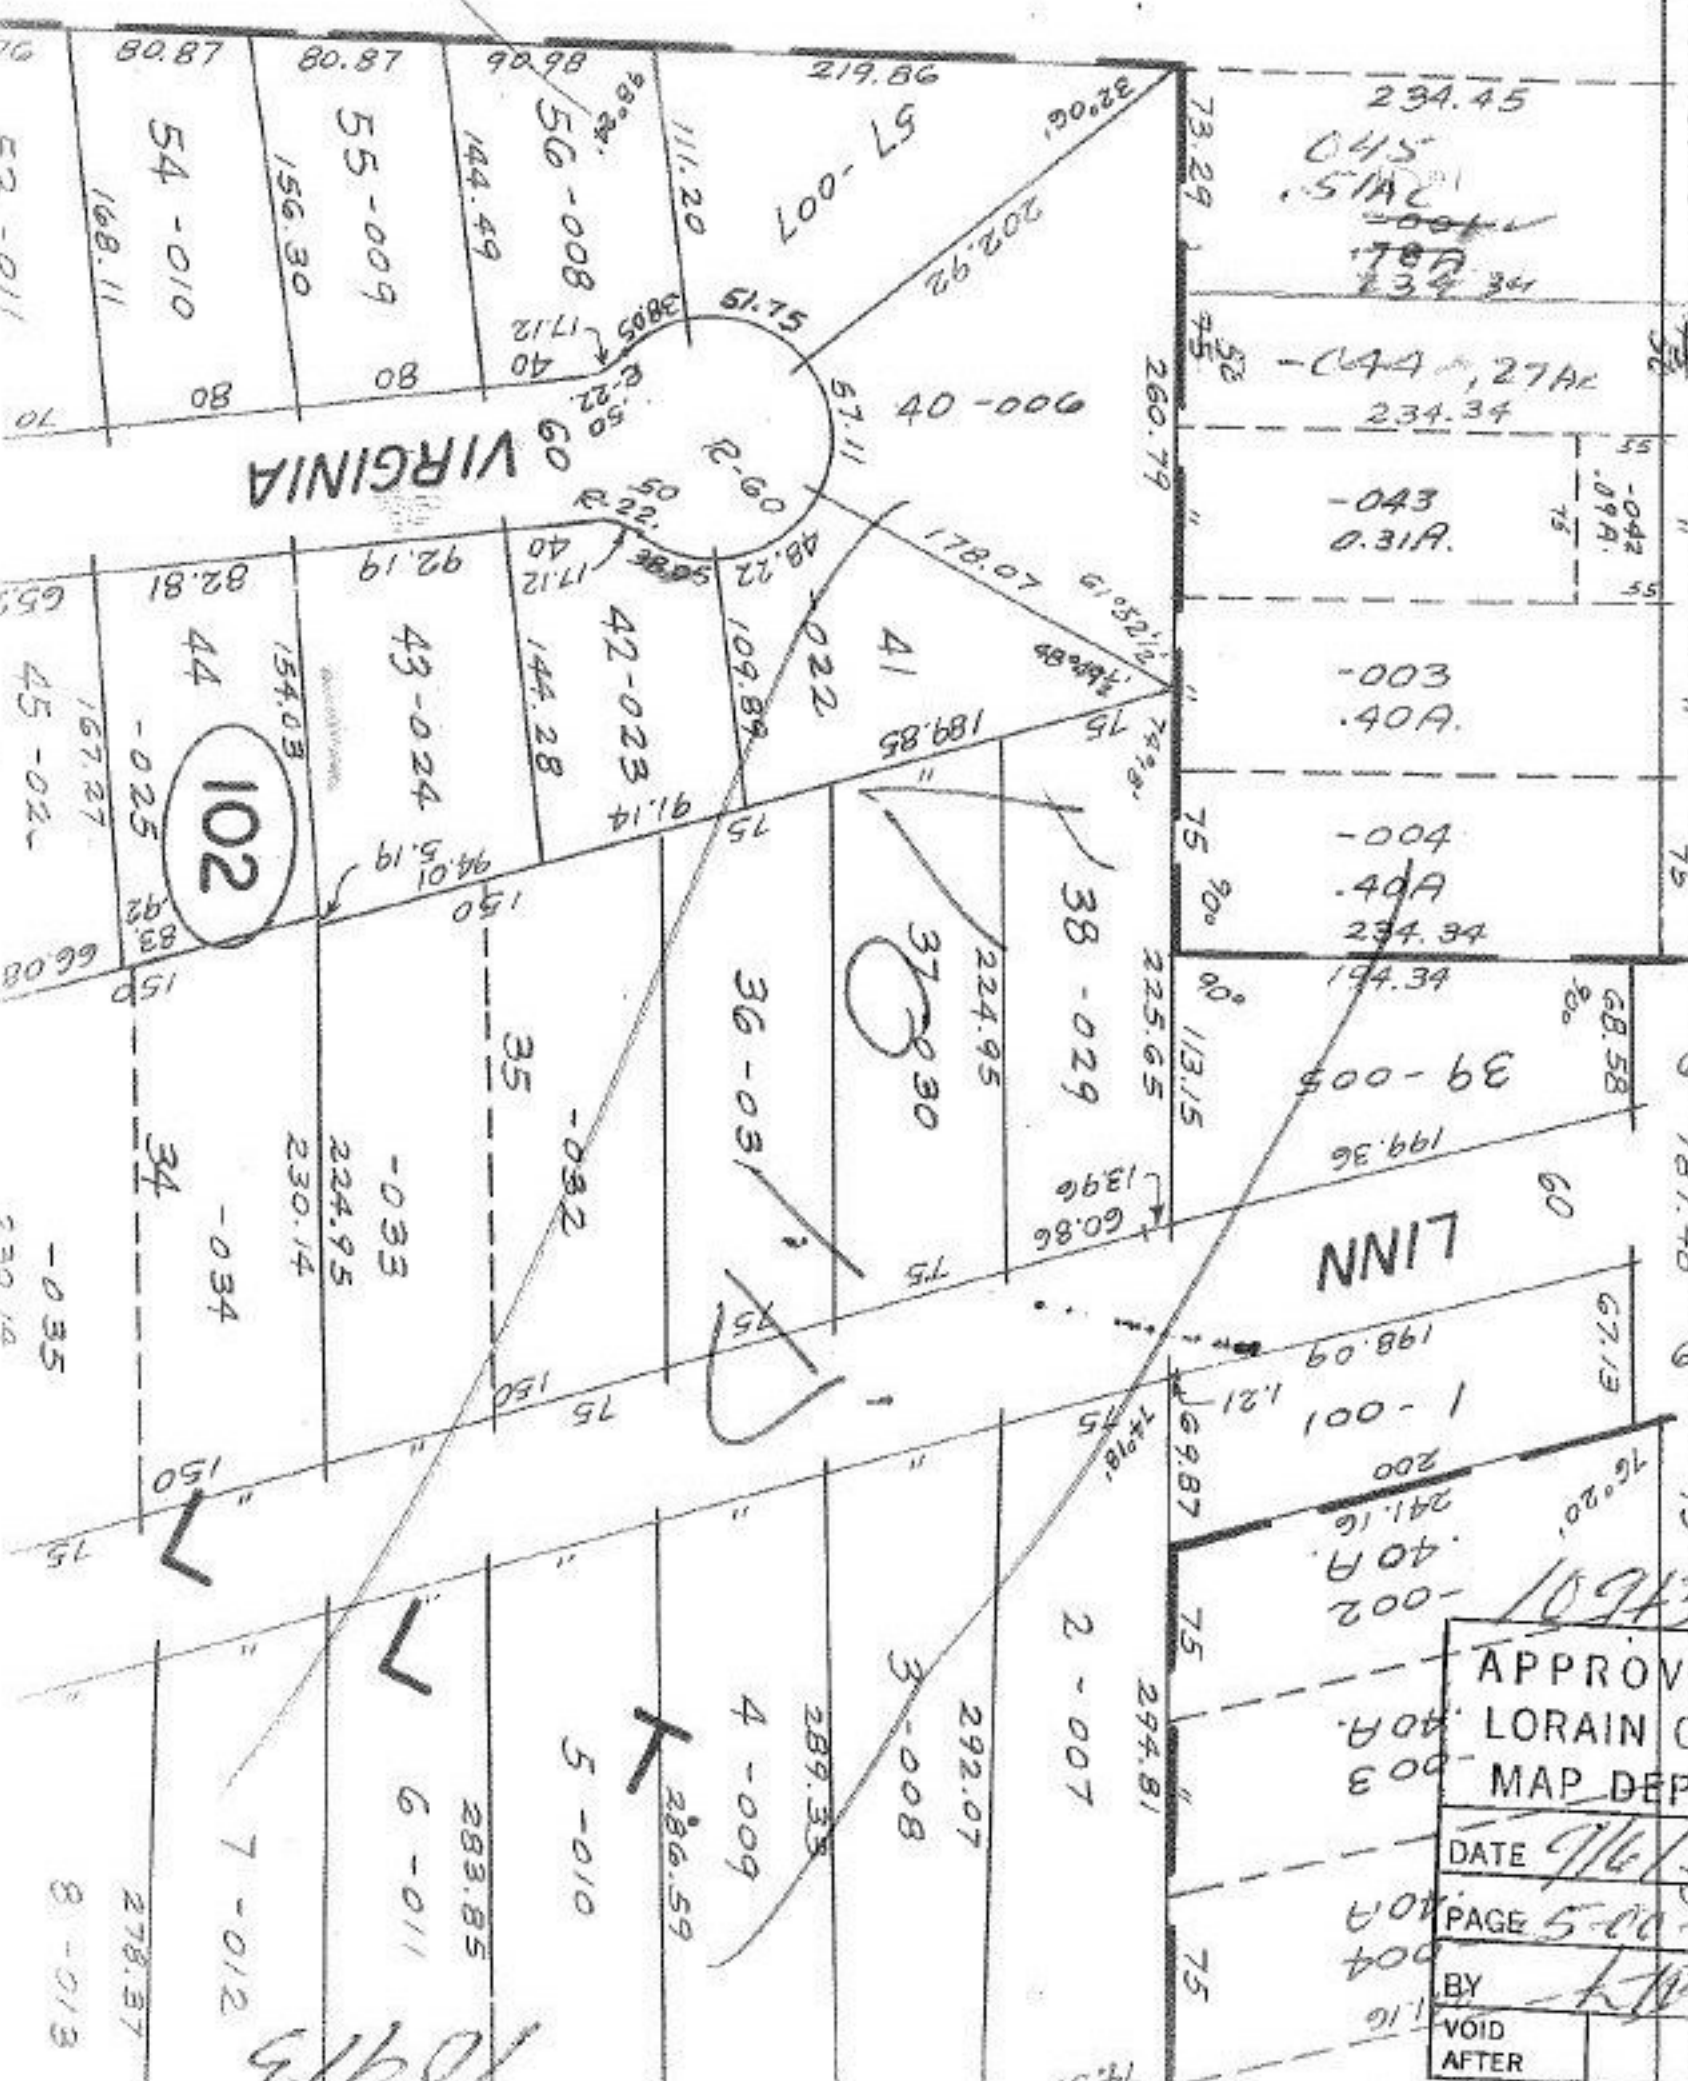

APPROVED  
LORAIN CO.  
MAP DEPT.

DATE 9/6/17

PAGE 5-10-100B

BY [Signature]

VOID AFTER

10913