
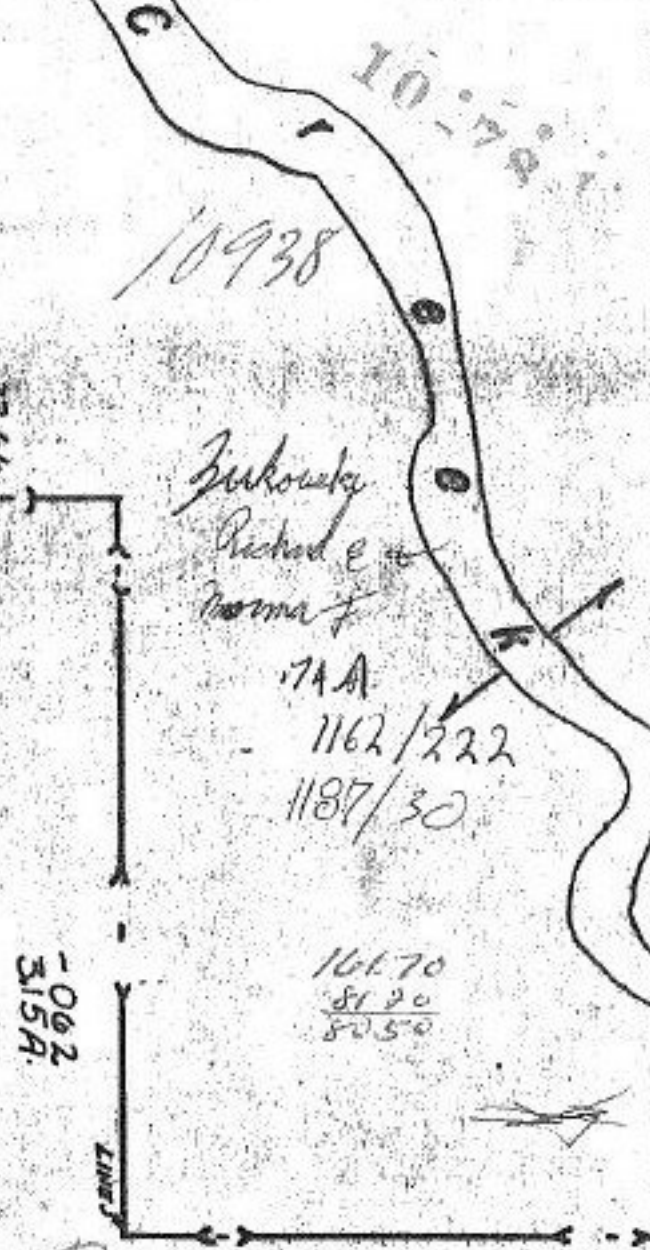


- 055  
2.24A


B16143

SEP 20 1977

400

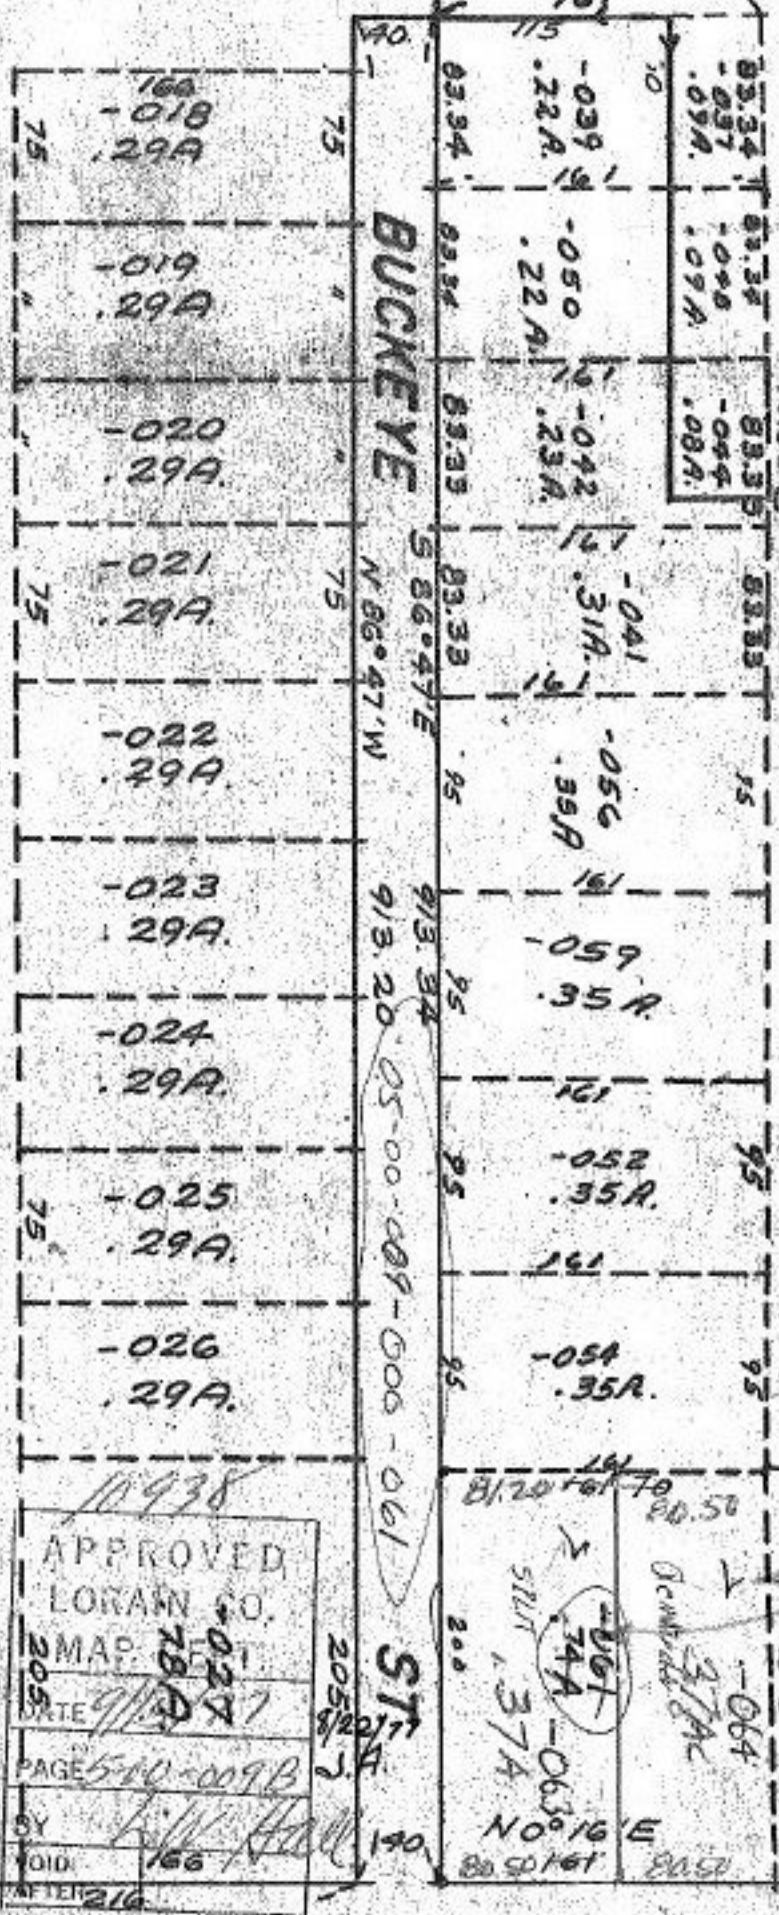

Bob  
Look Up  
Numbers For  
These Parcels

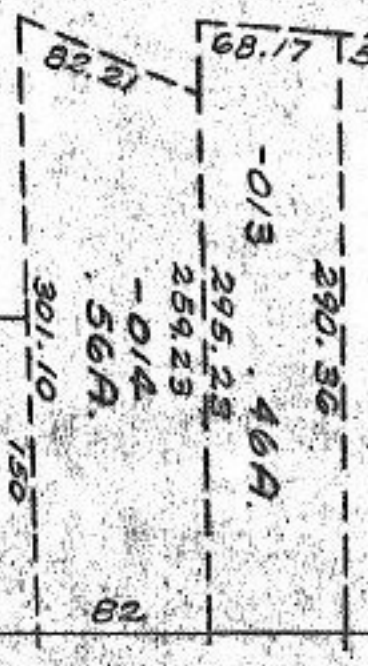

10938

APPROVED  
LORAIN CO.  
MAP  
DATE 9/15/77  
PAGE 5-10-009B  
BY [Signature]  
VOID AFTER 216