

10964

10-78

10964

-001 ✓  
25.58 A.

Pt. -009 ✓  
Pt. 26.06 ✓

10965


10965

-002 ✓  
56.93 A. ✓

7

7878	-005	86
	.53 A	
7878	-006	80
	.54 A	
292		
700	-007	200
	1.34 A.	
100	-008	150
	.66 A.	
322		

RD.

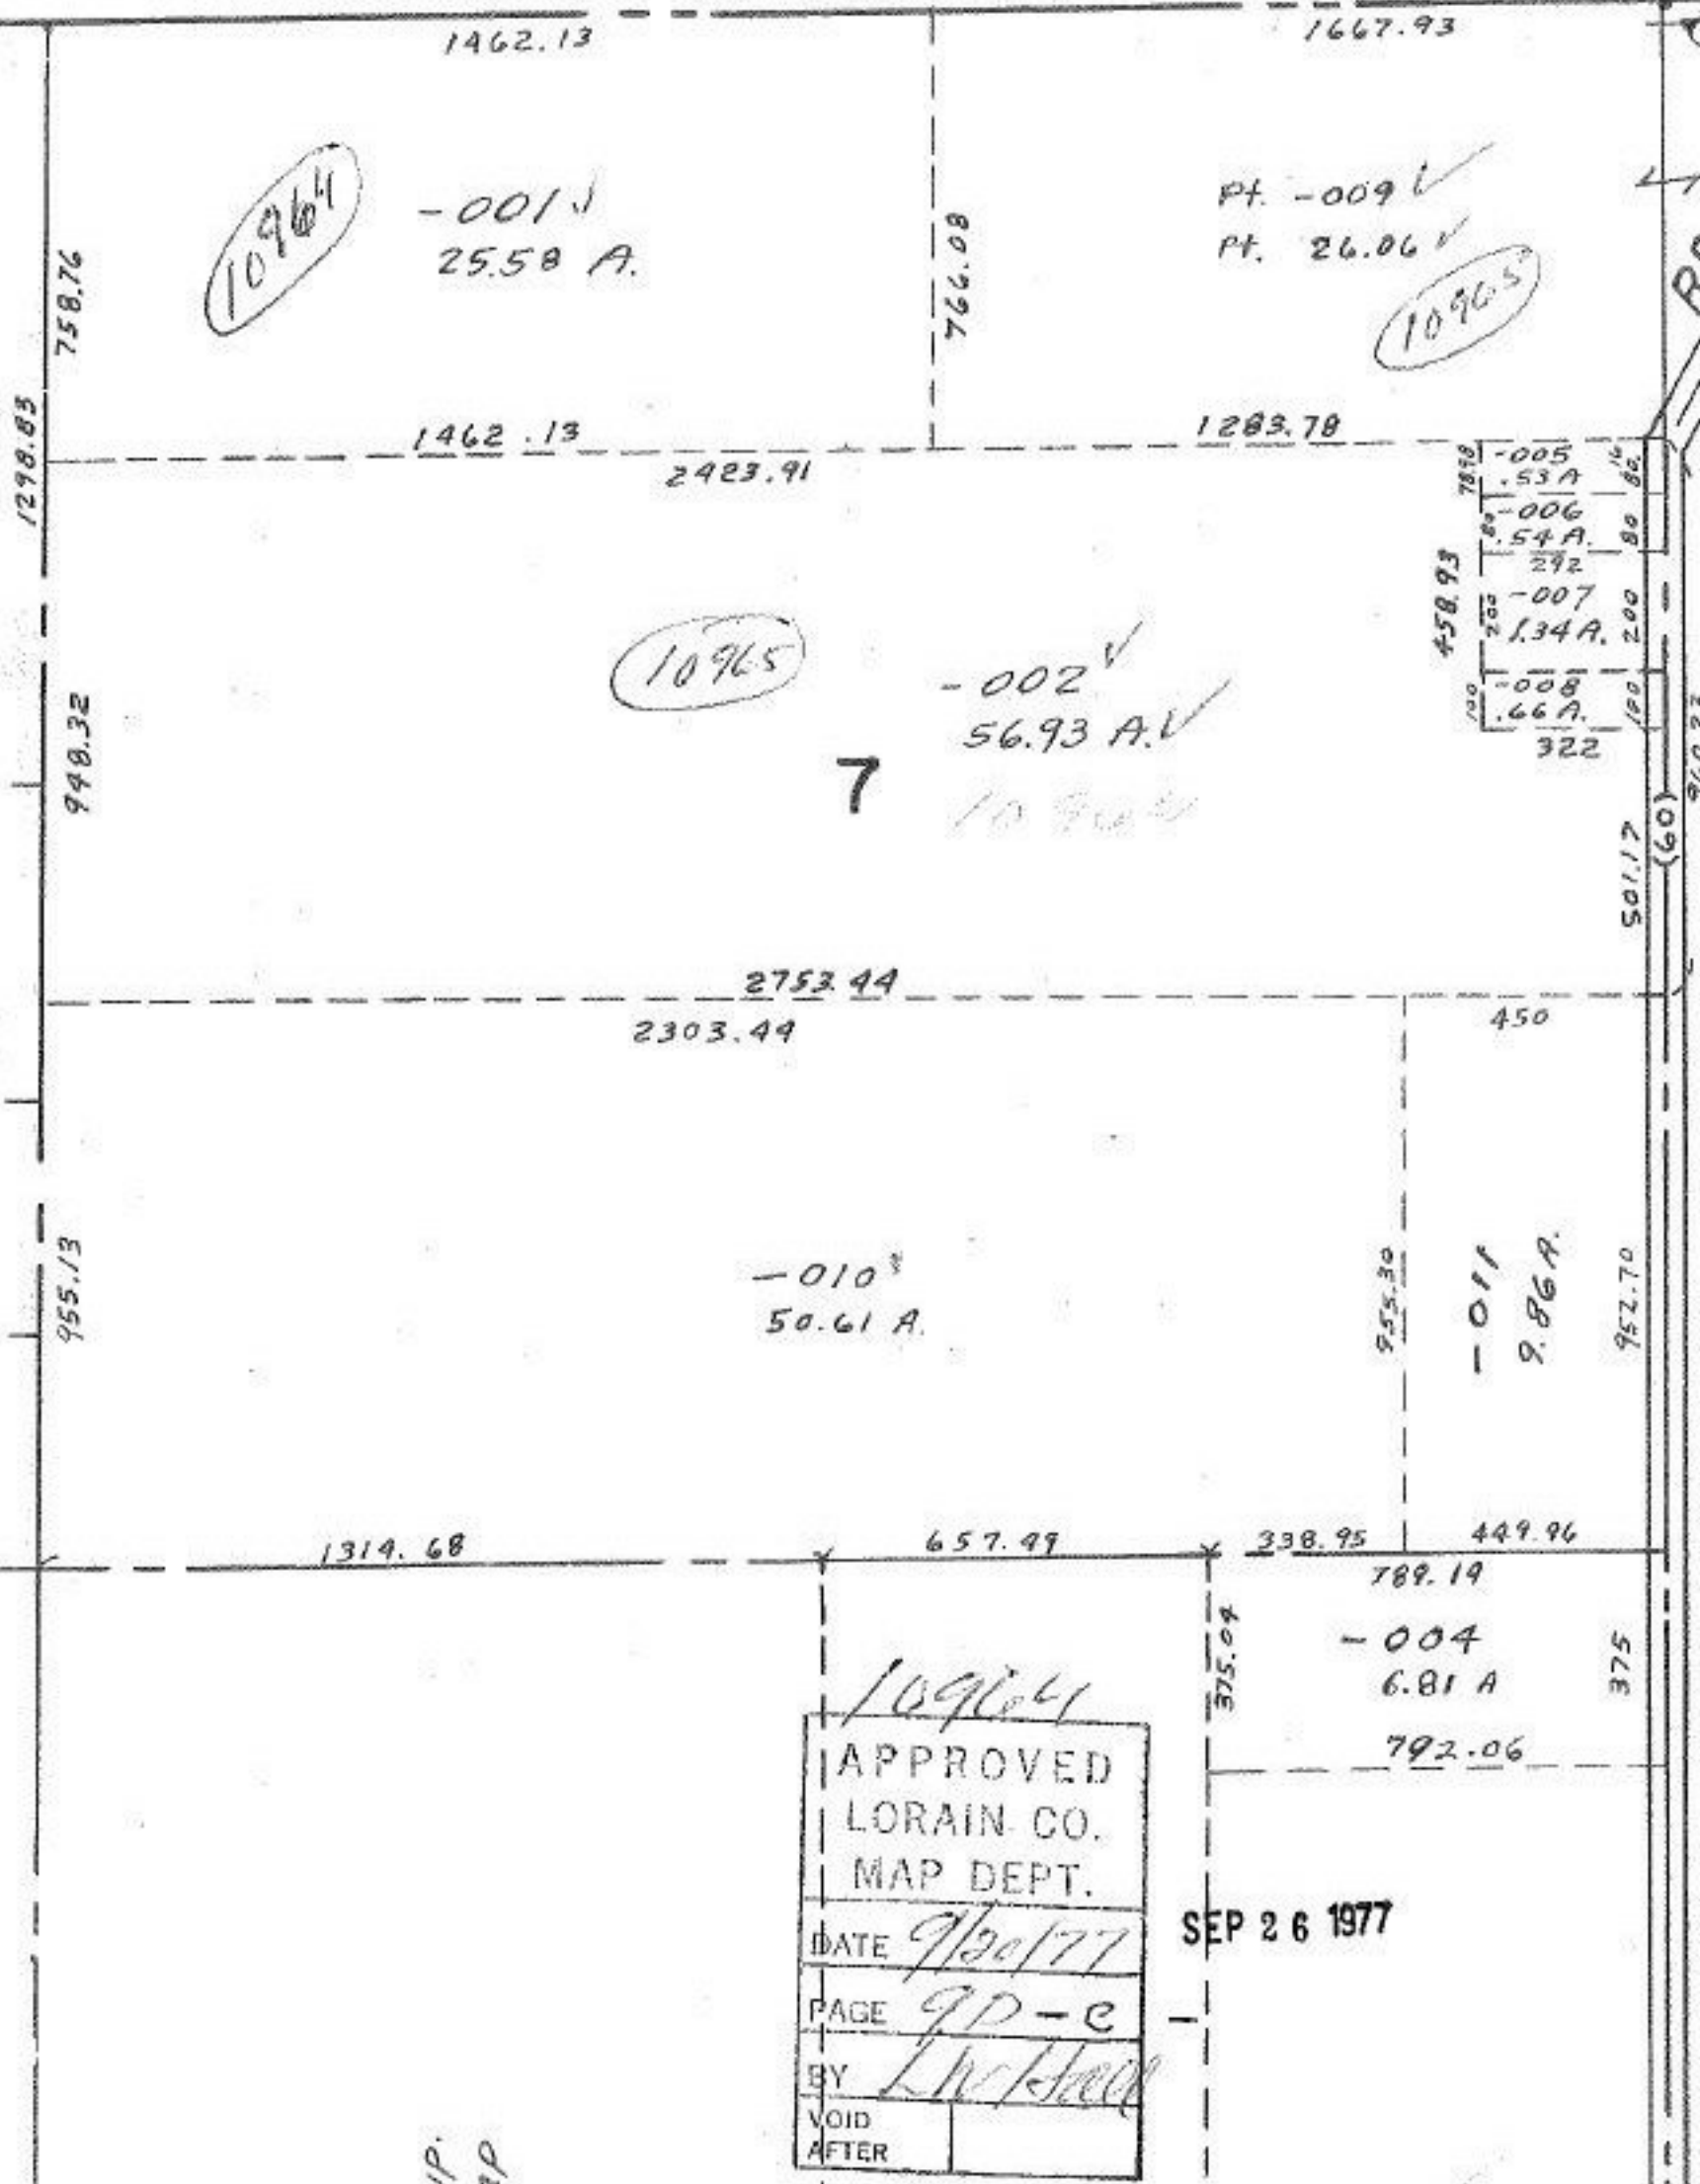

1298.83

1462.13

1667.93

758.76

766.08

1462.13

2423.91

1283.78

948.32

2753.44

2303.44

450

955.13

-010 ✓  
50.61 A.

955.30

-011 ✓  
9.86 A.

952.70

1314.68

657.49

338.95

449.96

789.19

-004 ✓  
6.81 A

375

792.06

10964

APPROVED
LORAIN CO.
MAP DEPT.
DATE 9/20/77
PAGE 9D-e
BY L. W. Hall
VOID AFTER

SEP 26 1977

A. Dup.  
A. Map

0 A.

9 A.