


10976

DATE	9/21/77
BY	LN
PAGE	20D
VOID AFTER	

APPROVED  
LORAIN CO.  
MAP DEPT.

10-1-77  
10976

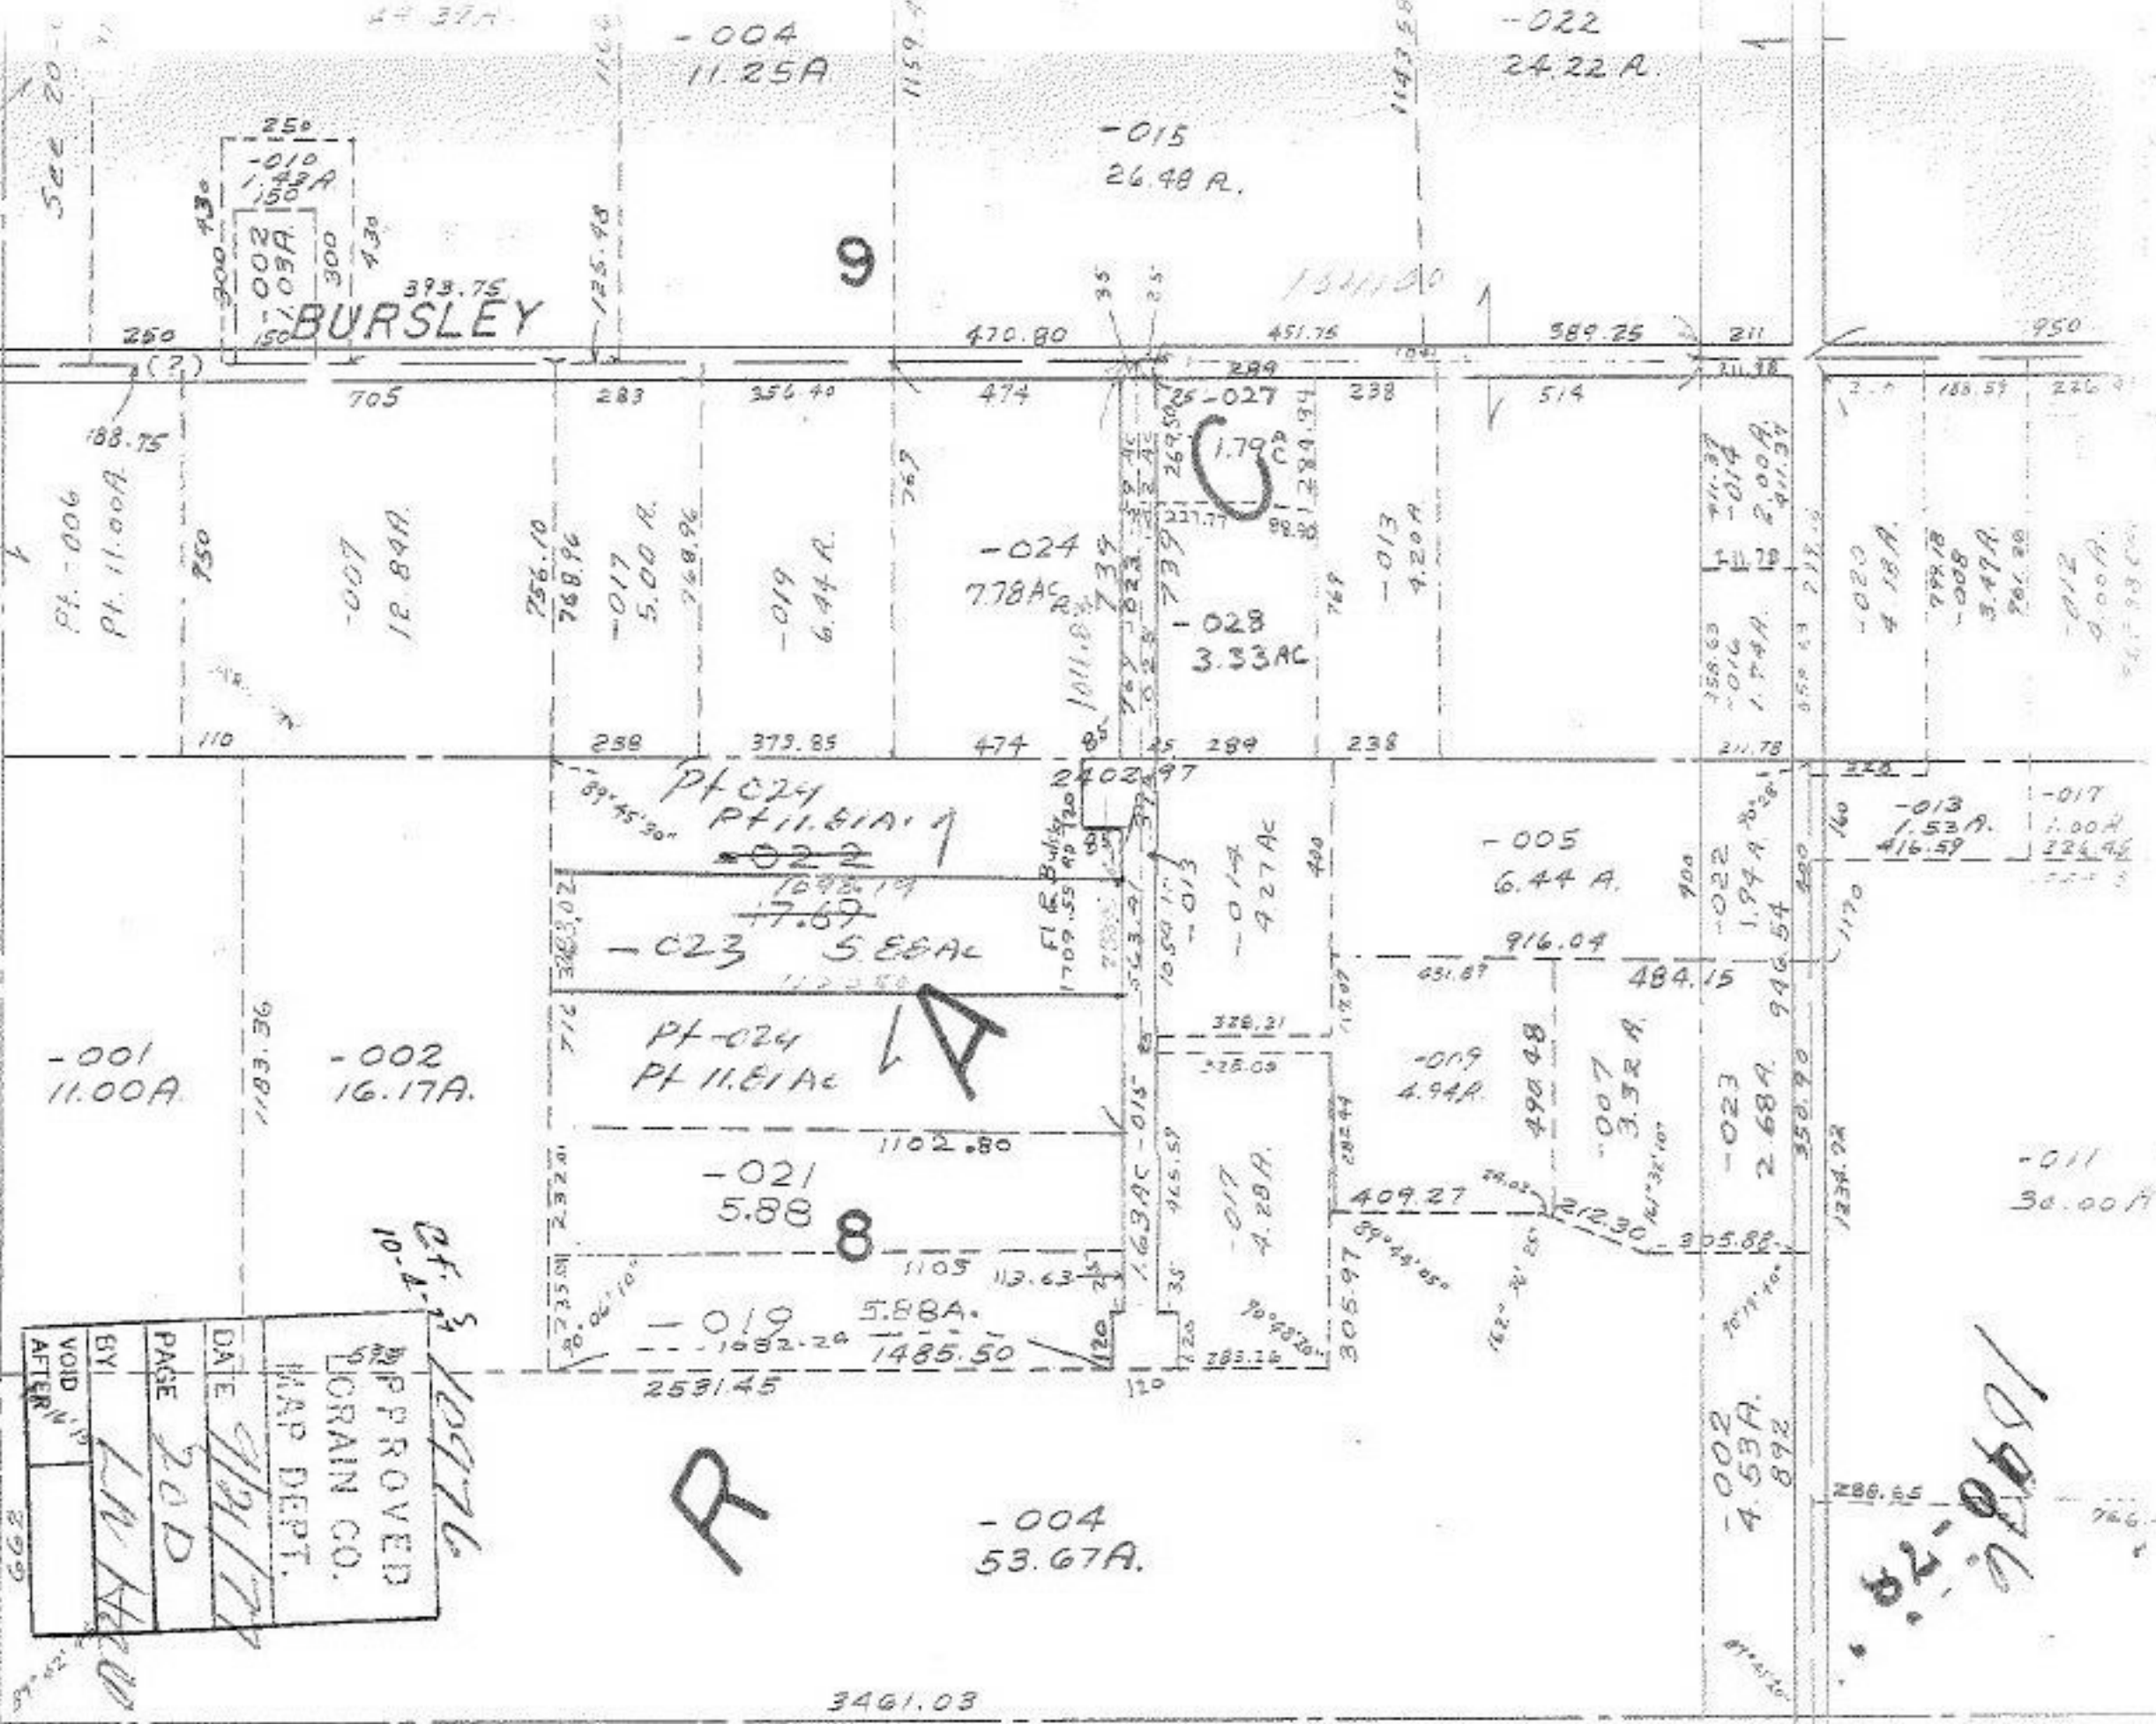

BURSLEY

9

8

R

3461.03

10976