


SEE 4-00-002-H


10980

107

SEE 4-00-011 F A 150

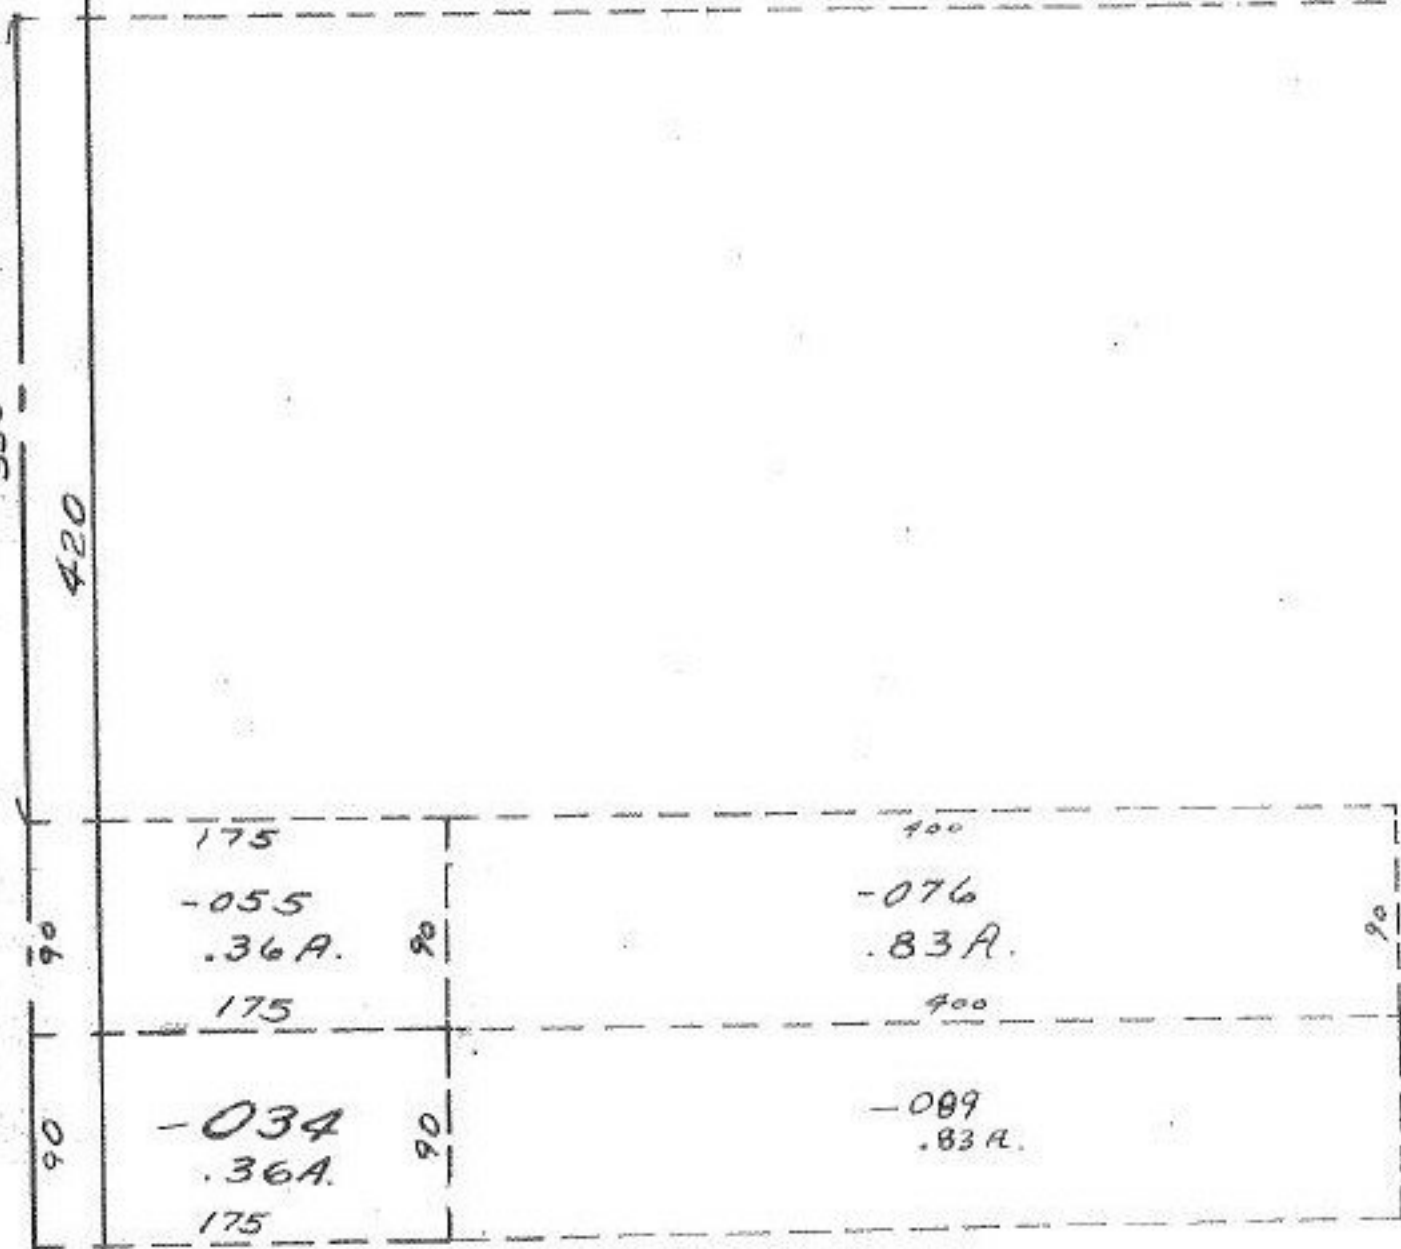

104
~~090~~
 47.87 AC
 45.16 AC

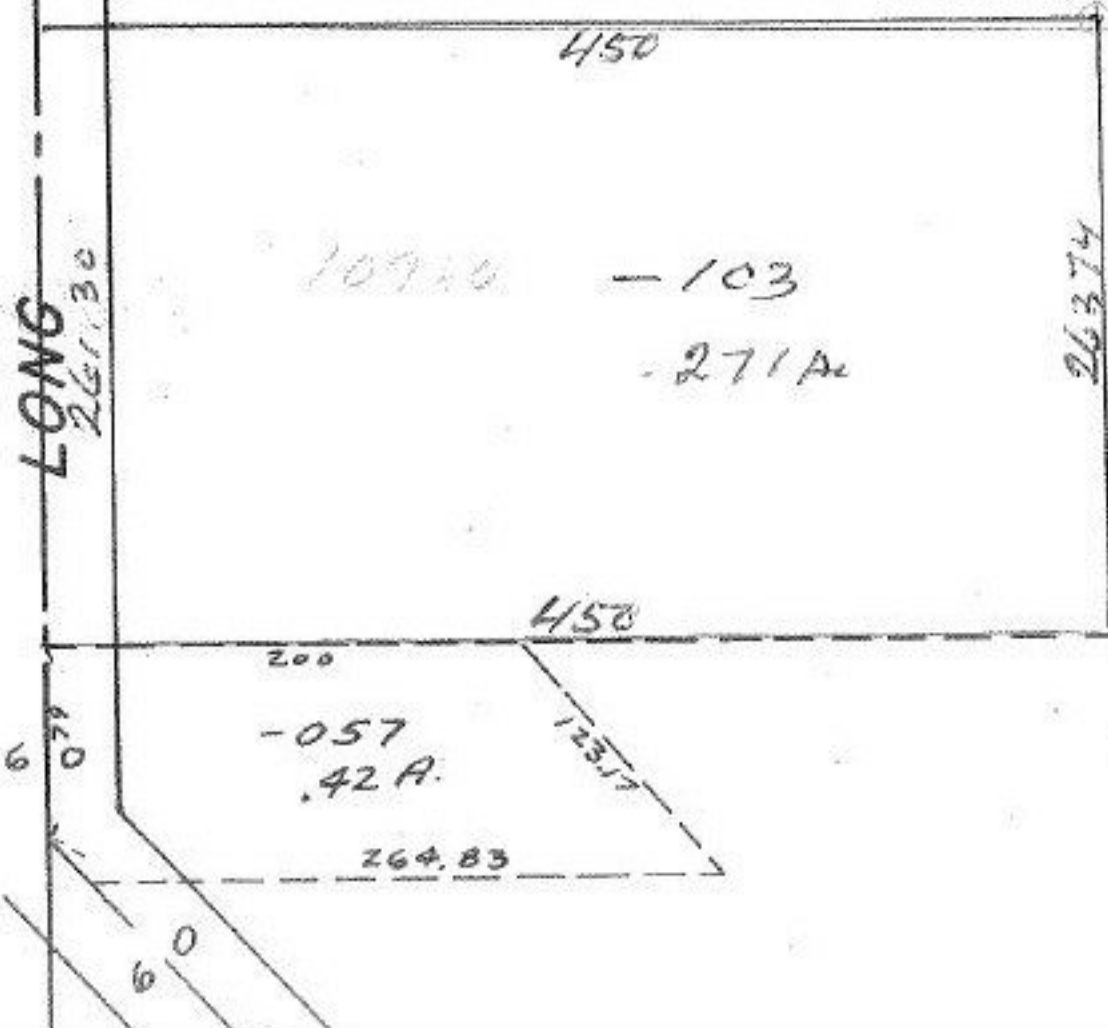

OCT 24 1977

10980

APPROVED LORAIN CO. MAP DEPT.	
DATE	9/23/77 12/13/77
PAGE	4-00-011 E 4011 F
BY	
VOID AFTER	

J.A.