


1098240-78

O.F.
10-11-77

10982

APPROVED
LORAIN CO.
MAP DEPT.
DATE 9/22/77
PAGE 04-00-0076
BY L.W. Hall
VOID AFTER

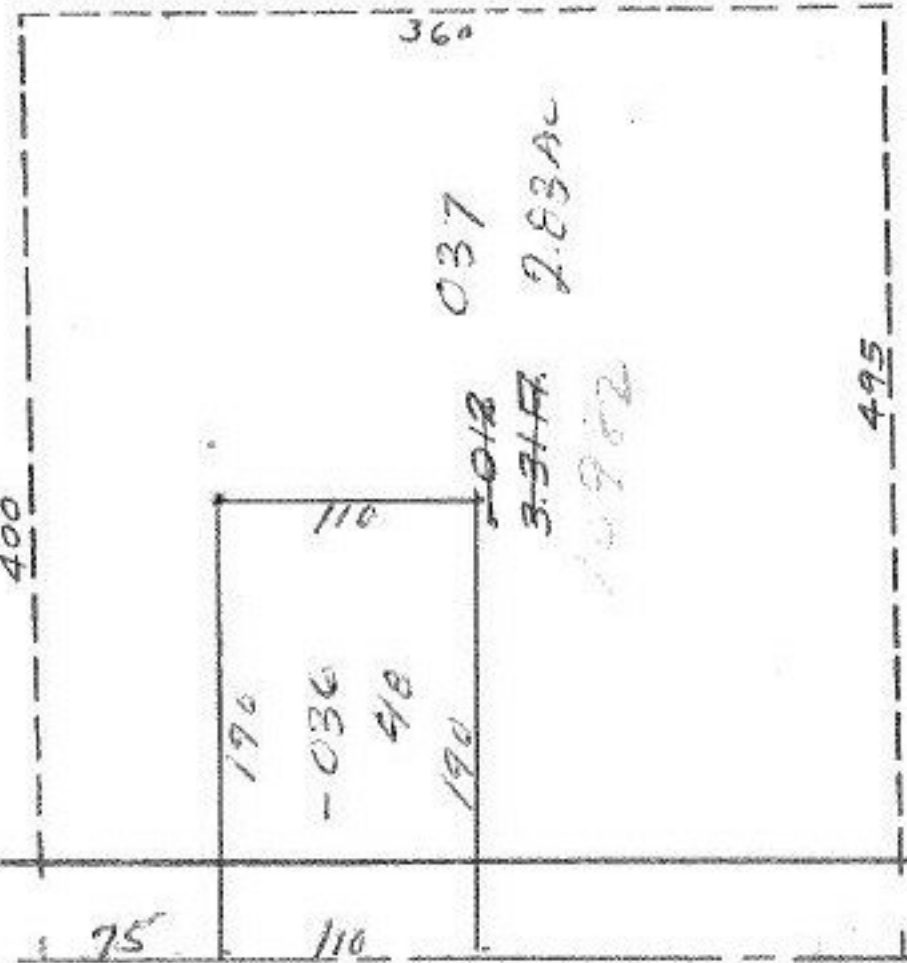

WALKER

N LAKE CITY

SEE 4-

100'

W