




RASTER

PARENT PARCEL: 04-00-021-000-035

CHILD PARCEL: 04-00-021-000-269, -270

STARTING POINT: CENTERLINE OF NAGEL RD & O.L. 21

11-00220

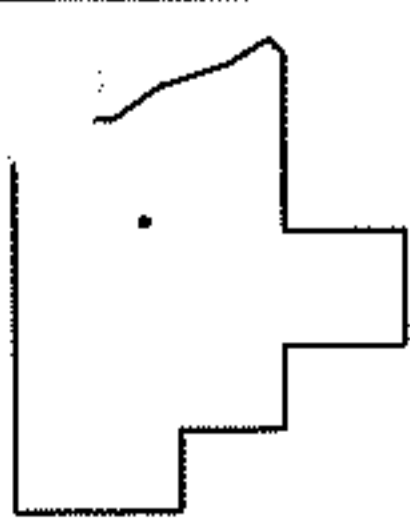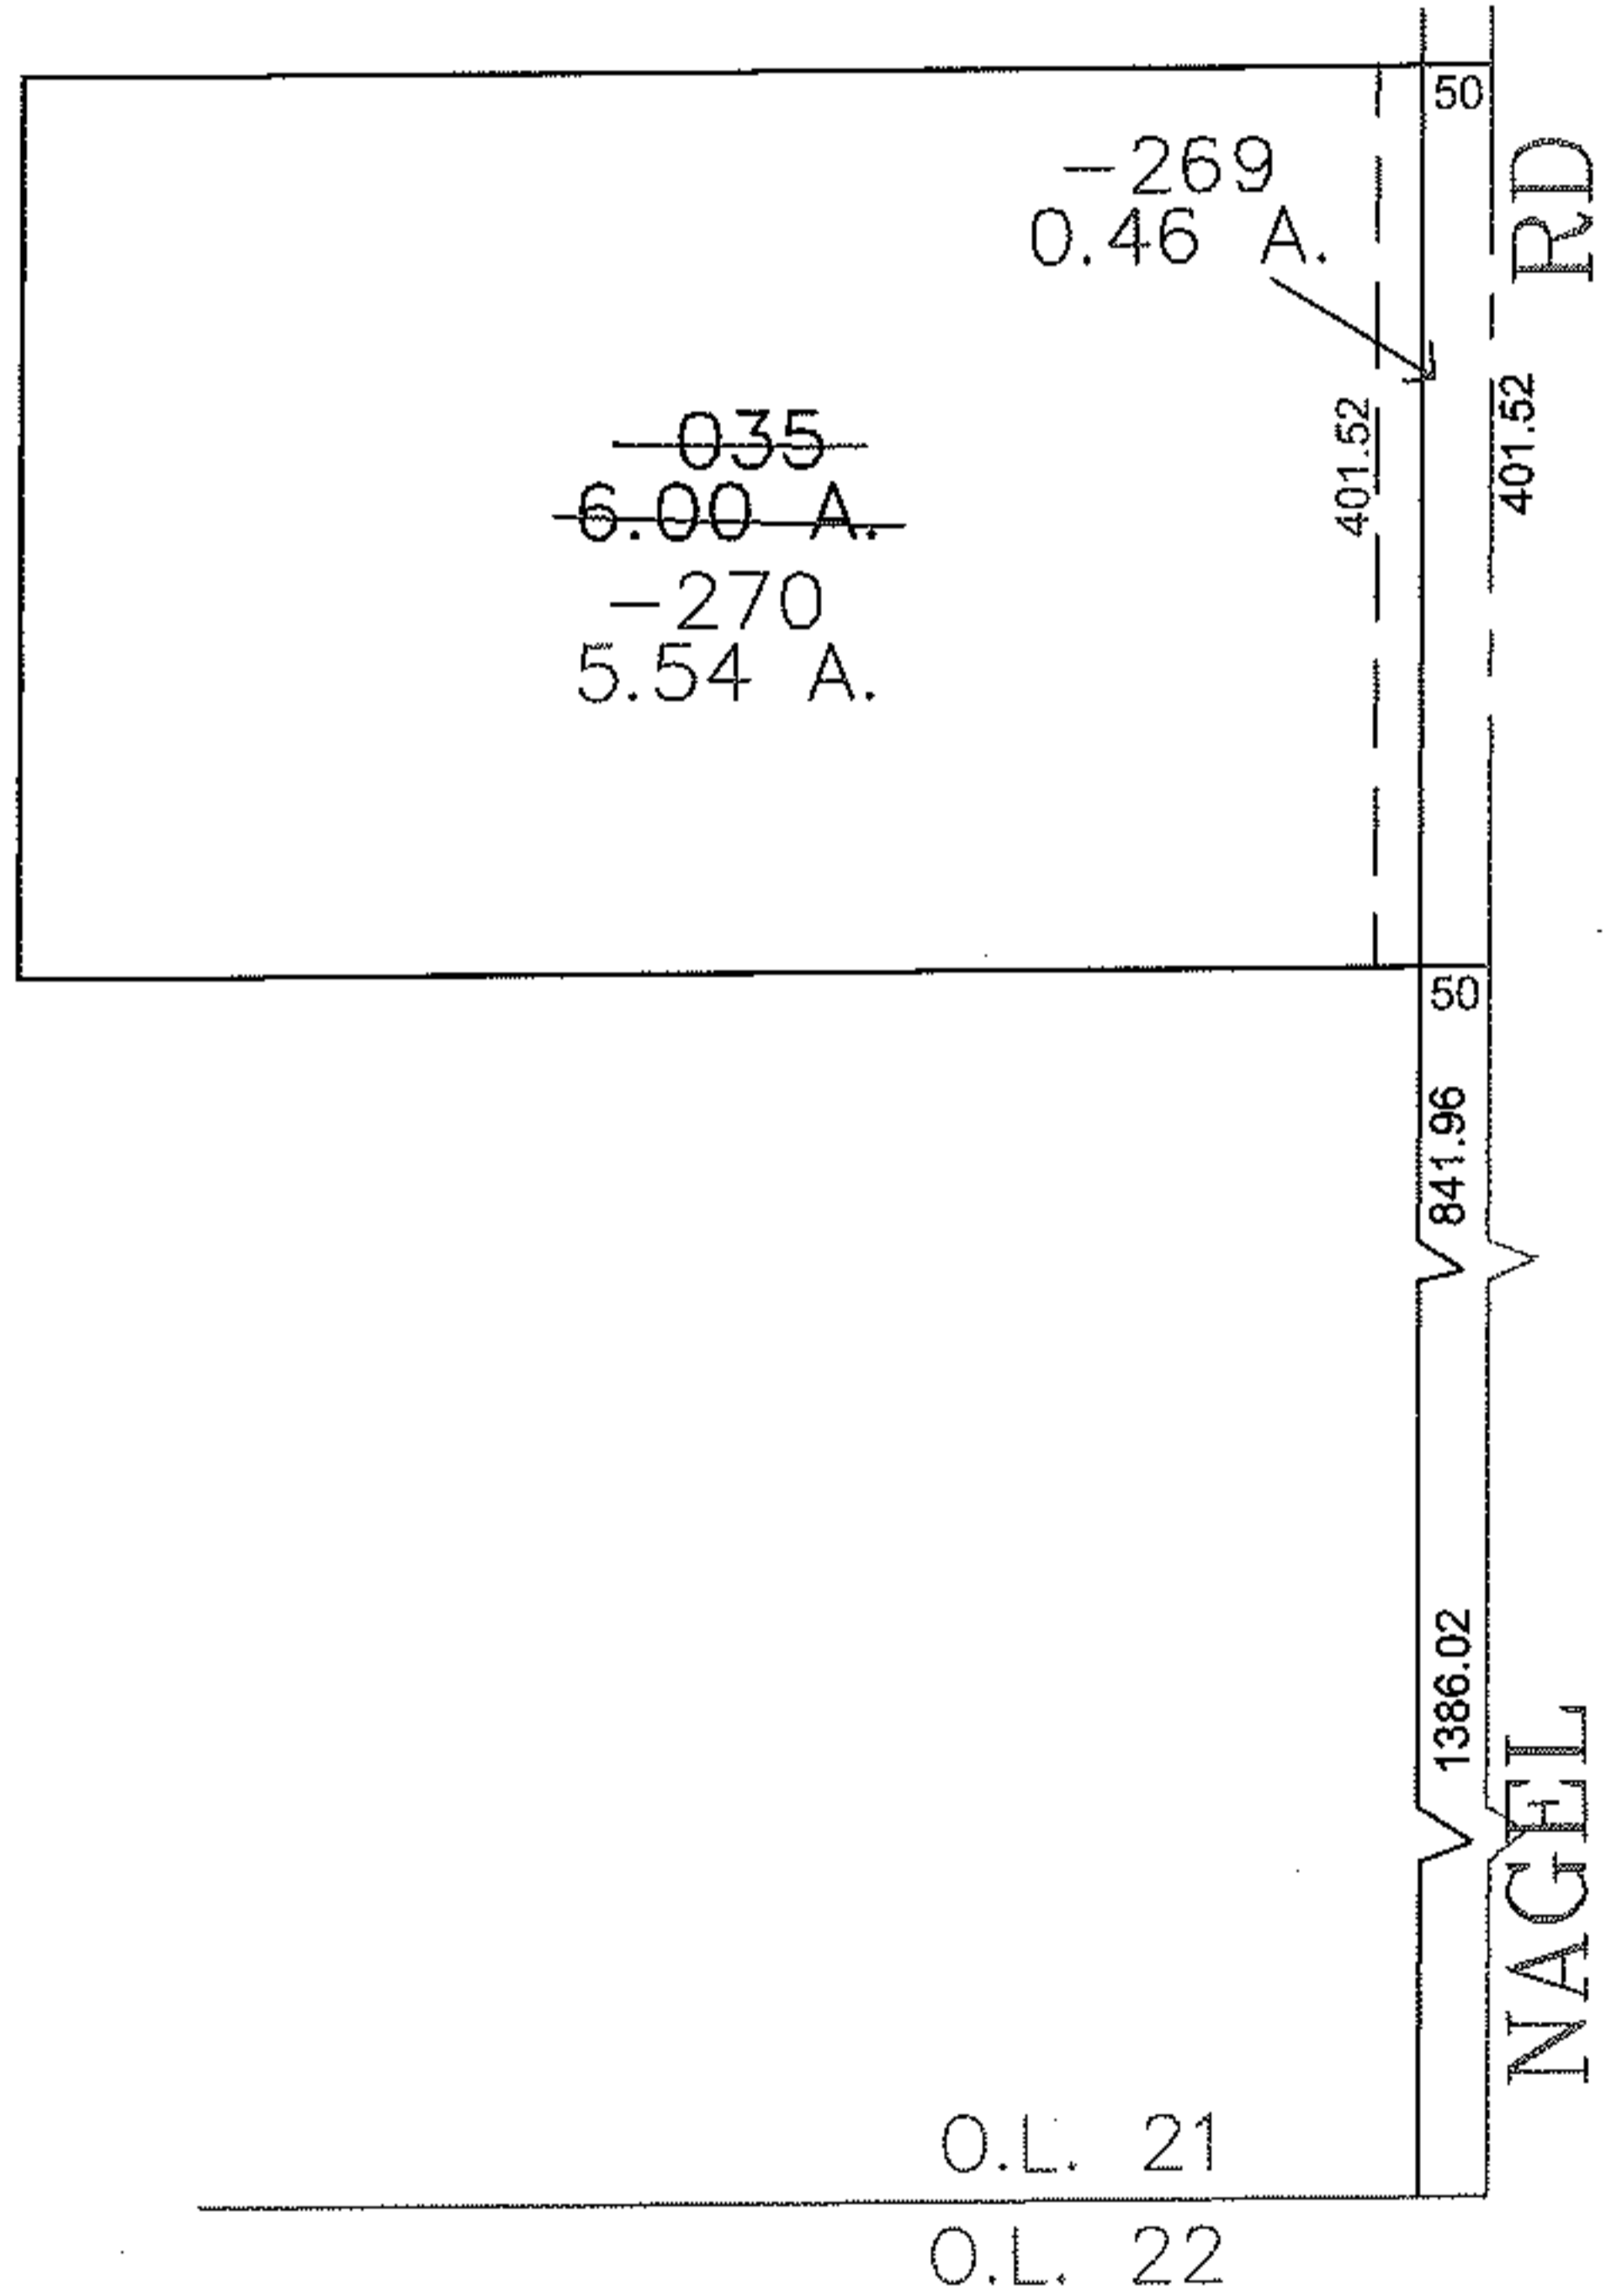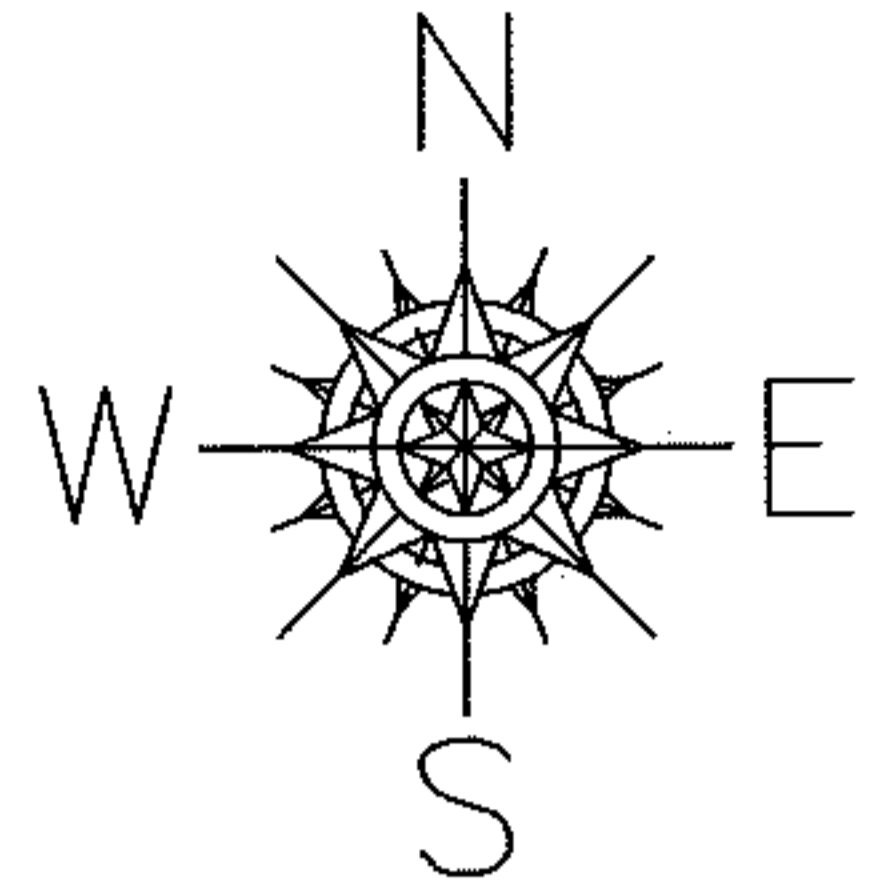

SPLITS/DEEDS PROCESSED
 LORAIN COUNTY TAX MAP DEPARTMENT
 226 MIDDLE AVE. ELYRIA, OHIO

SURVEYED BY: WILLIAM J SALA
 CLOSURE: 0.00 : 10,000
 MAP PAGE(S): 04-00-021-H
 APPROVED BY: JAH DATE: 1/10/2011
 SCALE: 1" = 200 PRIOR INSTRUMENT: 20080237765