



RASTER

PARENT PARCEL: 04-00-021-000-272

CHILD PARCEL: 04-00-021-000-274, -275

STARTING POINT: XXXXXX

11-00223

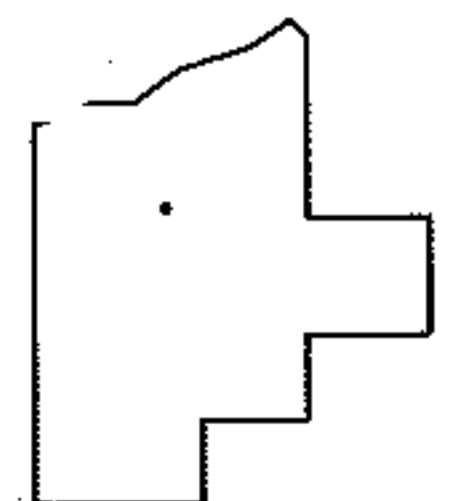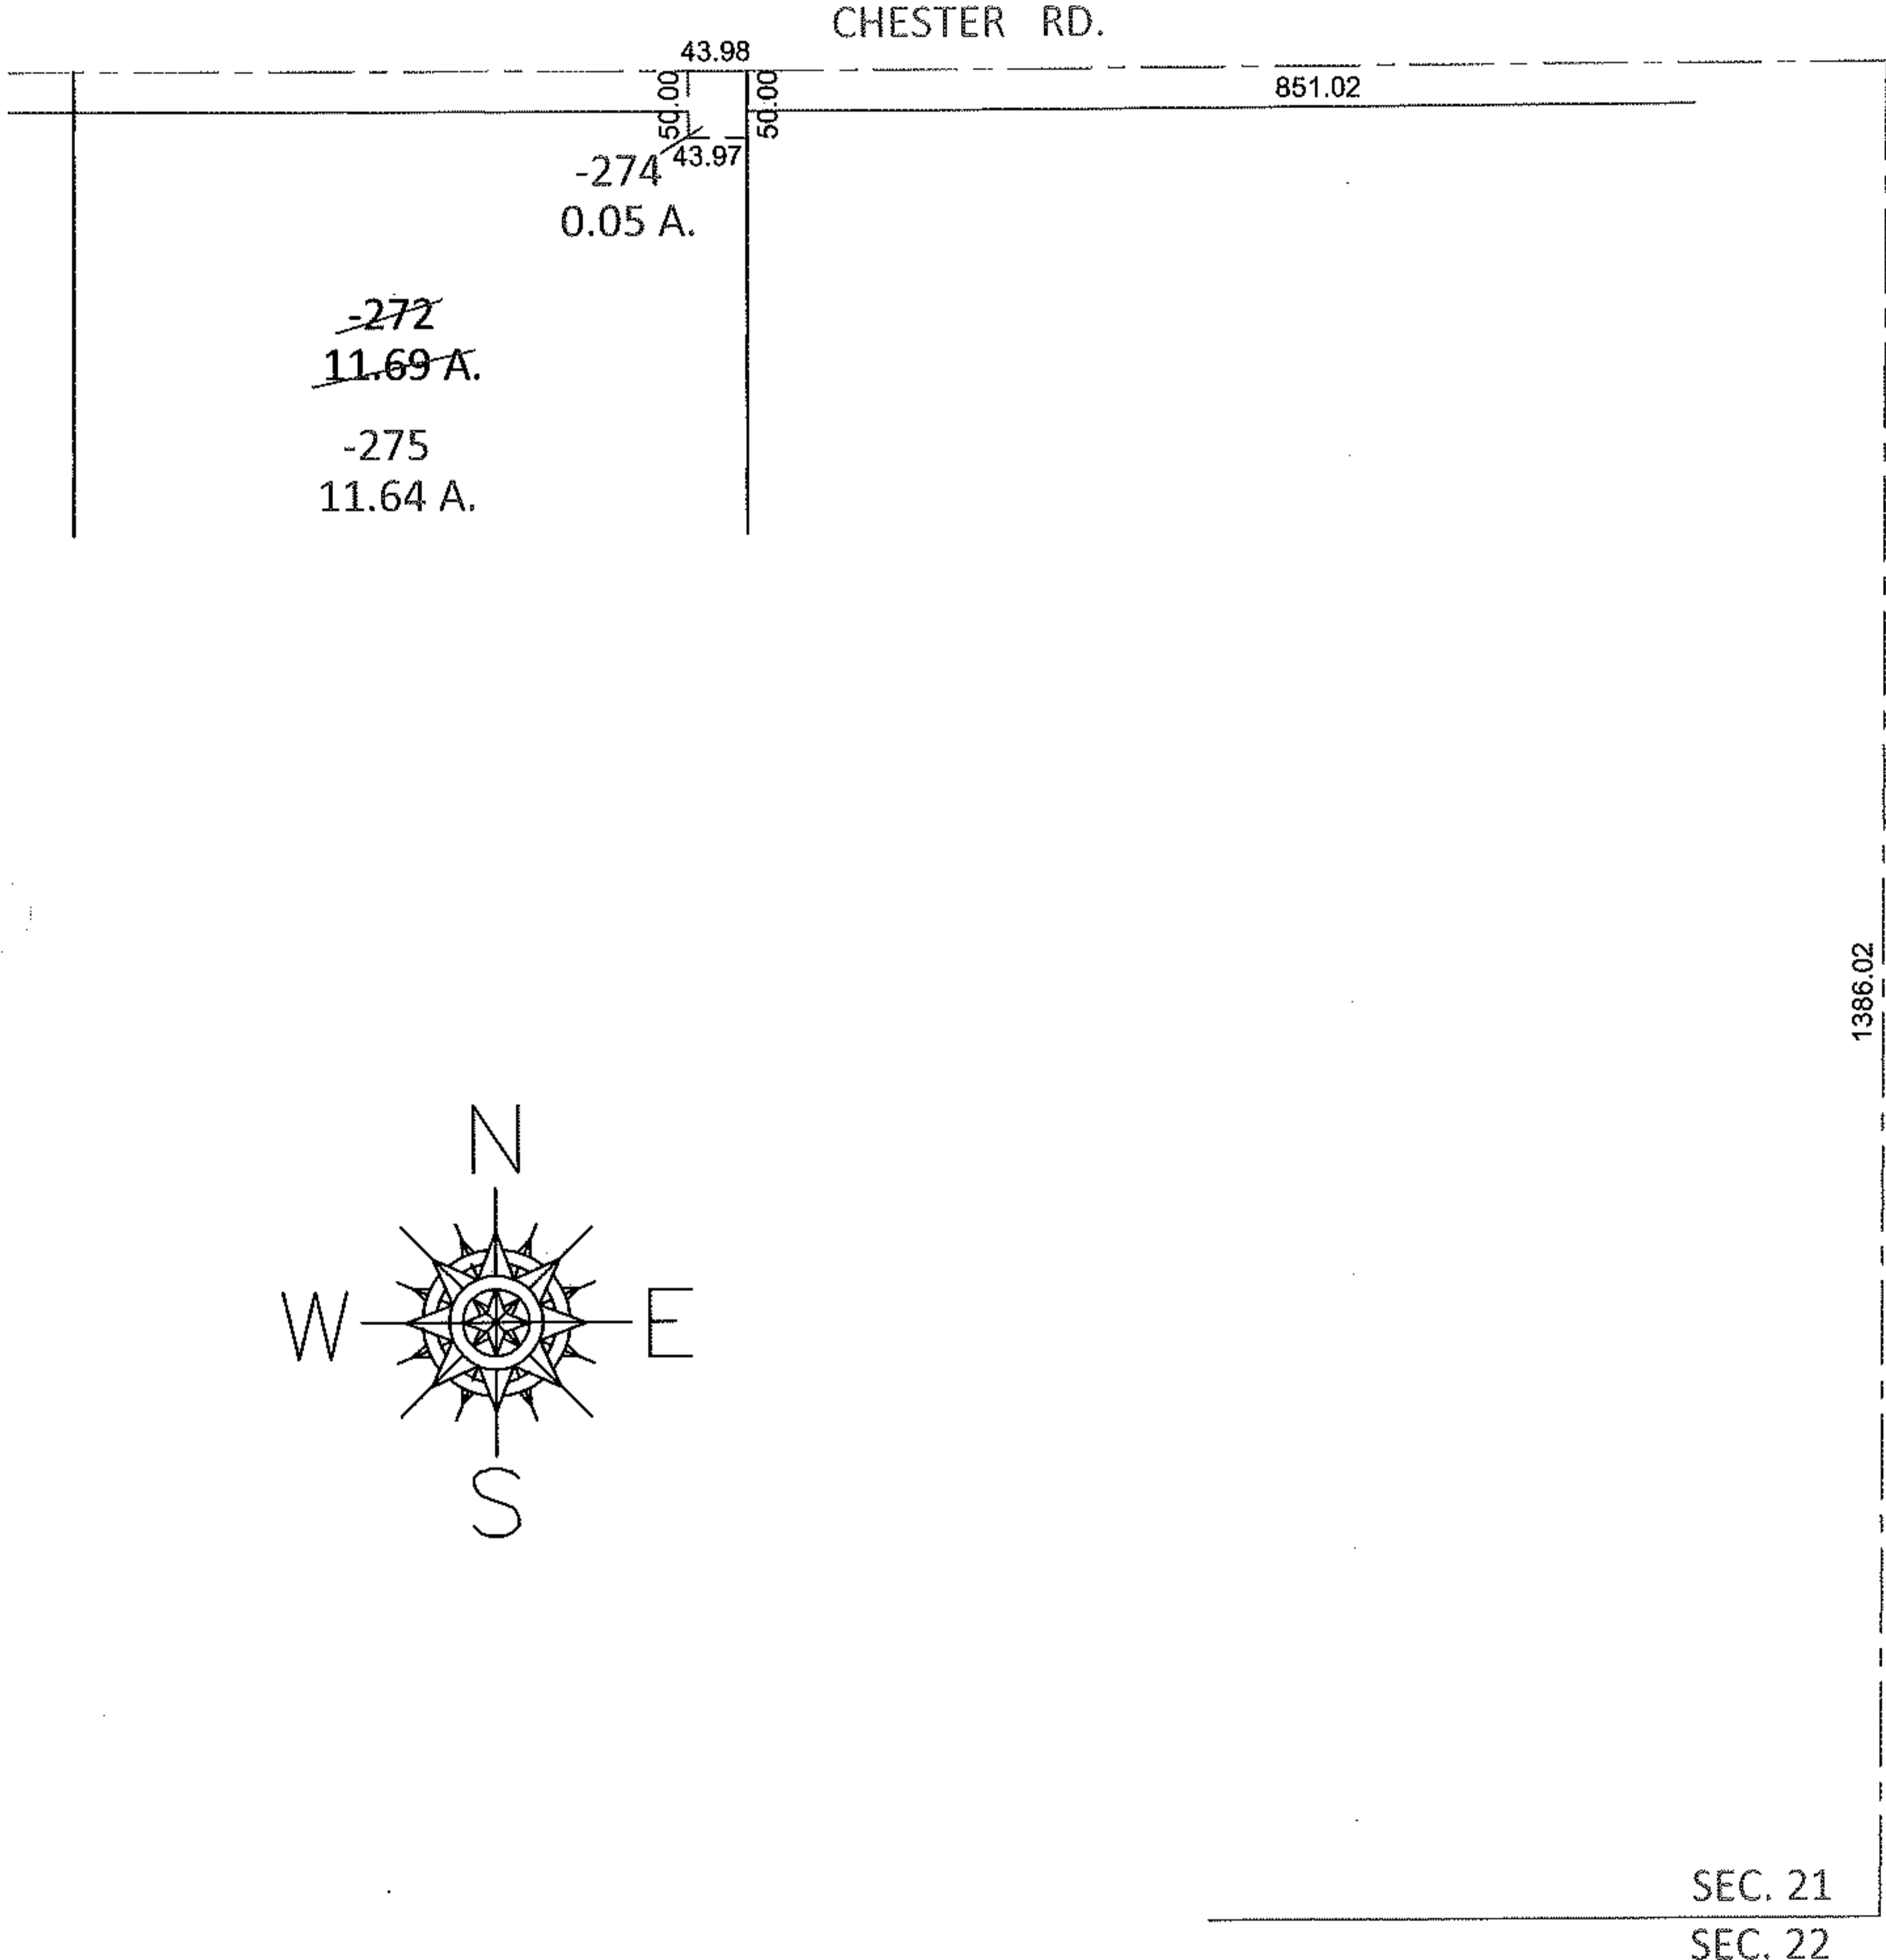

SPLITS/DEEDS PROCESSED

LORAIN COUNTY TAX MAP DEPARTMENT
226 MIDDLE AVE. ELYRIA, OHIO

SURVEYED BY: WILLIAM J. SALA

CLOSURE: .00:10,000

MAP PAGE(S): 4-00-021-H

APPROVED BY: RRM DATE: 1-11-11

SCALE: 1"= 200 PRIOR INST.: 20060166305