


PARENT PARCEL: 04-00-028-102-058, -057



CHILD PARCEL: 04-00-028-102-164 THRU -166

STARTING POINT: CENTERLINE OF NAGEL RD & O.L. 28

11-00225

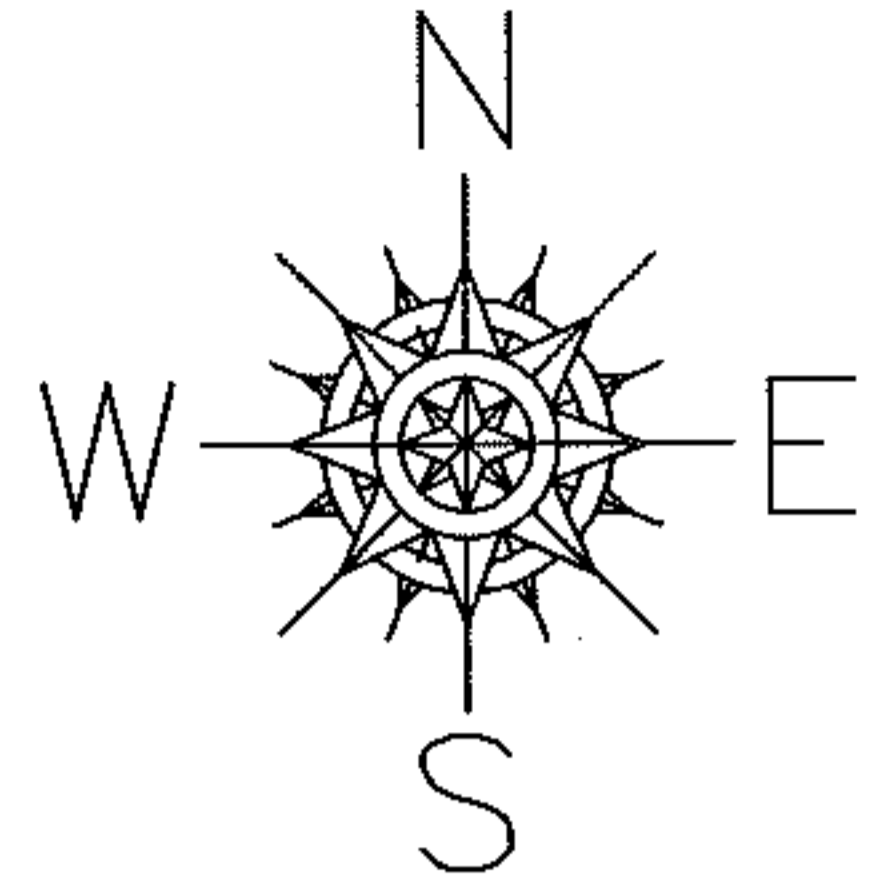

NAGEL RD

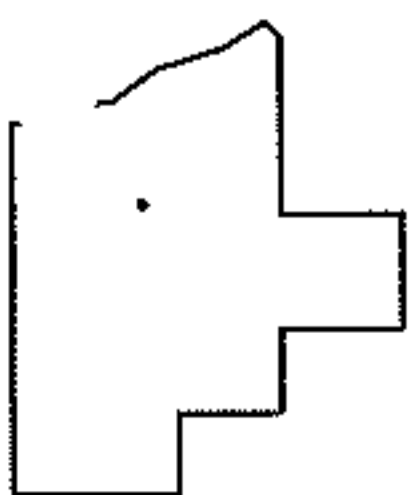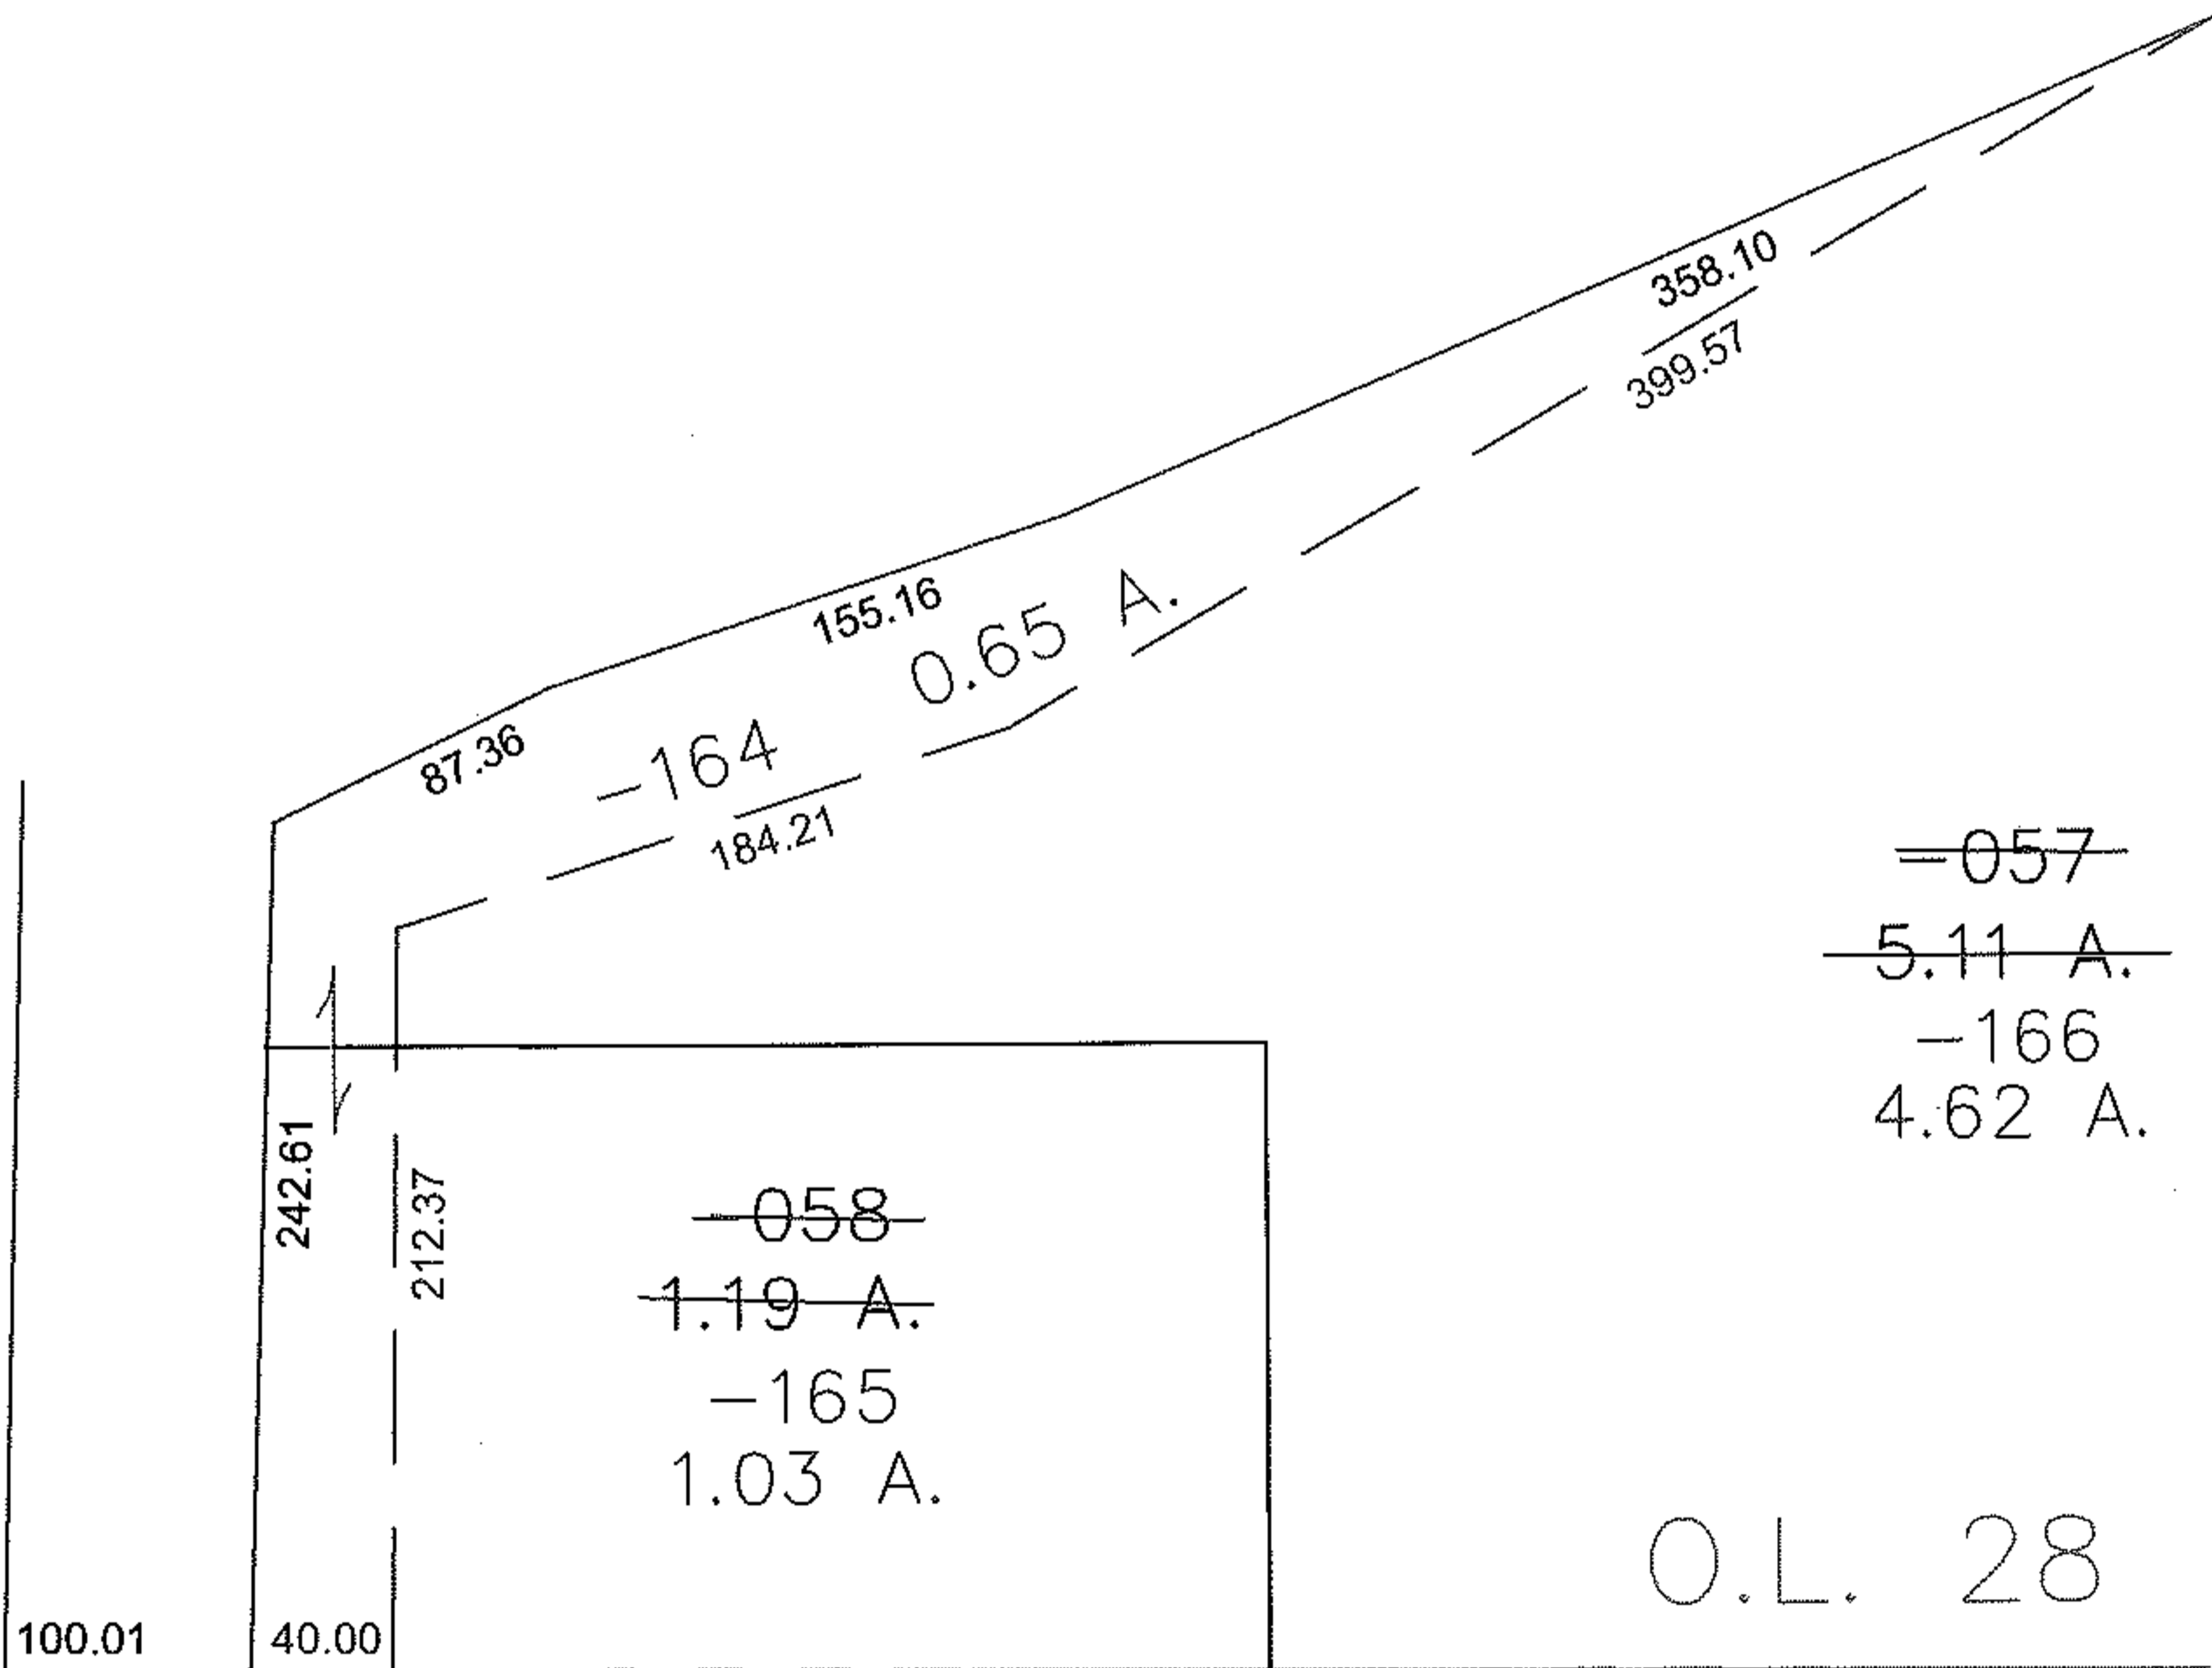

**SPLITS/DEEDS PROCESSED**

LORAIN COUNTY TAX MAP DEPARTMENT  
226 MIDDLE AVE. ELYRIA, OHIO

SURVEYED BY: WILLIAM J SALA

CLOSURE: 0.00 : 10.000

MAP PAGE(S): 04-00-028-E

APPROVED BY: JAH DATE: 3/3/2011

SCALE: 1" = 100' PRIOR INSTRUMENT: 20080248079