
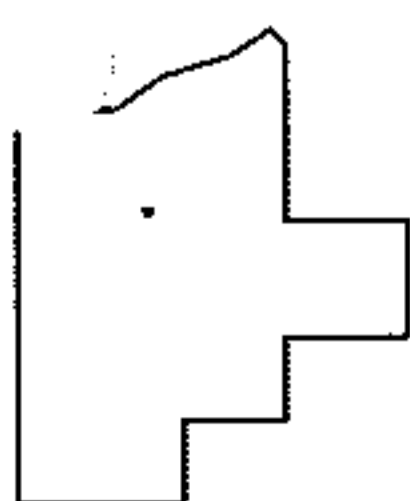
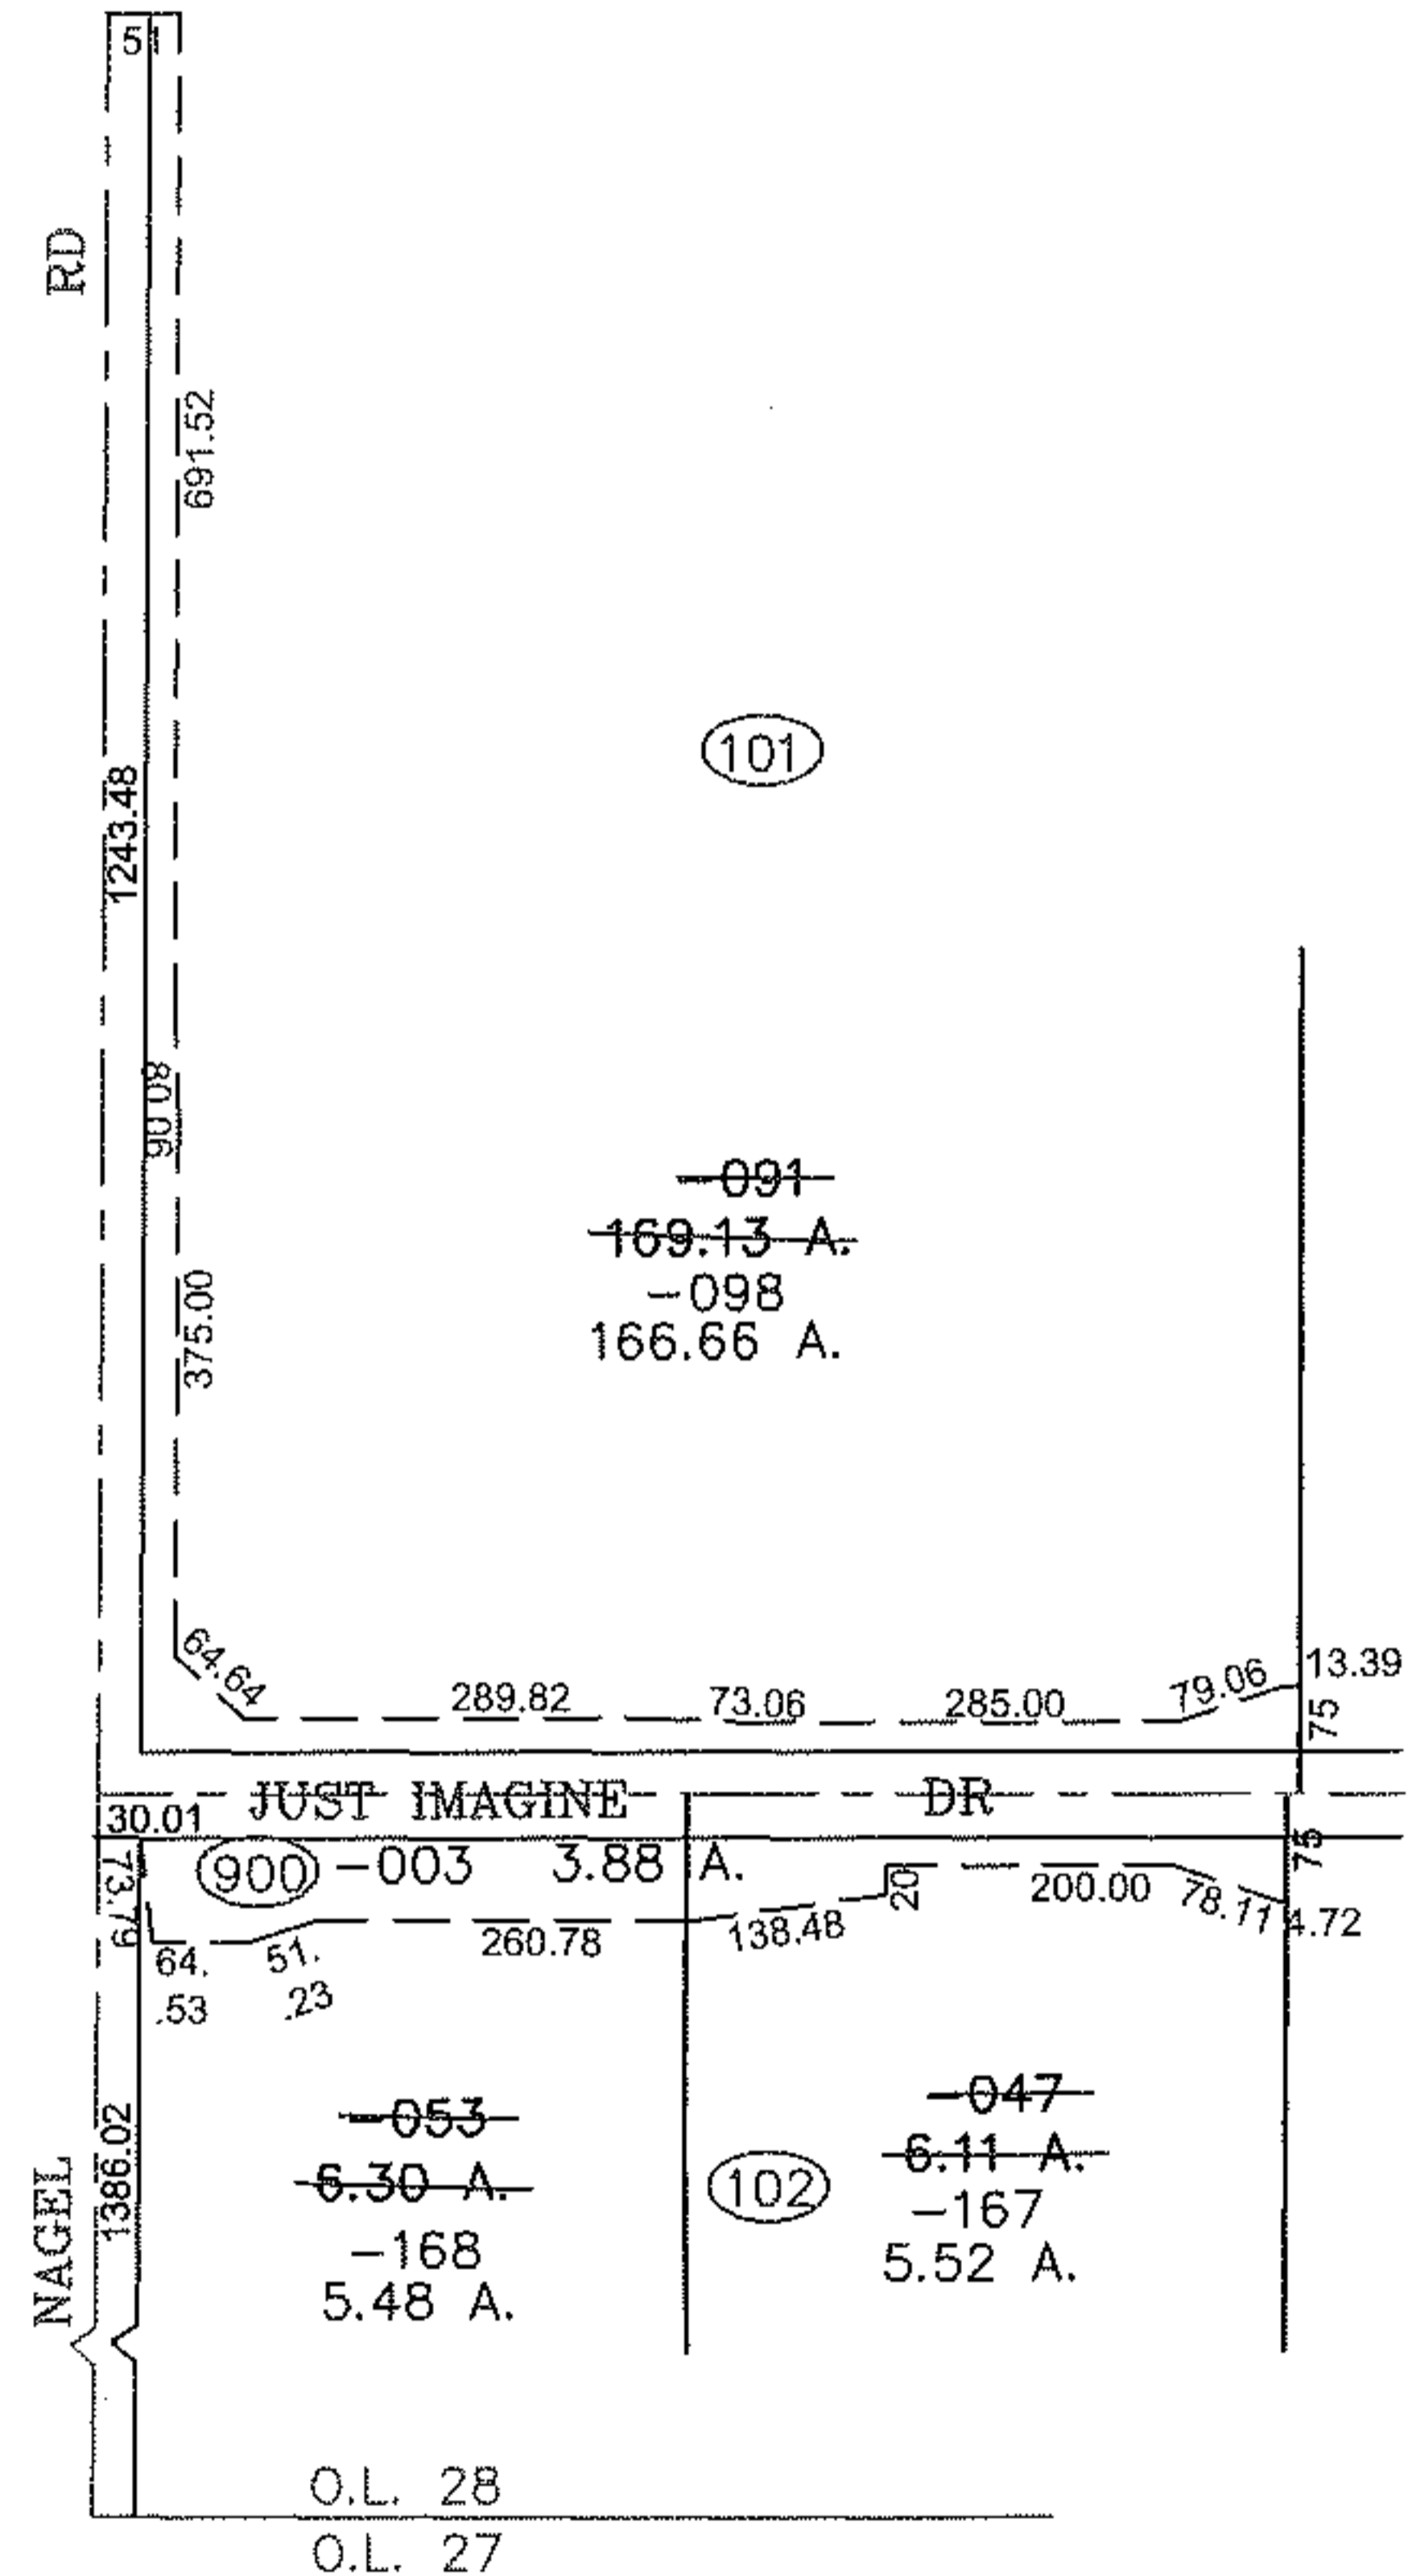


PARENT PARCEL: 04-00-028-102-047, -053 04-00-028-101-091

CHILD PARCEL: 04-00-028-900-003, 04-00-028-102-167, 168 04-00-028-101-098

11-00226

STARTING POINT: CENTERLINE OF NAGEL RD & O.L. 28

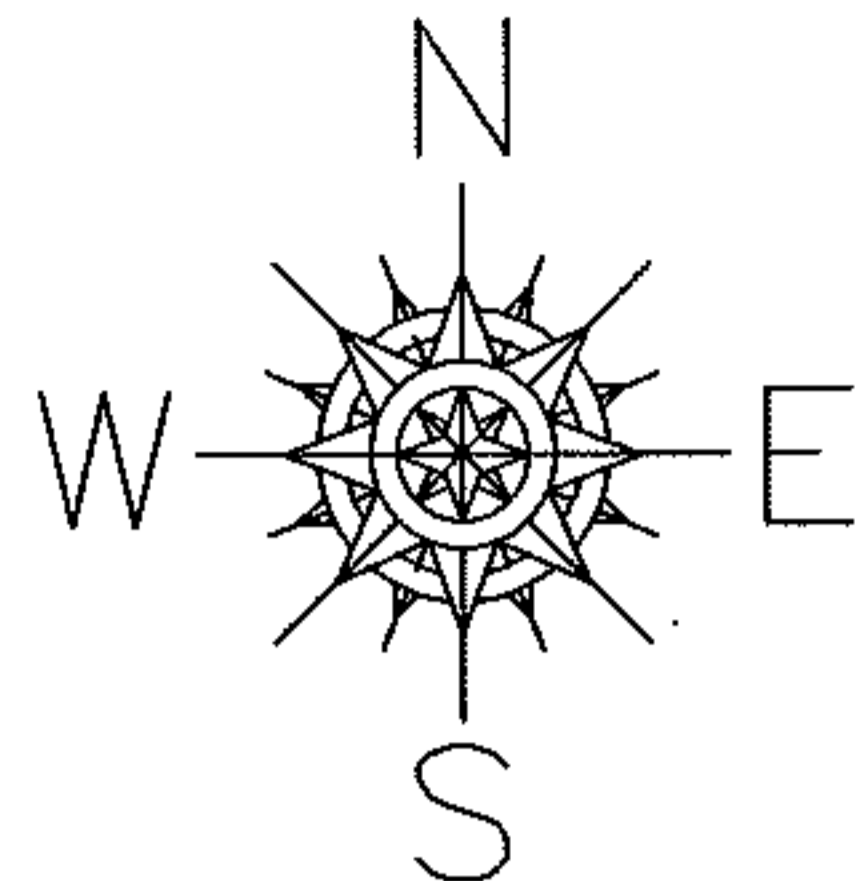

**SPLITS/DEEDS PROCESSED**  
**LORAIN COUNTY TAX MAP DEPARTMENT**  
 226 MIDDLE AVE. ELYRIA, OHIO

SURVEYED BY: WILLIAM J SALA  
 CLOSURE: 0.00 : 10,000  
 MAP PAGE(S): 04-00-028-E  
 APPROVED BY: JAH DATE: 3-3-2011  
 SCALE: 1" = 300 PRIOR INSTRUMENT: 20060133905