
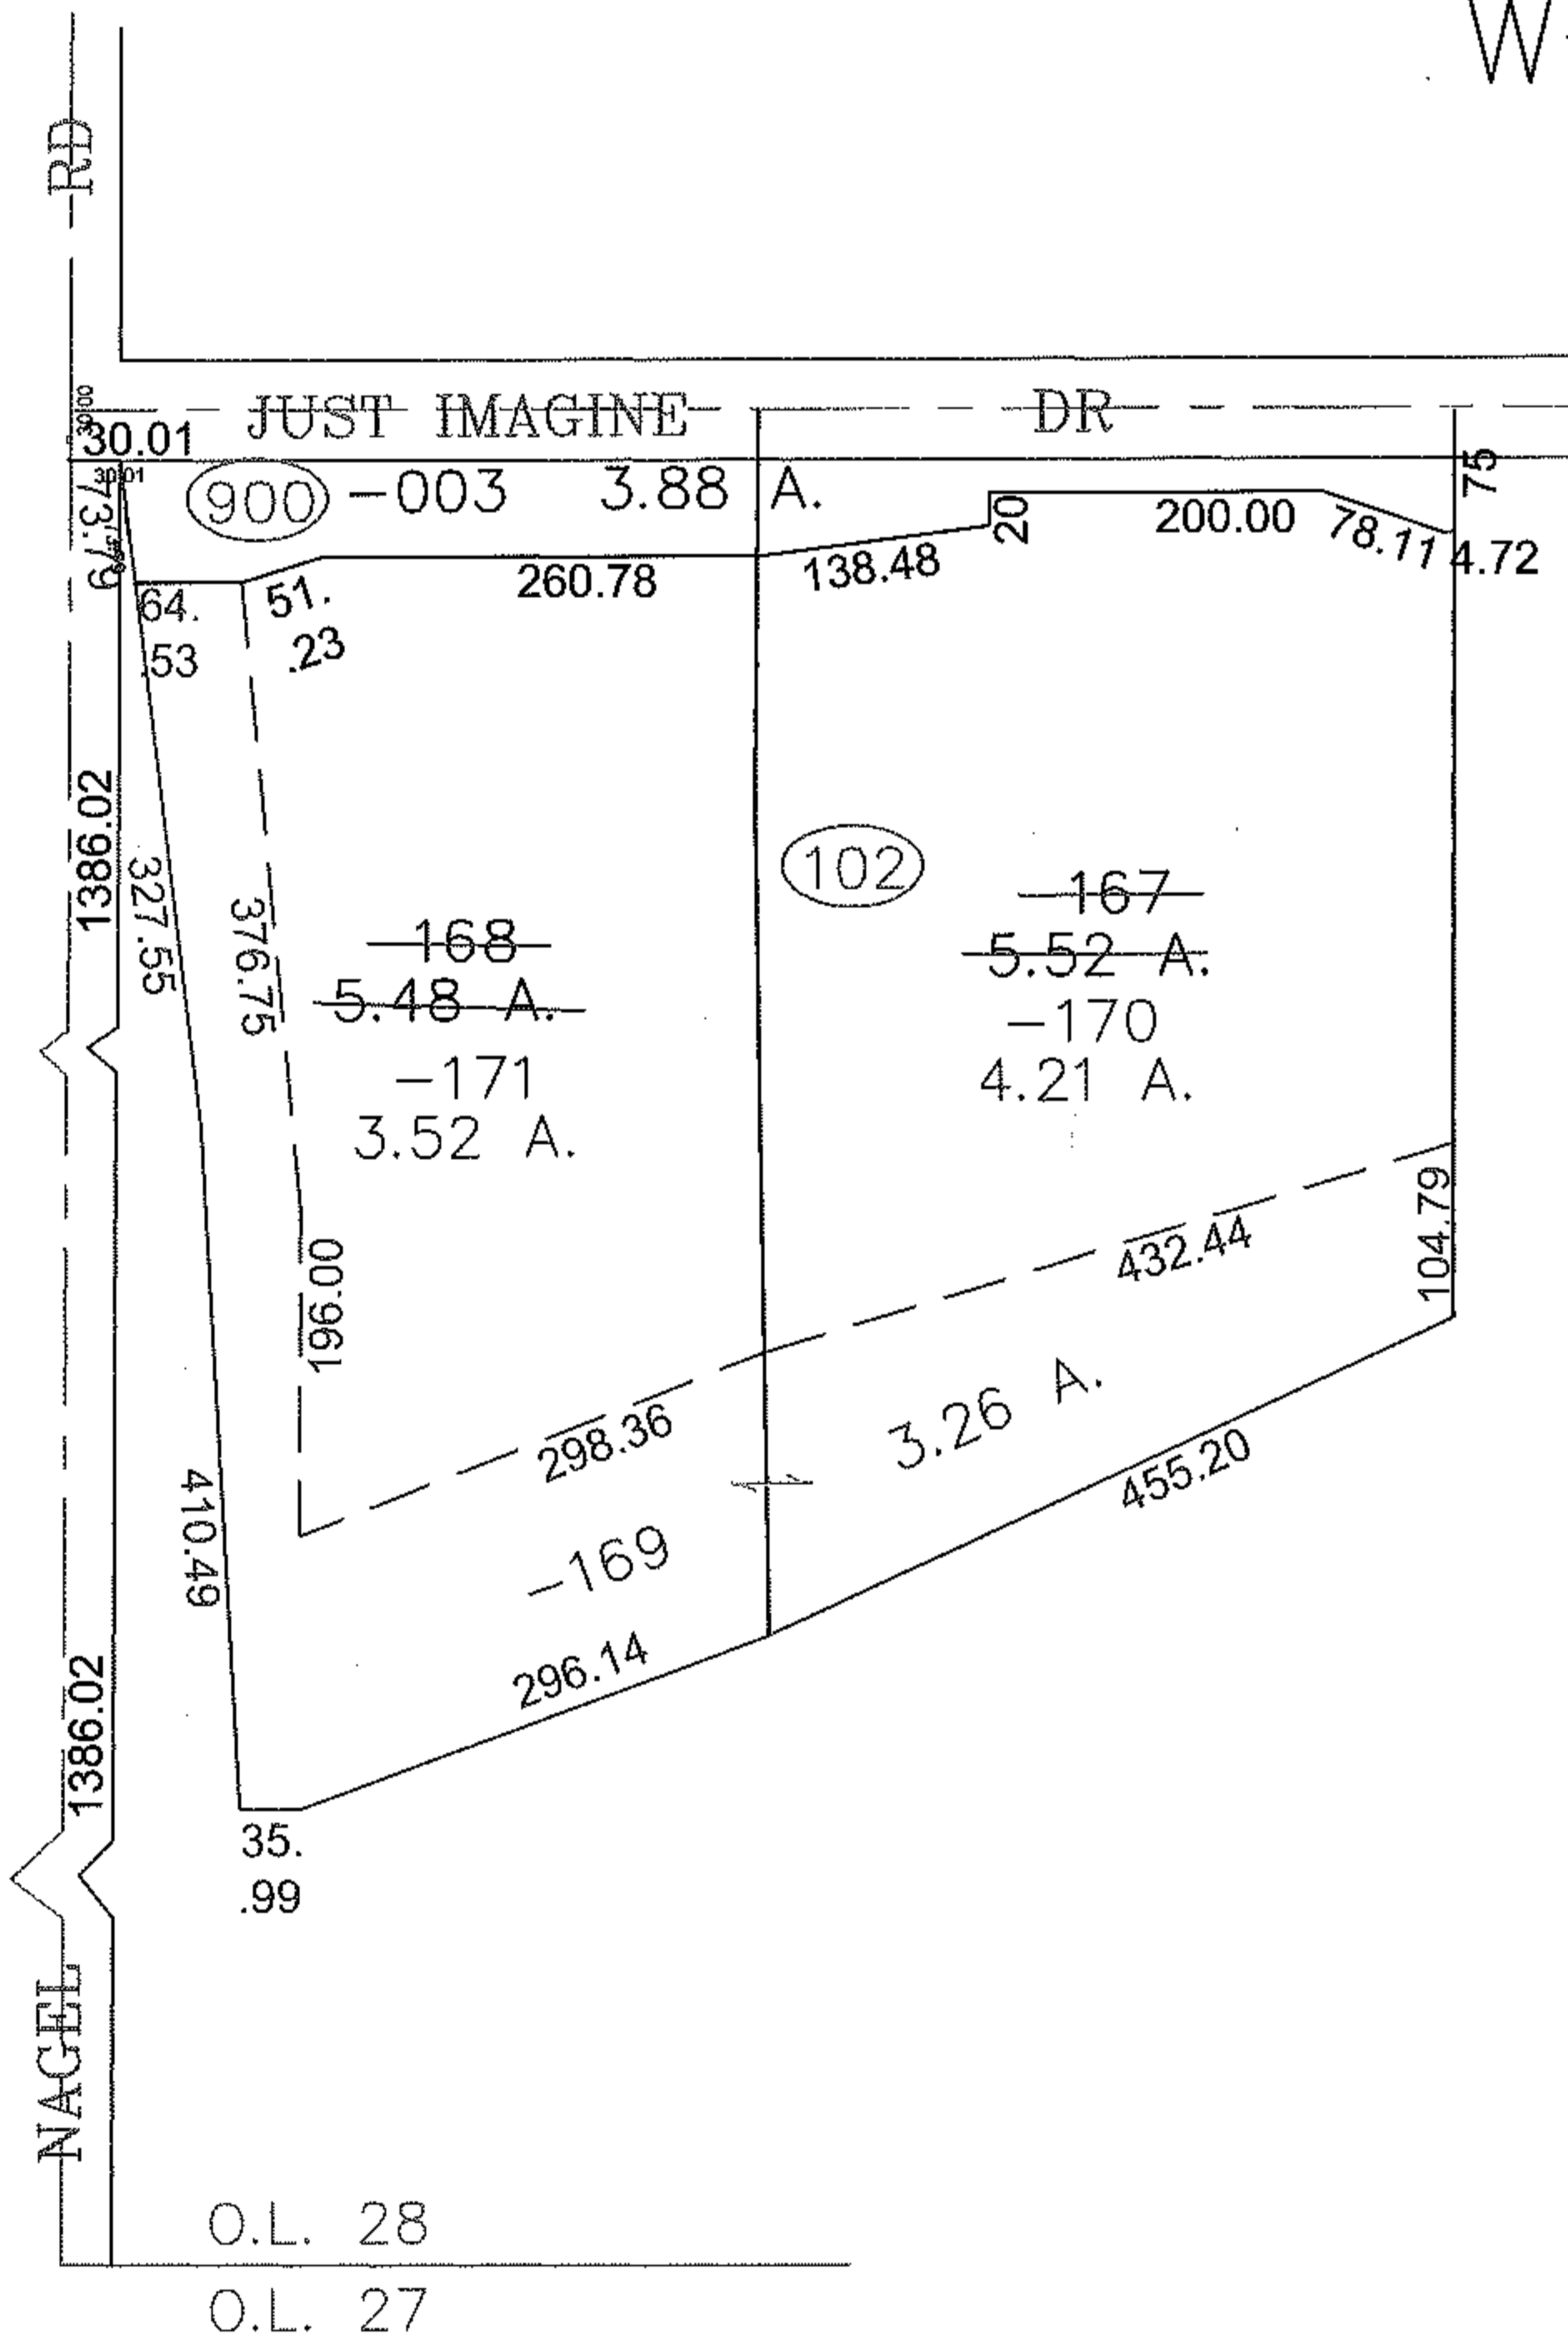


PARENT PARCEL: 04-00-028-102-167, -168

CHILD PARCEL: 04-00-028-102-169 THRU -171

11-00227

STARTING POINT: CENTERLINE OF NAGEL RD & O.L. 28

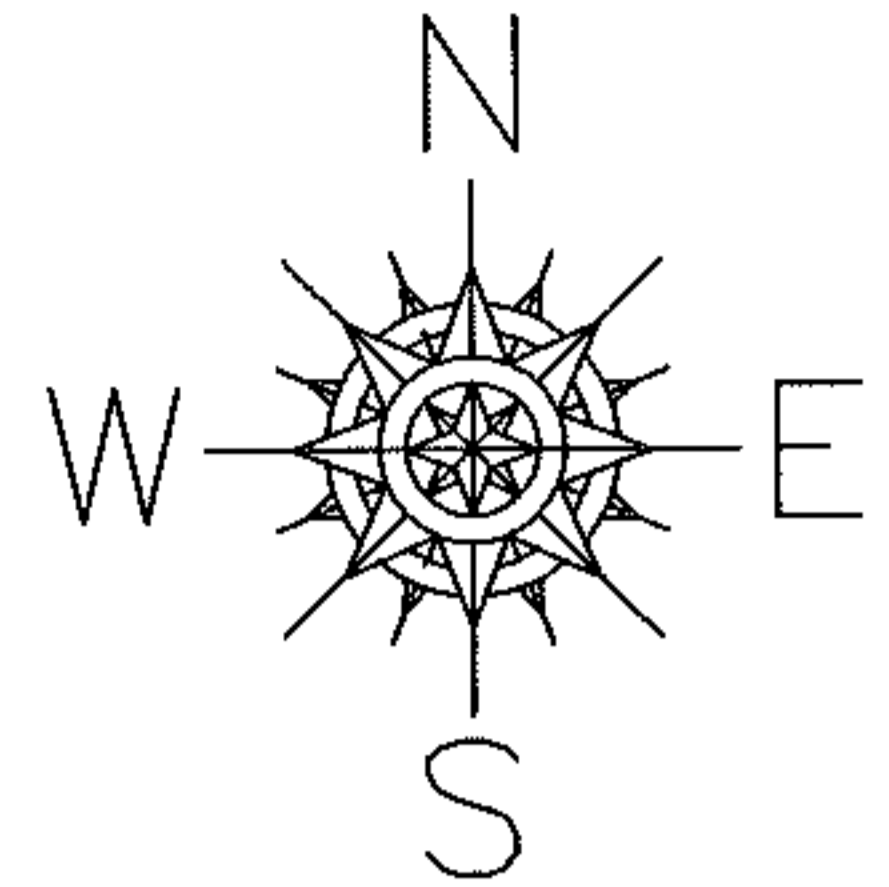

SPLITS/DEEDS PROCESSED
 LORAIN COUNTY TAX MAP DEPARTMENT
 226 MIDDLE AVE. ELYRIA, OHIO

SURVEYED BY: WILLIAM J SALA
 CLOSURE: 0.00 : 10,000
 MAP PAGE(S): 04-00-028-E
 APPROVED BY: JAH DATE: 3-4-2011
 SCALE: 1" = 200 PRIOR INSTRUMENT: 20060132374