
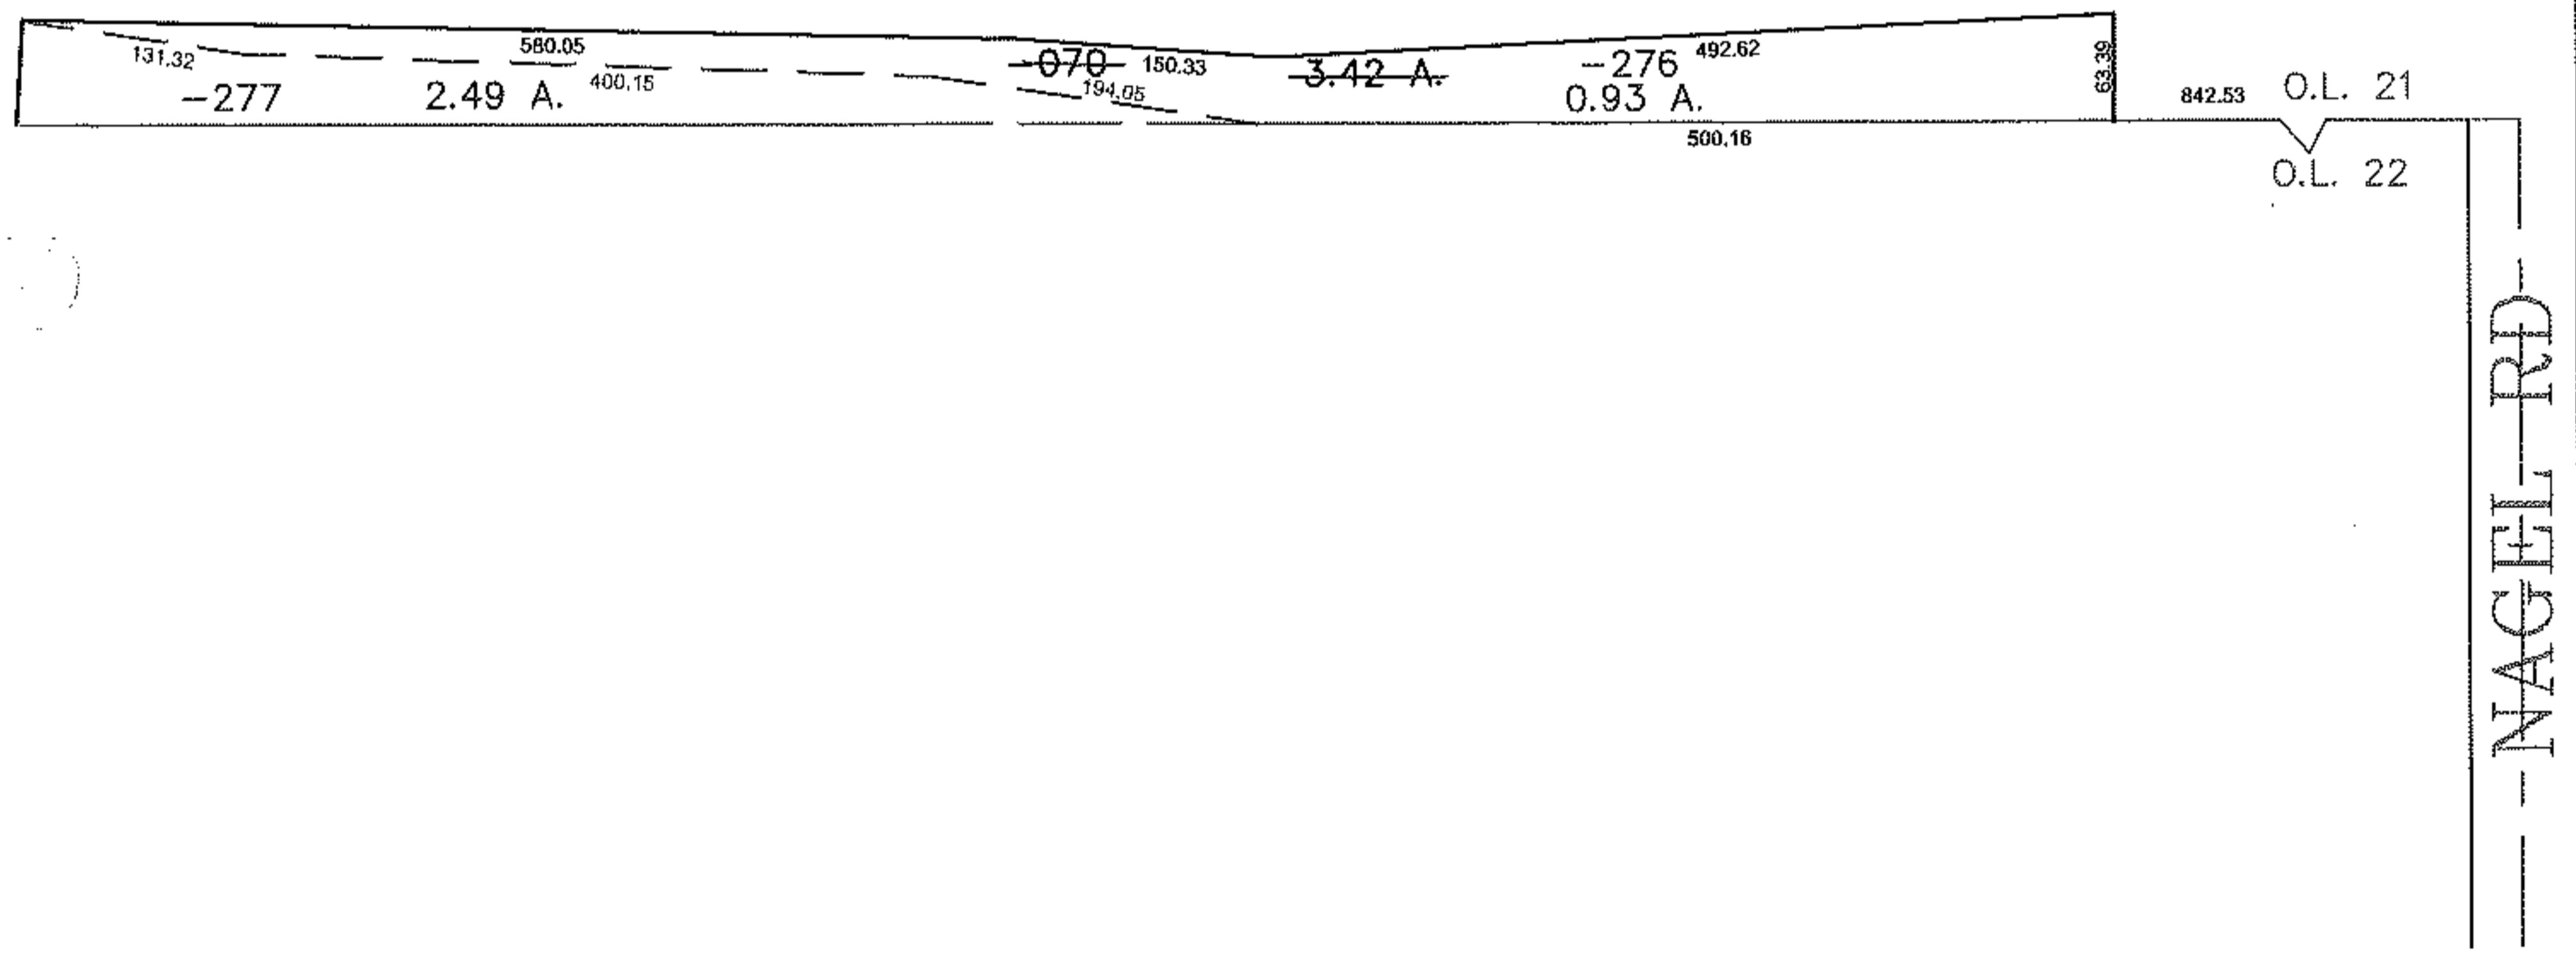


RASTER

PARENT PARCEL: 04-00-021-000-070  
CHILD PARCEL: 04-00-021-000-276, -277  
STARTING POINT: CENTERLINE OF NAGEL RD & O.L. 21

11-00228

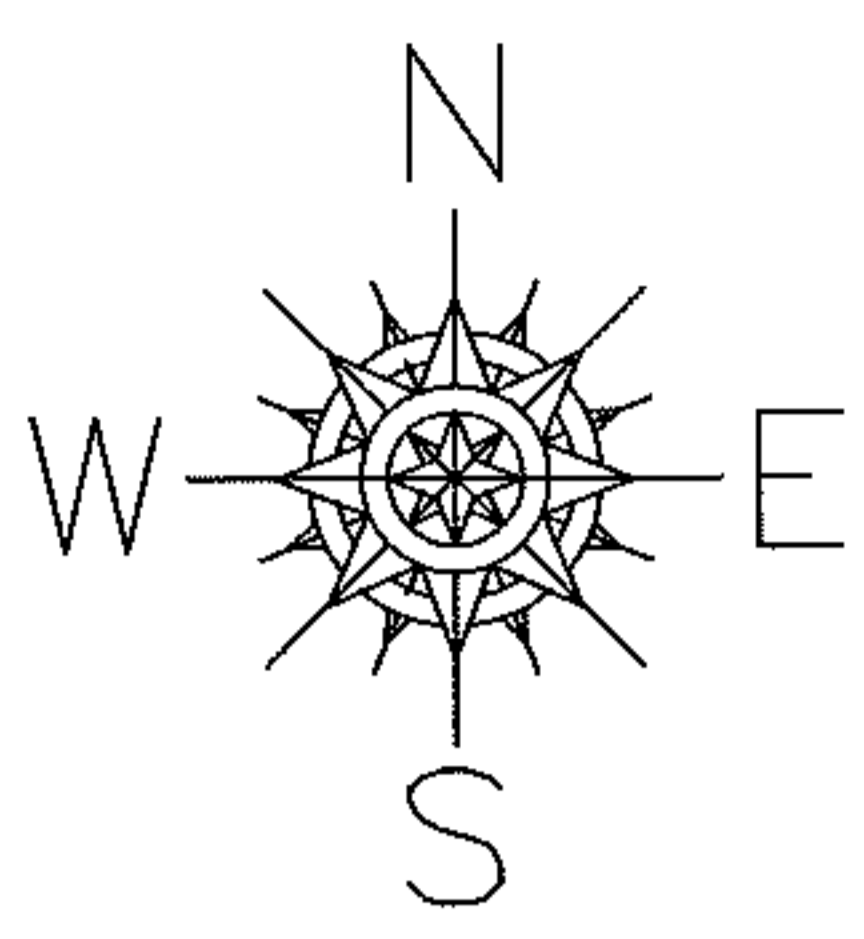

**SPLITS/DEEDS PROCESSED**  
LORAIN COUNTY TAX MAP DEPARTMENT  
226 MIDDLE AVE. ELYRIA, OHIO

SURVEYED BY: WILLIAM J SALA  
CLOSURE: 0.00 : 10,000  
MAP PAGE(S): 04-00-021-G  
APPROVED BY: JAH DATE: 5-13-2011  
SCALE: 1" = 200 PRIOR INSTRUMENT: 20110372363