


PARENT PARCEL: 04-00-028-102-008 & -064  
 CHILD PARCEL: 04-00-028-102-175 THRU -178  
 STARTING POINT: MONUMENT, S.W. CORNER OF SECTION 28

**11-00230**

JUST IMAGINE DR.

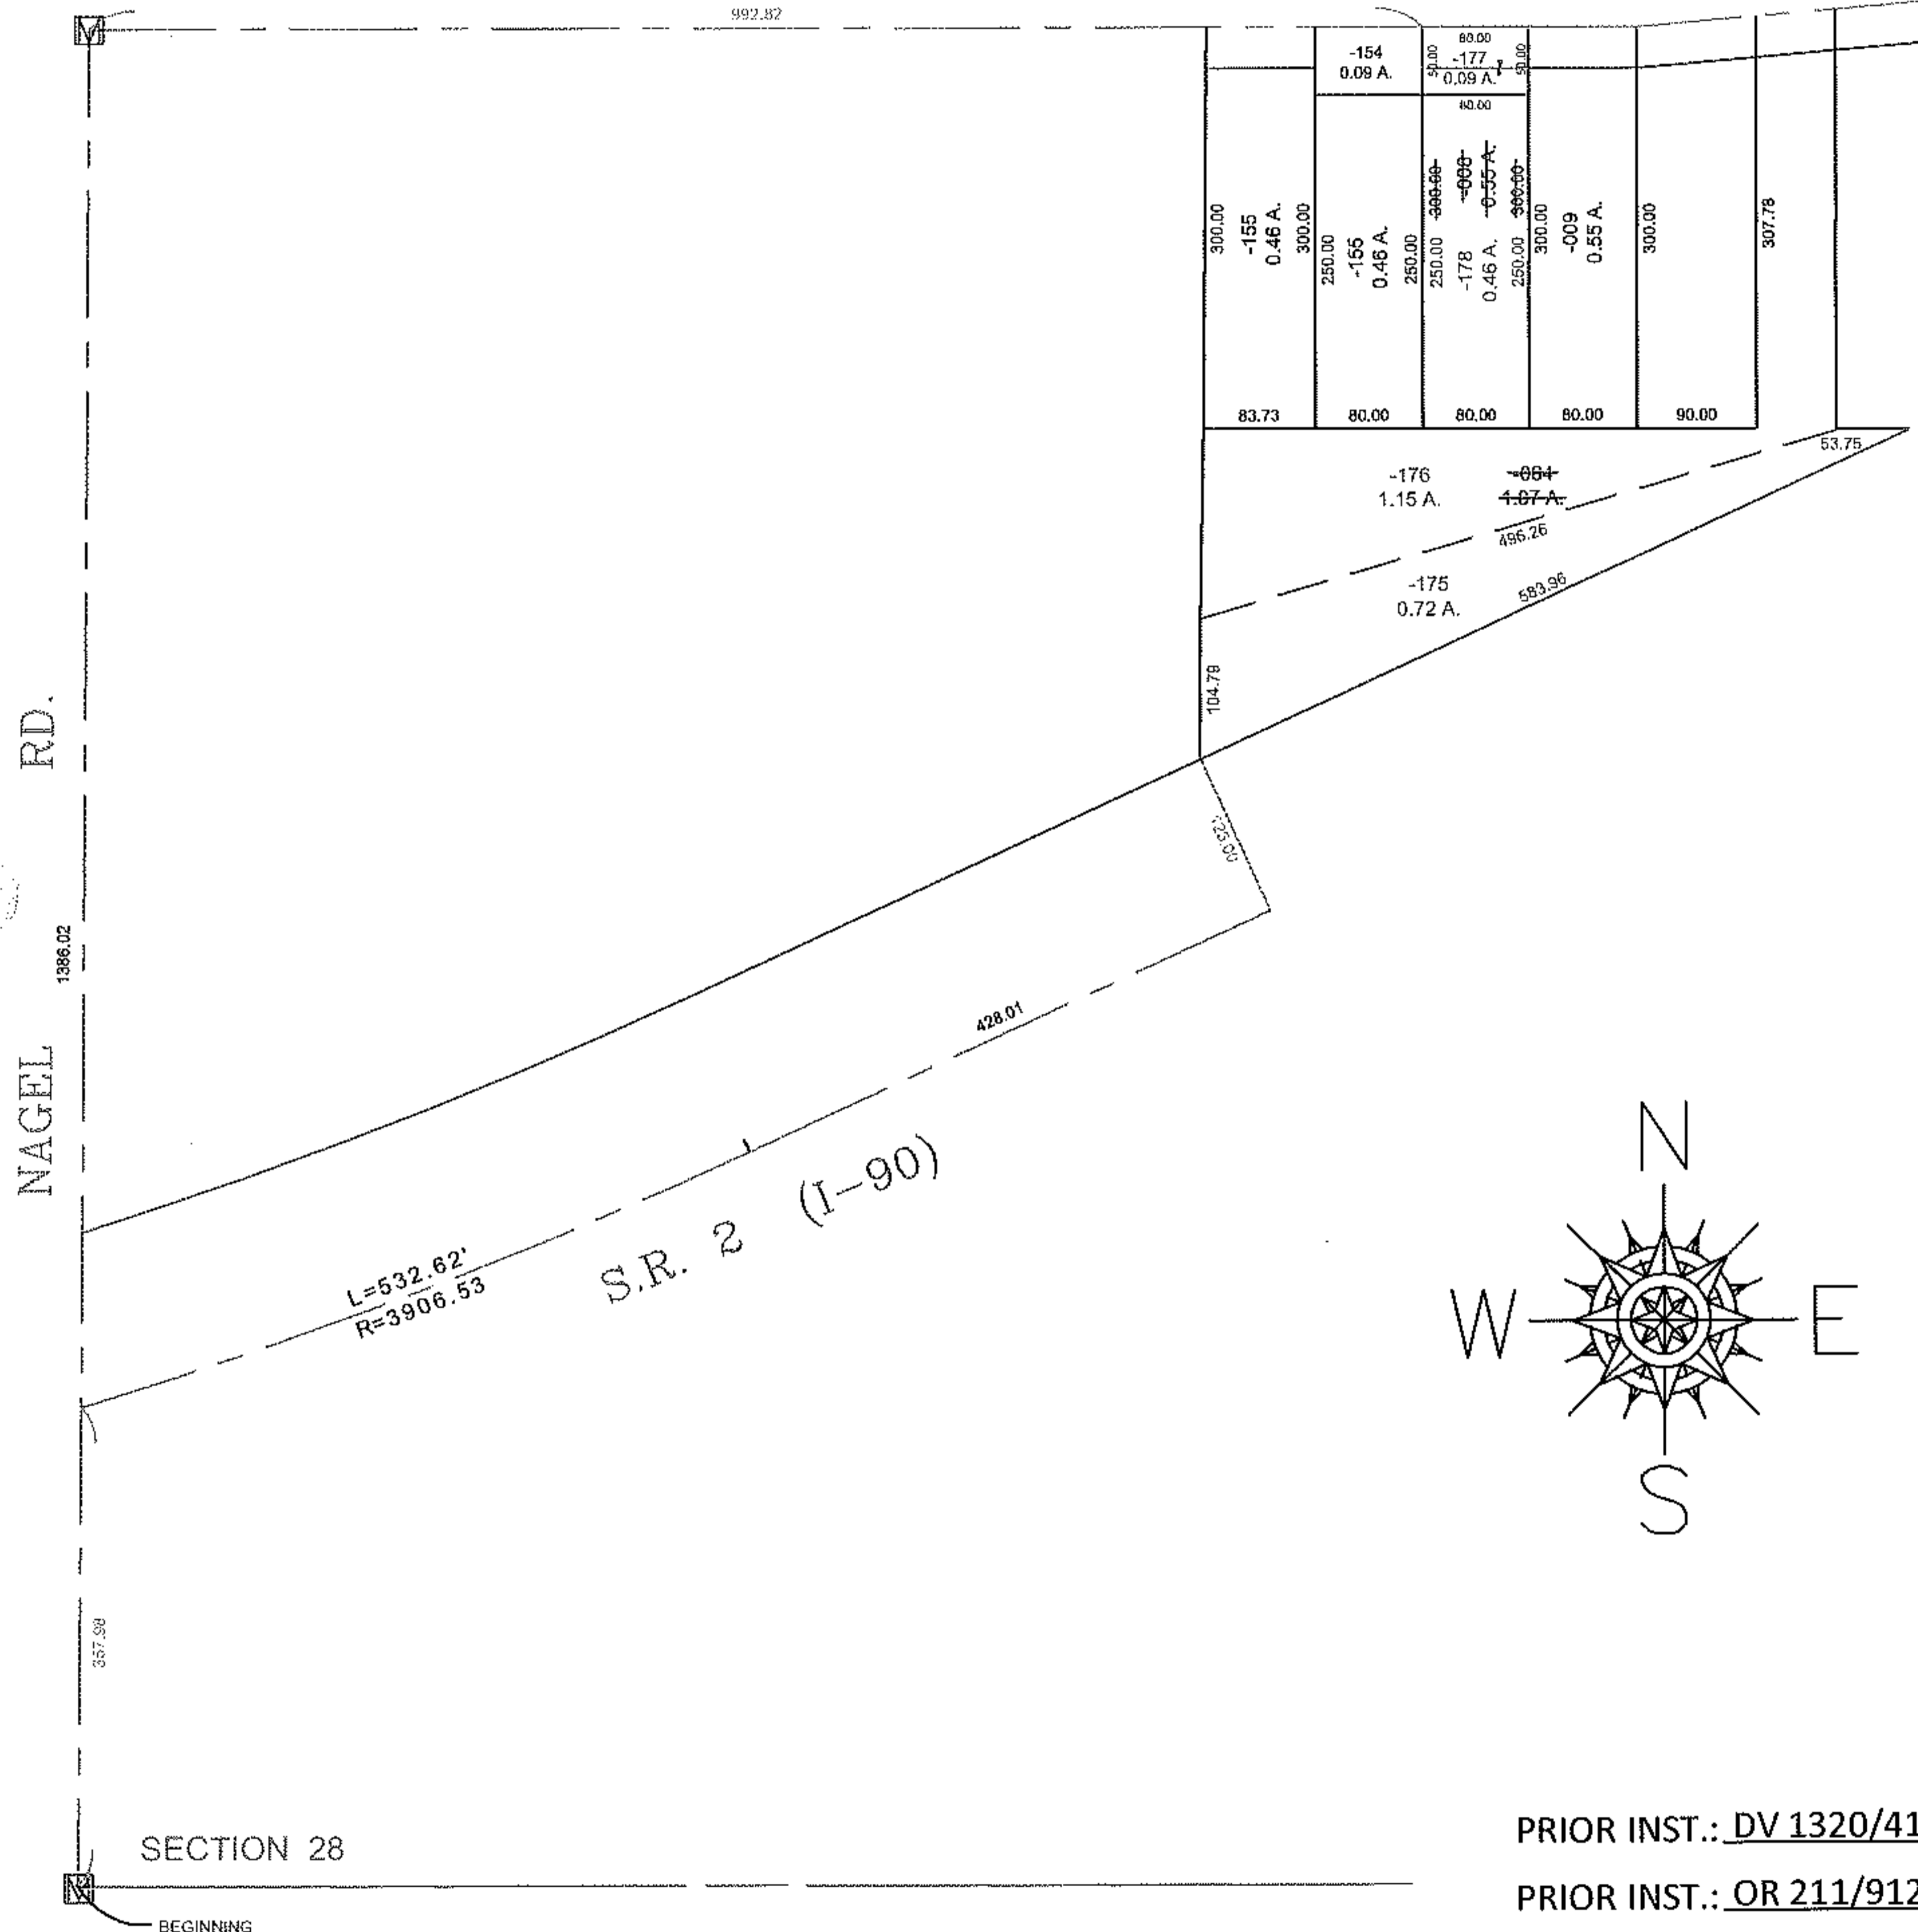

PRIOR INST.: DV 1320/419  
 PRIOR INST.: OR 211/912

**SPLITS/DEEDS PROCESSED**

LORAIN COUNTY TAX MAP DEPARTMENT  
 226 MIDDLE AVE. ELYRIA, OHIO

SURVEYED BY: WILLIAM J. SALA  
 CLOSURE: 0.01 : 10,000  
 MAP PAGE(S): 04-00-028-E  
 APPROVED BY: TJS DATE: 9/19/11  
 SCALE: 1" = 200