


PARENT PARCEL: 04-00-028-102-006

CHILD PARCEL: 04-00-028-102-179 THRU -180

STARTING POINT: MONUMENT, S.W. CORNER OF SECTION 28

11-00242

JUST IMAGINE DR.

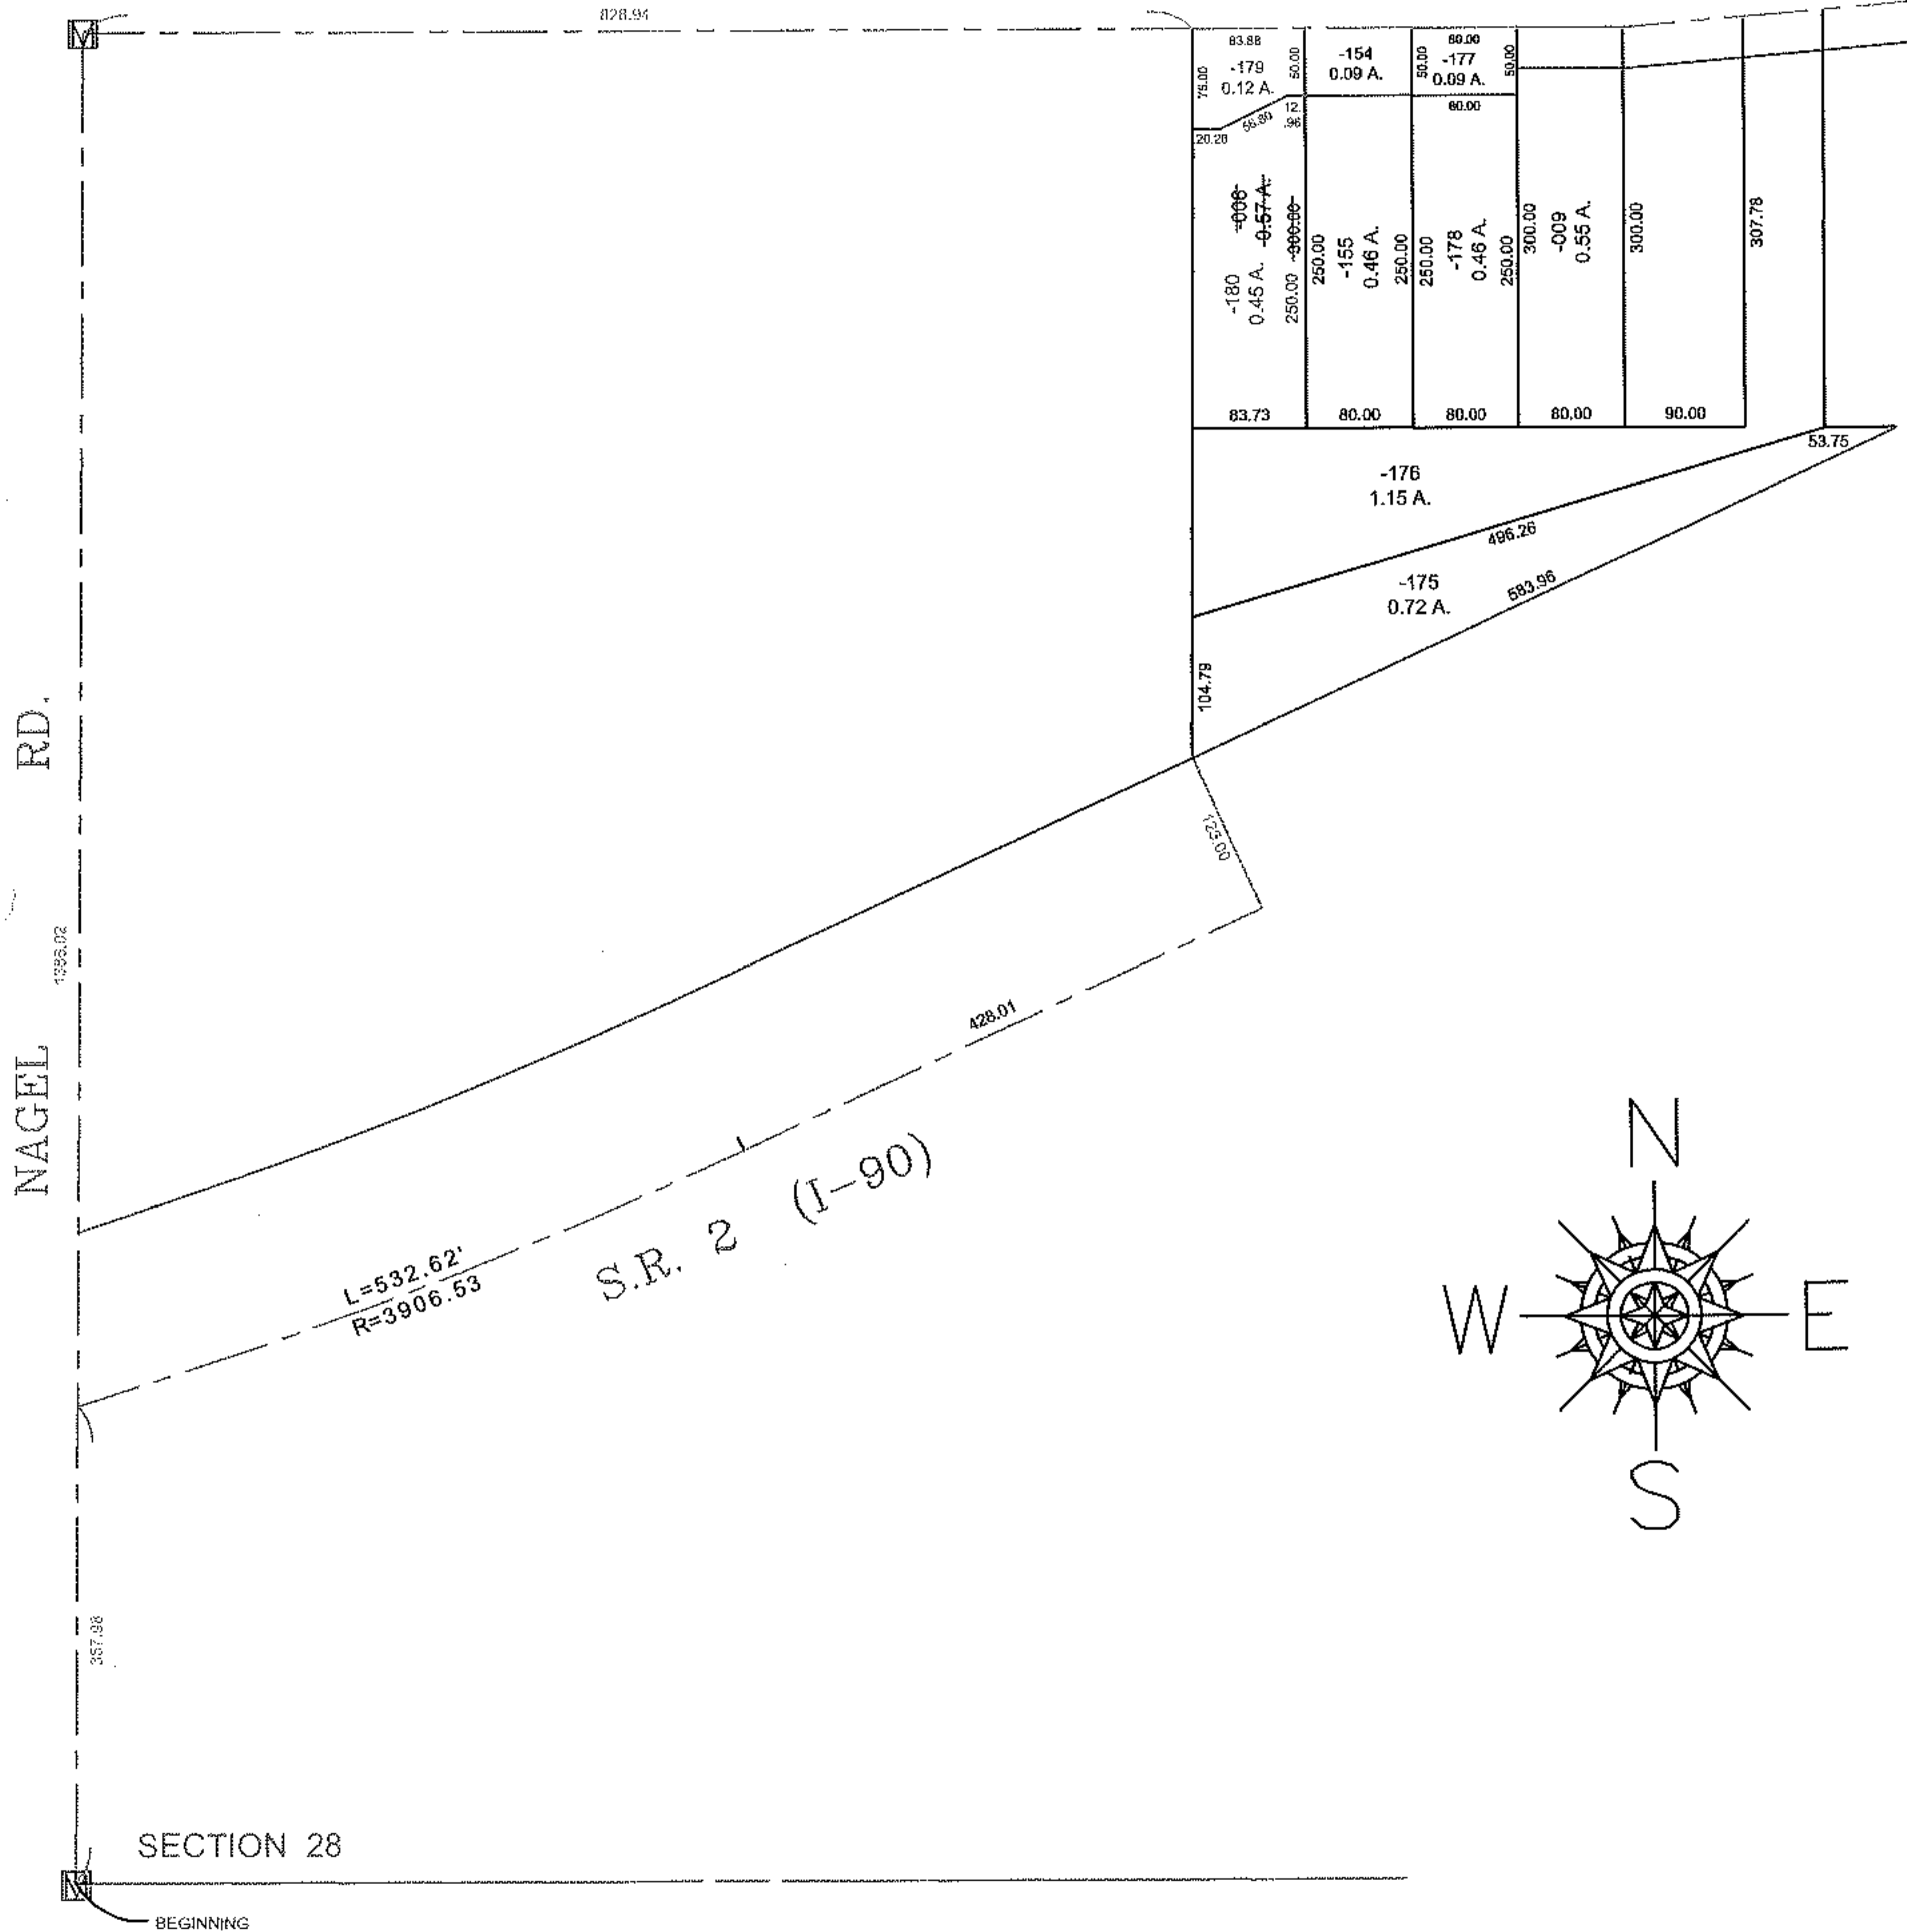

SPLITS/DEEDS PROCESSED

LORAIN COUNTY TAX MAP DEPARTMENT  
226 MIDDLE AVE. ELYRIA, OHIO

SURVEYED BY: WILLIAM J. SALA

CLOSURE: 0.01 : 10,000

MAP PAGE(S): 04-00-028-E

APPROVED BY: TJS DATE: 9/28/11

SCALE: 1" = 200 PRIOR INST.: DV 1420/434